

Plat of Survey


of

Lots 9, 10, & 11 in Block 61 of Interlaken,

a subdivision located in the Northeast 1/4 of Section 11, Town 3 North, Range 16 East, Town of Sugar Creek, Walworth County, Wisconsin.

Surveyed for: **Keefe Real Estate, Inc.**

751 Geneva Parkway
Lake Geneva, Wisconsin. 53147

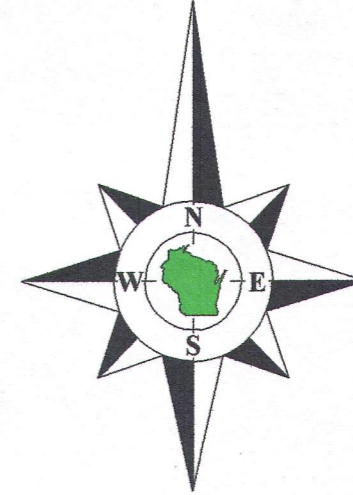

Bearings reference to the plat of Interlaken Subdivision.

Bird Road
(50' Wide)

Queens Road
(50' Wide)

Lot 11

Tax Parcel GI 00558
0.304 Acre
13,260 Sq.Ft.

Lot 10

House N6791


Lot 9

Lot 8

Lot 12

Block 61

Lot 7

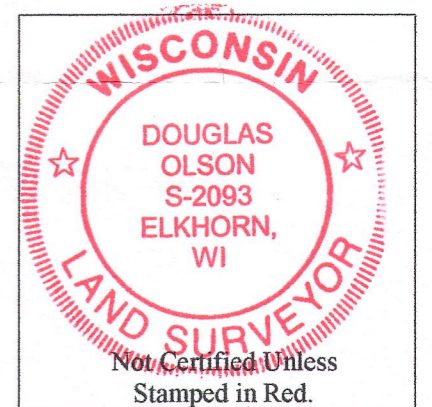

Notes:


- 1) This survey plat is not certified unless signed and sealed in red ink.
- 2) This survey is subject to Wisconsin lien laws. This Plat of Survey is the notice of intent to file lien. Lien waiver required.

Copyright 2015 by Olson Land Surveying, LLC.

All rights reserved. No part of this survey plat may be reproduced or transmitted in any form by any means - graphic, electronic, or mechanical, including photocopying, tracing, or information storage and retrieval systems - without permission in writing from Douglas G. Olson, Olson Land Surveying, LLC.

I hereby certify that I have surveyed the above described property and the map hereon is correct to the best of my professional knowledge and belief and shows the size and location of the property, its exterior boundaries, the location and dimensions of all visible structures thereon, boundary fences, apparent easements and roadways and visible encroachments, if any.

This survey is made for the exclusive use of the present owners of the property, and also those who purchase, mortgage or guarantee title thereto, within one year from the date hereof.

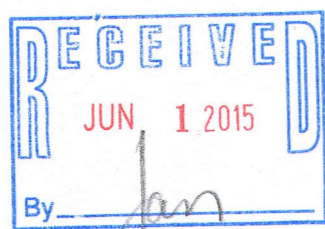

Douglas G. Olson
Wisconsin Professional Land Surveyor - 2093

2015.031

Sheet 1 of 1 Sheets

Drawing Name:

Job Reference Number

2015.031

Legend

- Found Concrete Monument
- Found Iron Pipe
- Recorded Information
- Utility Pedestal
- Concrete Cover
- Septic Vent
- Asphalt Surface
- Gravel




Olson Land Surveying, LLC

45 South Wisconsin Street * P.O. Box 322 * Elkhorn, Wisconsin. 53121

Telephone: (262) 723-3434 * Facsimile: (262) 723-8044

Email: doug@olsonsurveying.com

Scale in Feet
1" = 20'

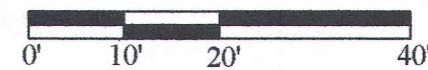

Survey Date: May 6, 2015.

Revisions:

GI-558

316-2214