


Plat of Survey

of



Lots 1, 2 and 3 in Block 64 of
the Fifth Map of Interlaken,

a subdivision located in the Northwest 1/4 of Section 14, Town 3 North,
Range 16 East, Town of Sugar Creek, Walworth County, Wisconsin.

Surveyed for: **Dale Blakeslee**
W5646 Lake Shore Drive
Elkhorn, Wisconsin. 53121

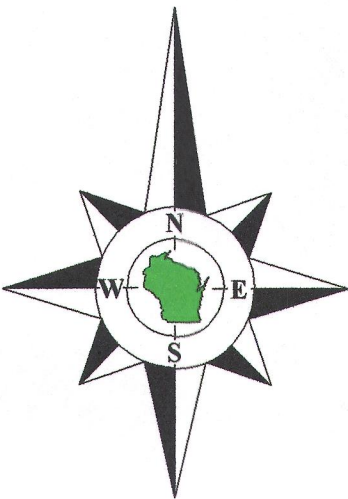

Bearings reference to the plat of
the Fifth Map of Interlaken.

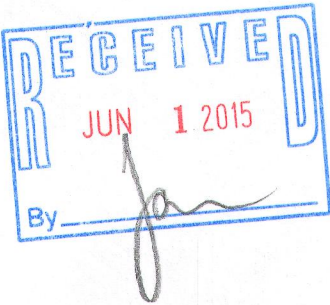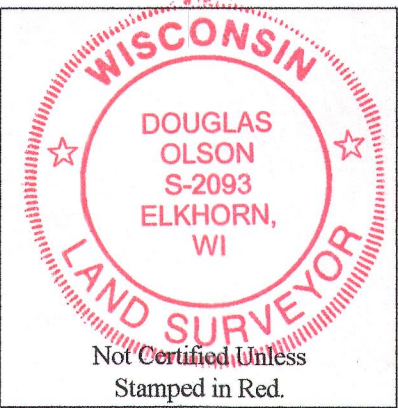

Notes:

- 1) This survey plat is not certified unless signed and sealed in red ink.
- 2) This survey is subject to Wisconsin lien laws. This Plat of Survey is the notice of intent to file lien. Lien waiver required.

Copyright 2014 by Jensen & Olson Land Surveying, LLC.


All rights reserved. No part of this survey plat may be reproduced or transmitted in any form by any means - graphic, electronic, or mechanical, including photocopying, tracing, or information storage and retrieval systems - without permission in writing from Douglas G. Olson, Jensen & Olson Land Surveying, LLC.

I hereby certify that I have surveyed the above described property and the map hereon is correct to the best of my professional knowledge and belief and shows the size and location of the property, its exterior boundaries, the location and dimensions of all visible structures thereon, boundary fences, apparent easements and roadways and visible encroachments, if any.

This survey is made for the exclusive use of the present owners of the property, and also those who purchase, mortgage or guarantee title thereto, within one year from the date hereof.


Douglas G. Olson
Wisconsin Registered Land Surveyor - 2093

Tax Parcel
GSC 1100002

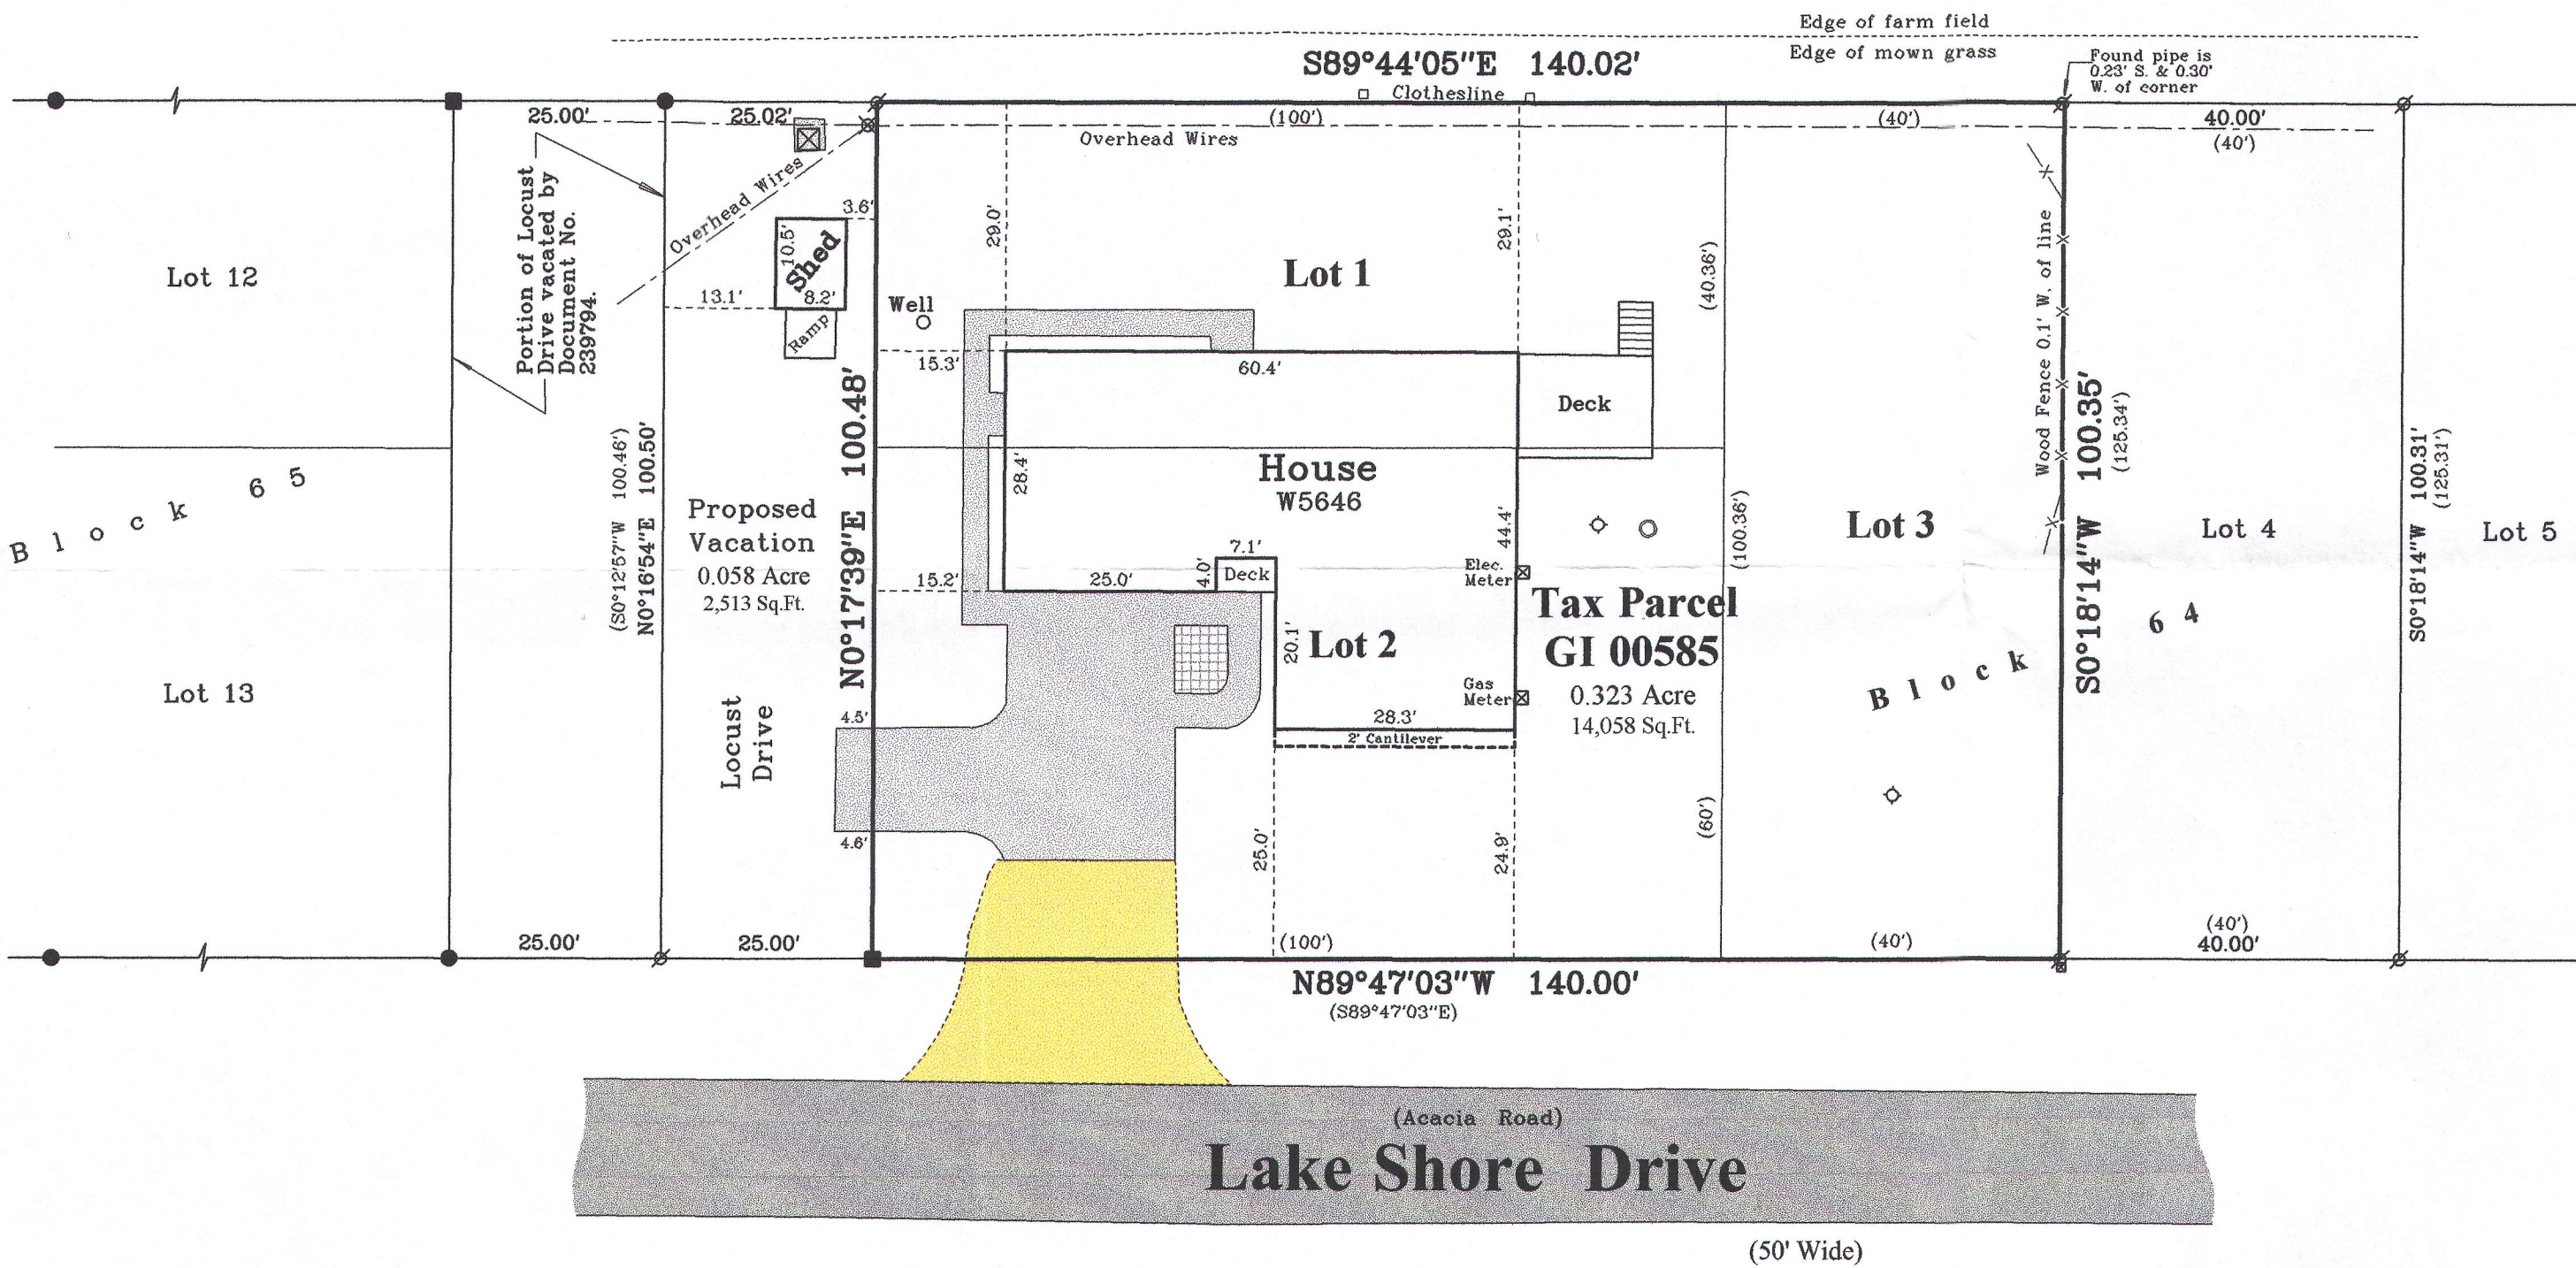

Survey Date: September 8, 2014.

Revisions:

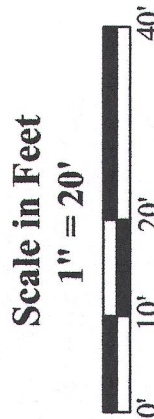

Jensen & Olson Land Surveying, LLC

45 South Wisconsin Street * P.O. Box 322 * Elkhorn, Wisconsin. 53121
Telephone: (262) 723-3434 * Facsimile: (262) 723-8044
Email: jensen.olson@elknet.net

Legend	
Found Concrete Monument	Recorded Information
Found Iron Pipe	Utility Pole
Found Septic Vent	Concrete Box or Pedestal
Asphalt Surface	Gravel
Concrete Surface	Brick

Sheet 1 of 1 Sheets

Job Reference Number

2014.097

2014.097

GI -585

316-2217