
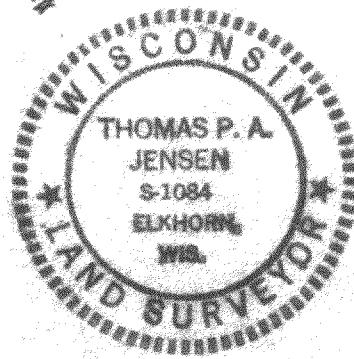


PLAT OF SURVEY  
OF

LOTS 30, 31, 32, 33, BLK 20, OF THE 2ND MAP OF  
INTERLAKEN SUBDIVISION, LOCATED IN THE SET OF  
SECTION 11, T3N R16E, WALWORTH COUNTY, WIS.

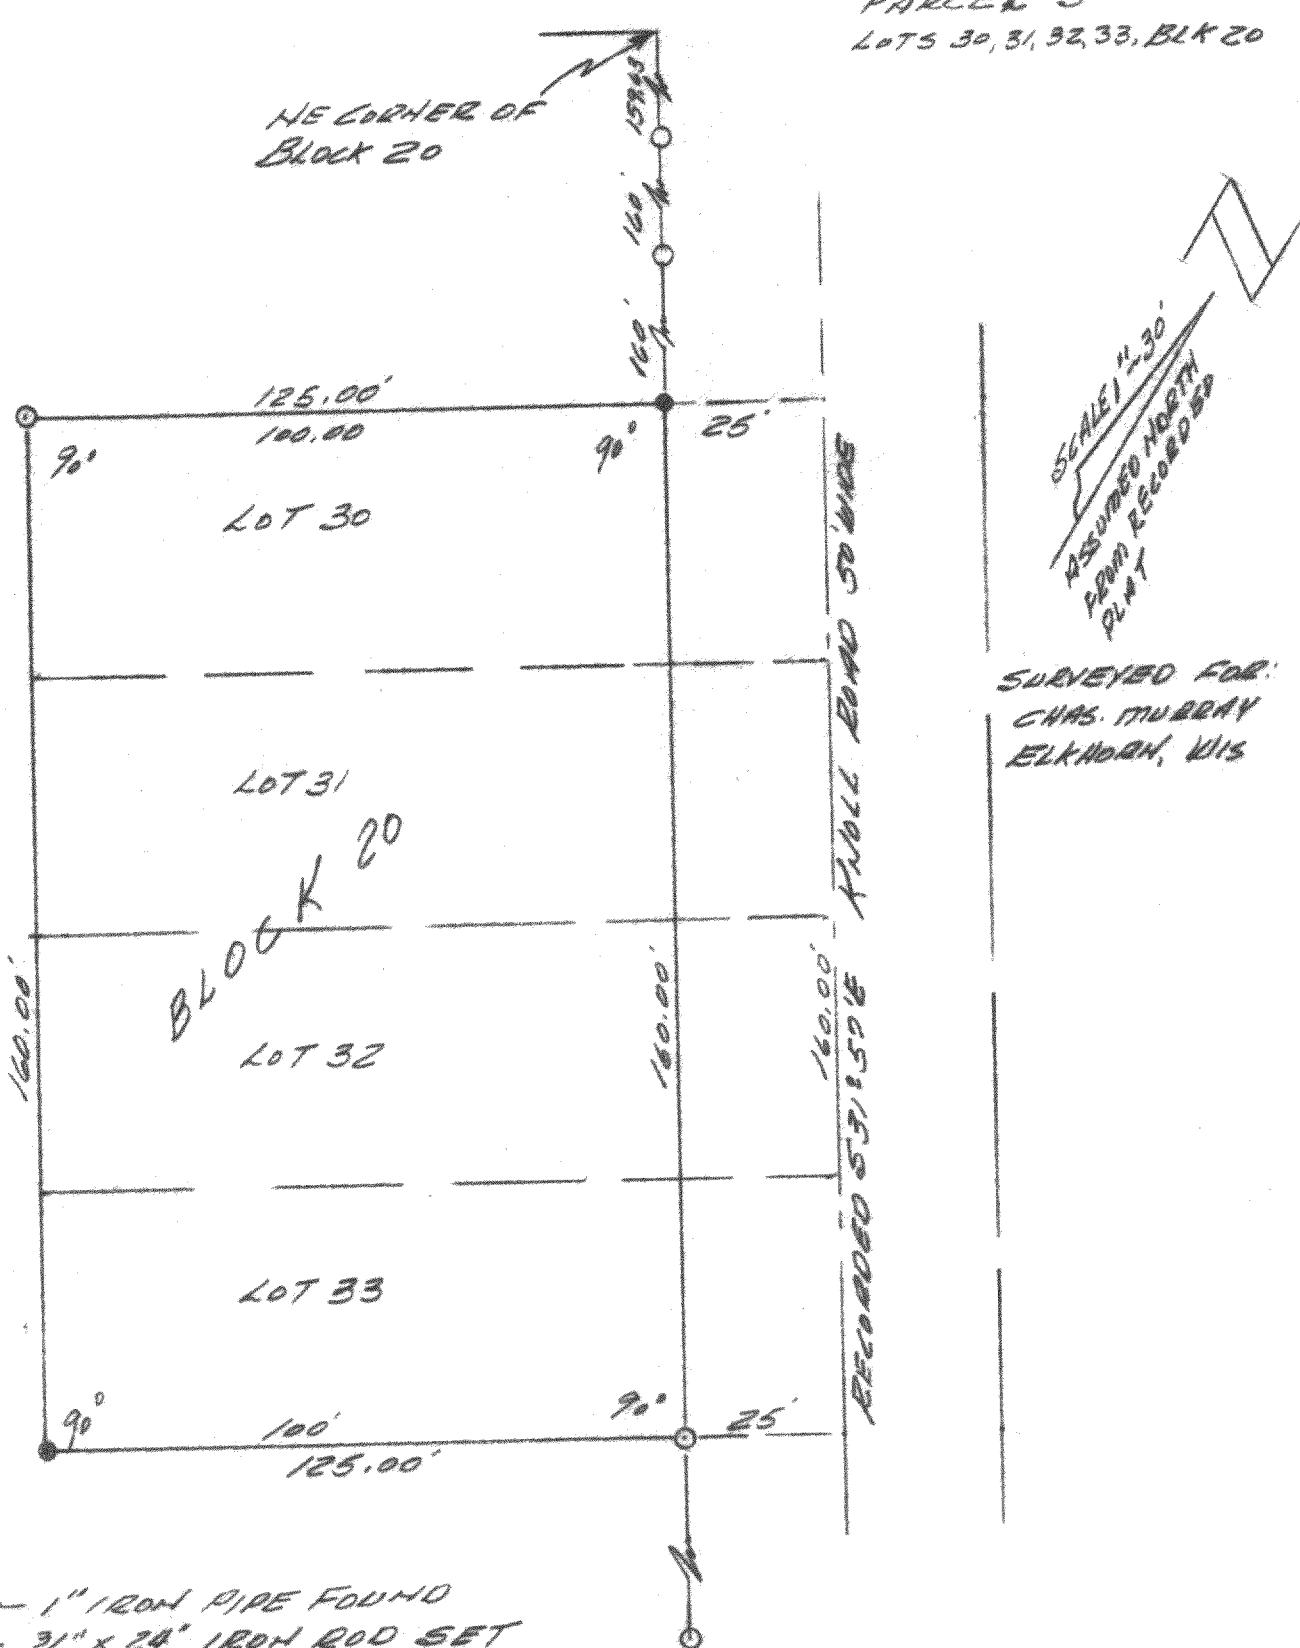

I CERTIFY THAT I SURVEYED THE ABOVE  
DESCRIBED PROPERTY, & THAT THE PLAT  
SHOWN HEREON IS AN ACCURATE SURVEY &  
A TRUE REPRESENTATION THEREOF & CORRECTLY  
SHOWS THE EXTERIOR BOUNDARY LINES & ALL  
DIVISIONS OF SAID PROPERTY.

APRIL 6, 1977

*Thomas P.A. Jensen*  
THOMAS P.A. JENSEN, R.L.S. #1084  
JENSEN SURVEYING & MAPPING  
ELKHORN, WIS. 316-223

61-257A