
PREPARED FOR CHRISTINE FOX SHOREWEST REALTY 830 E GENEVA ST DELAVAN, WI 53115

PLAT OF SURVEY

- OF -

LOTS 24 AND 25, BLOCK 4 LAKE WANDAWEGA HIGHLANDS, A SUBDIVISION LOCATED IN SECTIONS 11 AND 12, TOWN 3 NORTH, RANGE 16 EAST OF THE FOURTH PRINCIPAL MERIDIAN, TOWN OF SUGAR CREEK, COUNTY OF WALWORTH AND STATE OF WISCONSIN

PATHFINDER SURVEYING INC. (formerly) J.K. SURVEYING INC. W2888 KRUEGER RD. STE. "D" 262-248-8303

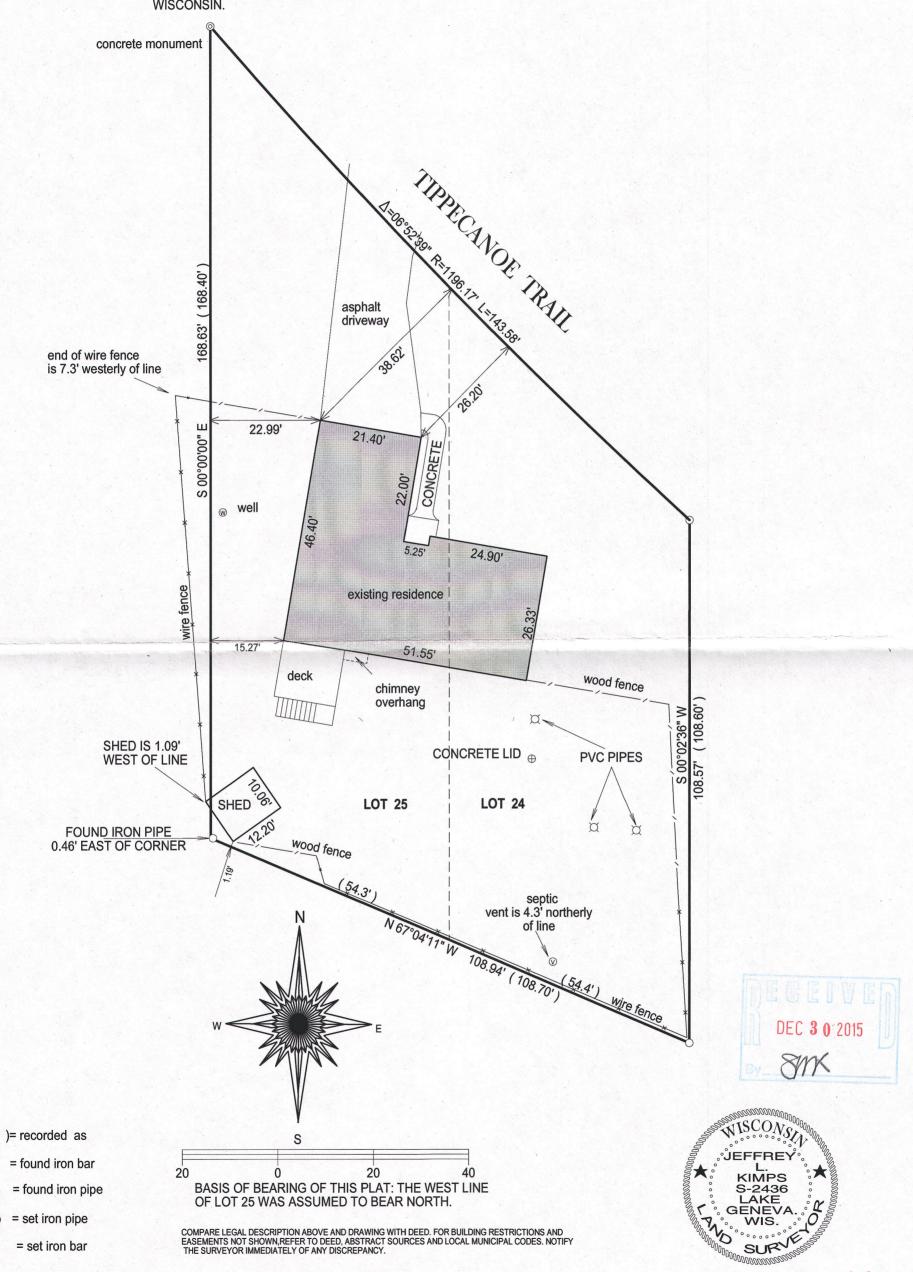

TAX ID # GWH 00059

SCALE 1" = 20'

JOB # 09-078ud

DATED THIS 31st day of October, 2015.

the date hereof.

"I hereby certify that I have surveyed the above described property and that

This survey is made for the present owners of the property, and those who

purchase, mortgage, or guarantee the title thereto, within one year from

the above map is a true representation thereof and shows the size and location of all visible structures, apparent easements and encroachments

22.11

(original if signed in red)

JEFFREY KIMPS S - 2436

Wisconsin Registered Land Surveyor