


Plat of Survey

of


The Northwestern 1/2 of Lot 23 and all of Lots 24 & 25, all in Block 60 of Interlaken,

a subdivision located in the Northeast 1/4 of Section 11, Town 3 North,
Range 16 East, Town of Sugar Creek, Walworth County, Wisconsin.

Surveyed for: **Sandra Smith**
N6823 University Road
Elkhorn, Wisconsin. 53121

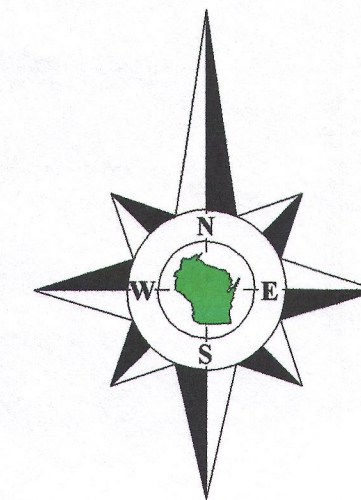


Bearings reference to the plat
of Interlaken Subdivision.

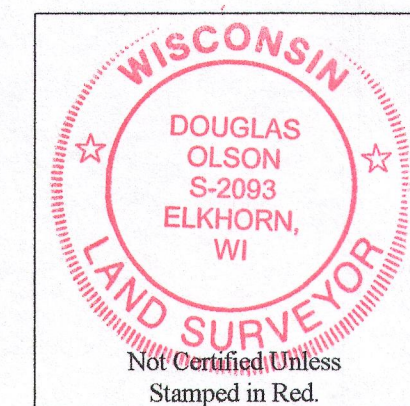

Notes:

- 1) This survey plat is not certified unless signed and sealed in red ink.
- 2) This survey is subject to Wisconsin lien laws. This Plat of Survey is the notice of intent to file lien. Lien waiver required.

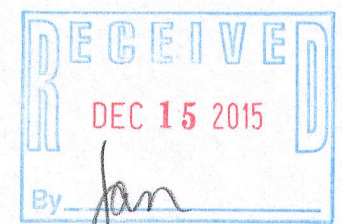


Copyright 2015 by Olson Land Surveying, LLC.

All rights reserved. No part of this survey plat may be reproduced or transmitted in any form by any means - graphic, electronic, or mechanical, including photocopying, tracing, or information storage and retrieval systems - without permission in writing from Douglas G. Olson, Olson Land Surveying, LLC.

I, Douglas G. Olson, Wisconsin Professional Land Surveyor, do hereby certify that this survey was performed by me, or under my direction in full compliance with the owner's/agent's instructions and Chapter A-E 7 of the Wisconsin Administrative Code "Minimum Standards for Property Surveys"; and that this map is an accurate representation thereof to the best of my knowledge and belief.

Douglas G. Olson
Wisconsin Professional Land Surveyor - 2093

Survey Date: July 22, 2015.
Revisions: No. 1 - Garage Slab

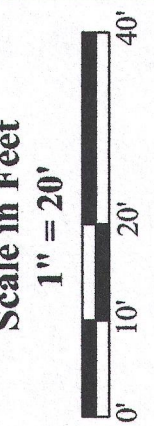

Olson Land Surveying, LLC



45 South Wisconsin Street * P.O. Box 322 * Elkhorn, Wisconsin. 53121
Telephone: (262) 723-3434 * Facsimile: (262) 723-8044
Email: doug@olsonsurveying.com

Legend

- Found Concrete Monument
- Found Iron Pipe, 1" dia.
- Found Iron Rod, 1/2" x 16"
- Found Iron Stake, 1/2" x 16"
- Recorded Information
- Utility Pole
- Concrete Corner
- Septic Vent
- Concrete Surface
- Gravel

Sheet 1 of 1 Sheets
Drawing Name:
Job Reference Number
2015.065

2015.065

G±-546

316-2247