PREPARED FOR JERRY KROUPA KEEFE REAL ESTATE ELKHORN WI.


## PLAT OF SURVEY

LOT 32 SYLVAN TRACE SUBDIVISION, LOCATED IN THE SW 1/4 AND SE 1/4 OF THE NEW 1/4 AND THE NE 1/4 AND THE SE 1/4 AND NW 1/4 OF THE SW 1/4 OF SECTION 2, TOWN 3 NORTH, RANGE 16 EAST, TOWN OF SUGAR CREEK, COUNTY OF WALWORTH AND STATE OF WISCONSIN.

(S 00°22'40" W

40

PATHFINDER SURVEYING INC. (formerly) J.K. SURVEYINĞ INC. P.O BOX 322 LAKE GENEVA, WI. 53147 WWW.PATHFINDERSURVEYING.NET 262-248-8303

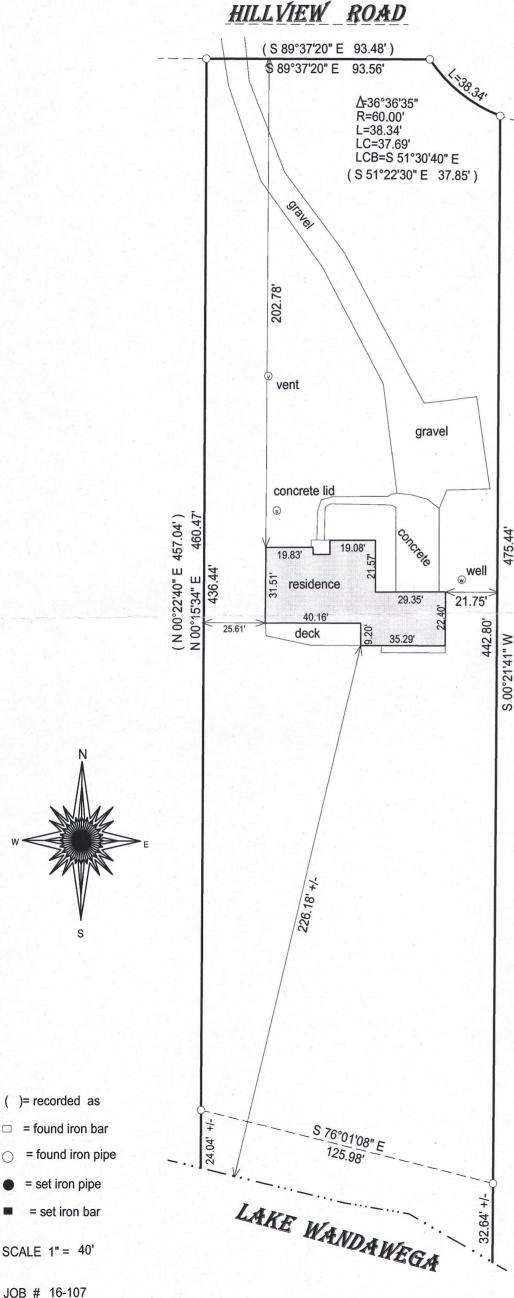

SEP 20 2016 SUR! JEFFREY L KIMPS 8 - 2436 Wisconsin Professional Land Surveyor ( original if signed in red ) 40

BASIS OF BEARING OF THIS PLAT: THE SUBDIVISION PLAT OF RECORD.

I hereby certify that I have surveyed the above- described property and the above map is a is a true representation thereof and shows the size and location of the property, its exterior boundaries, the location and dimensions of all structures thereon, fences, apparant easements and roadways and visible encroachments if any.

This survey is made for the present owners of the property, and those who purchase, mortgage, or guarantee the title thereto, within one year from the date hereof.

DATED THIS 25th day of April, 2016.

JOB # 16-107

TAX ID # GST00032