

FARRIS, HANSEN & ASSOCIATES, INC.

ENGINEERING — ARCHITECTURE — SURVEYING
7 RIDGWAY COURT — P.O. BOX 437 — ELKHORN, WISCONSIN 53121
PHONE: (262) 723-2098 FAX: (262) 723-5886





— WORK ORDERED BY —
CZAR BUILDERS
W5154 STEWART DRIVE
ELKHORN, WI. 53121

PLAT OF SURVEY

LOT 14 OF BAYWOOD ESTATES
LOCATED IN THE SW 1/4 SEC. 36
TOWN 4 NORTH, RANGE 16 EAST &
THE NW 1/4 SEC. 1 & NE 1/4 SEC. 2
TOWN 2 NORTH, RANGE 16 EAST
WALWORTH COUNTY, WISCONSIN

ASSIGNED SW LINE LOT 14
N 17°15'00" W

LAUDERDALE LAKE
100' +/- ALONG THE SHORE

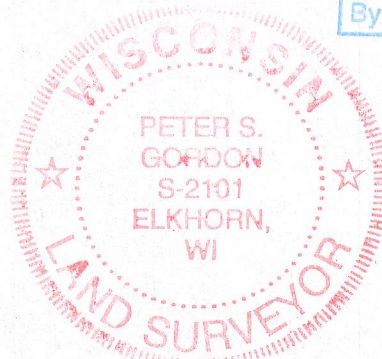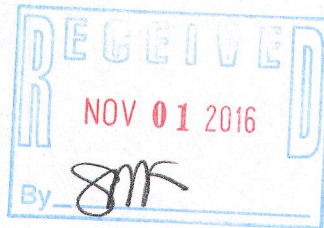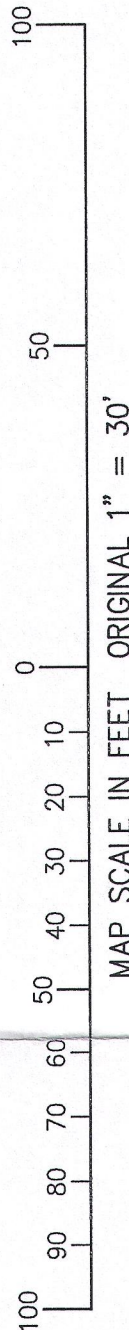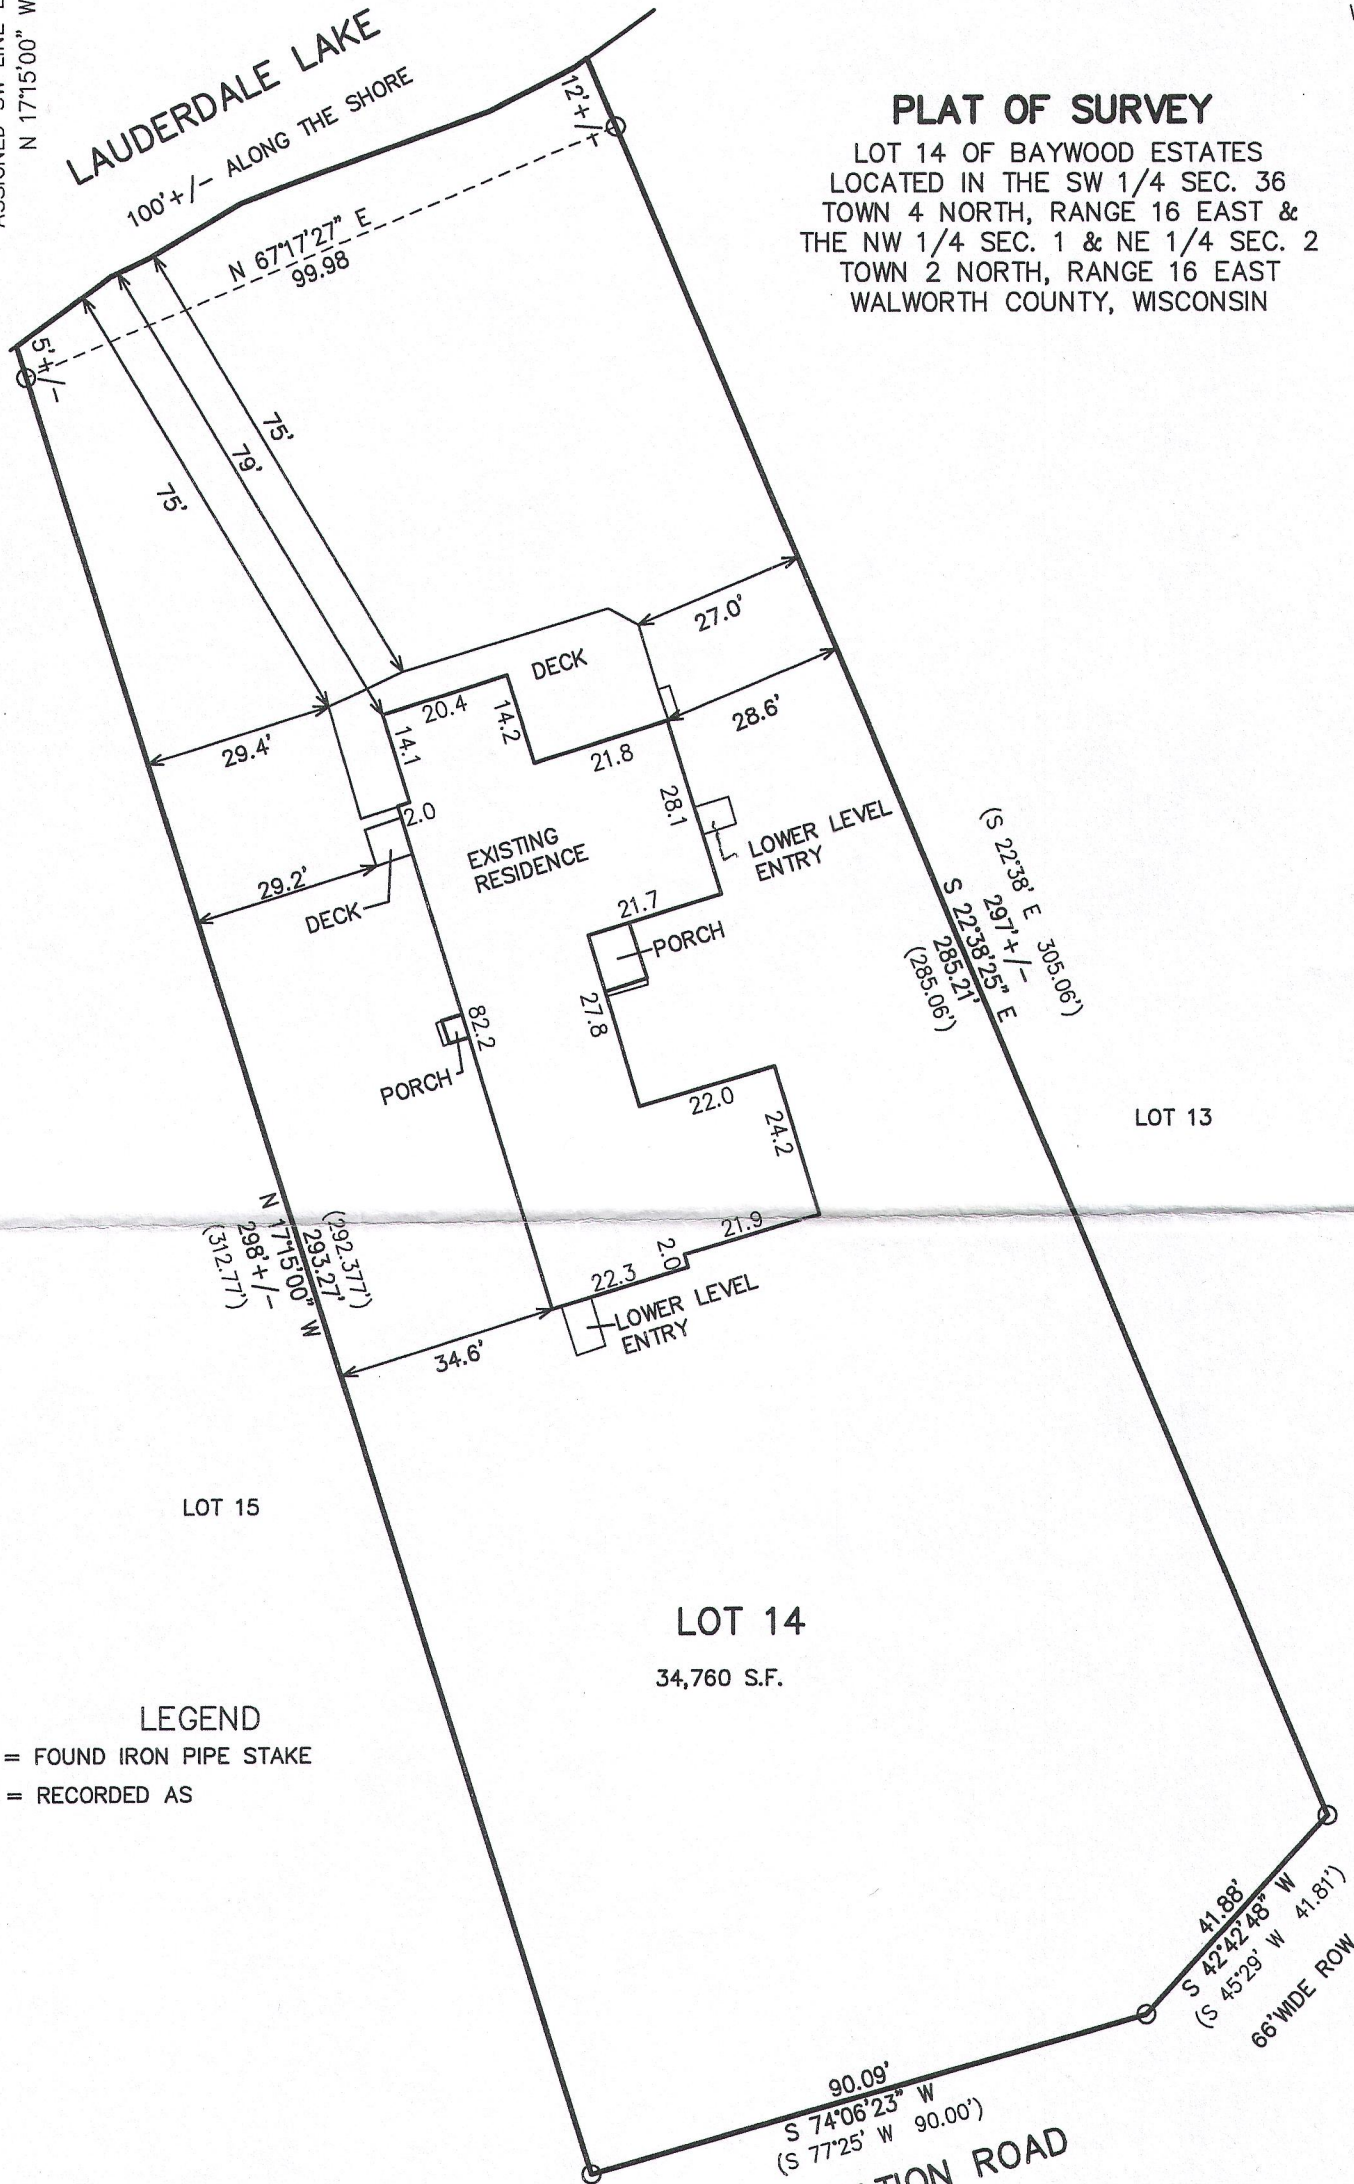

GBE-14
AUG 12 2016

316-2272