
PLAT OF SURVEY

LOTS 4, 5 AND 6, BLOCK 48, ON A MAP ENTITLED "FOURTH MAP OF INTERLAKEN, TOWN OF SUGAR CREEK, WALWORTH COUNTY, WISCONSIN" AND RECORDED IN THE OFFICE OF THE REGISTER OF DEEDS FOR SAID COUNTY ON THE 20TH DAY OF JUNE, 1929 IN VOLUME 11, PAGES 6 AND 7.

SURVEY FOR: RENAE DUNBAR OF CENTURY 21 AFFILIATED

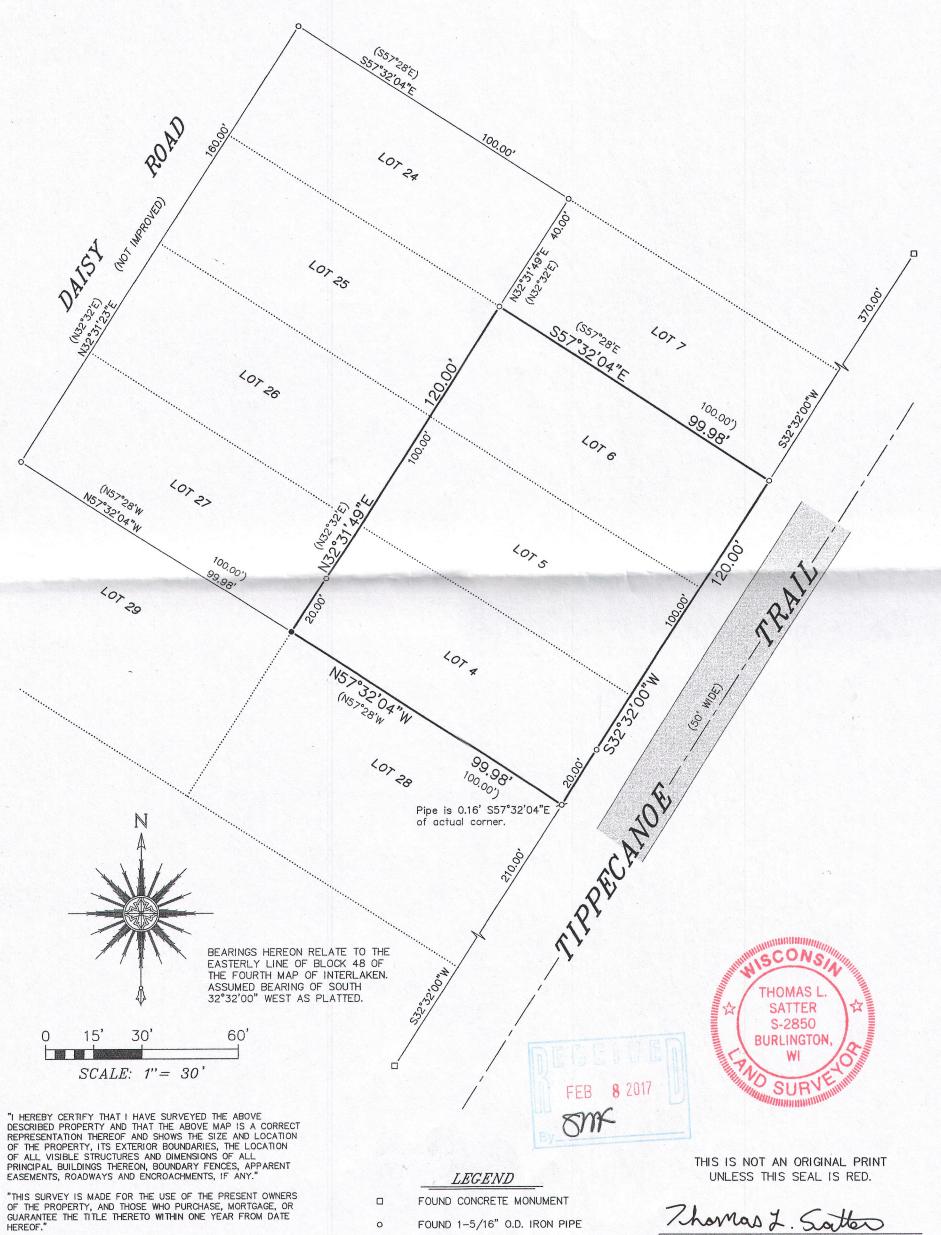

SATTER SURVEYING, LLC LAND SURVEYS, MAPPING AND PLANNING

272 ORIGEN STREET BURLINGTON, WI 53105 262-661-4239

FOUND 1" O.D. IRON PIPE Ø

SET 1-5/16" O.D. IRON PIPE

RECORDED AS ()

THOMAS L. SATTER

S-2850

FEBRUARY 1, 2017 DATE

011705d1 JOB NUMBER