



Evergreen Lane

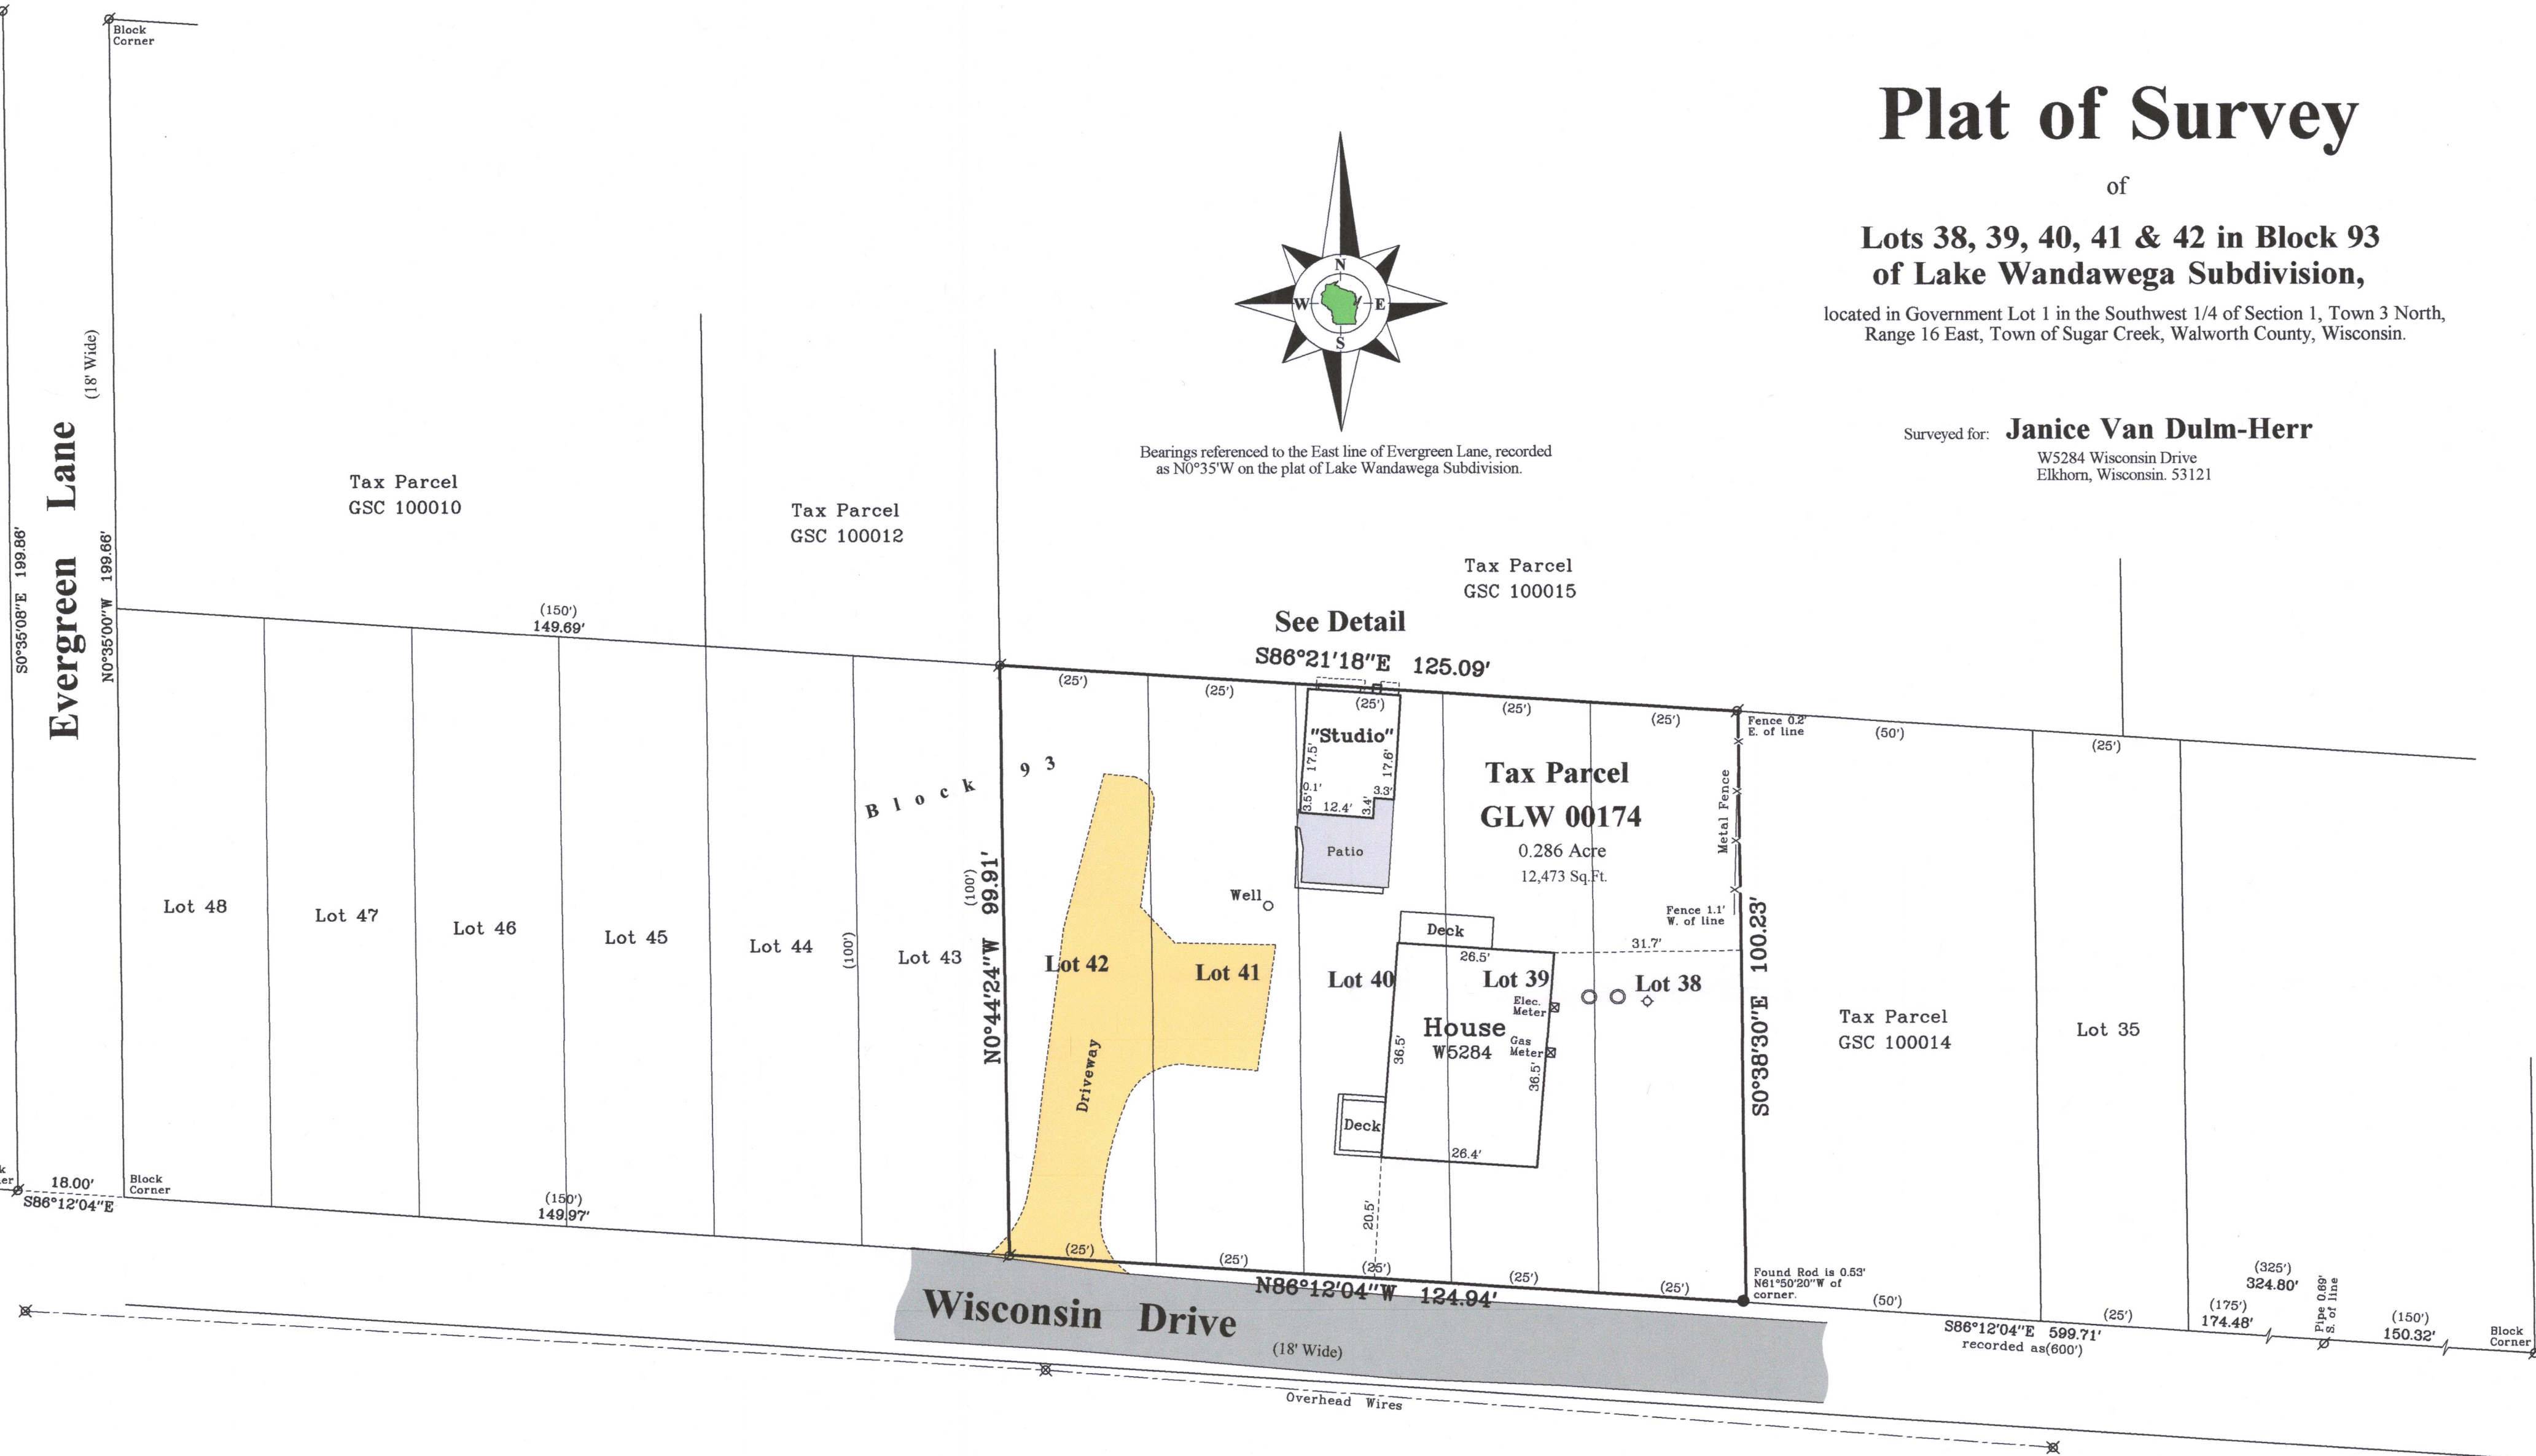

Detail
1" = 5'

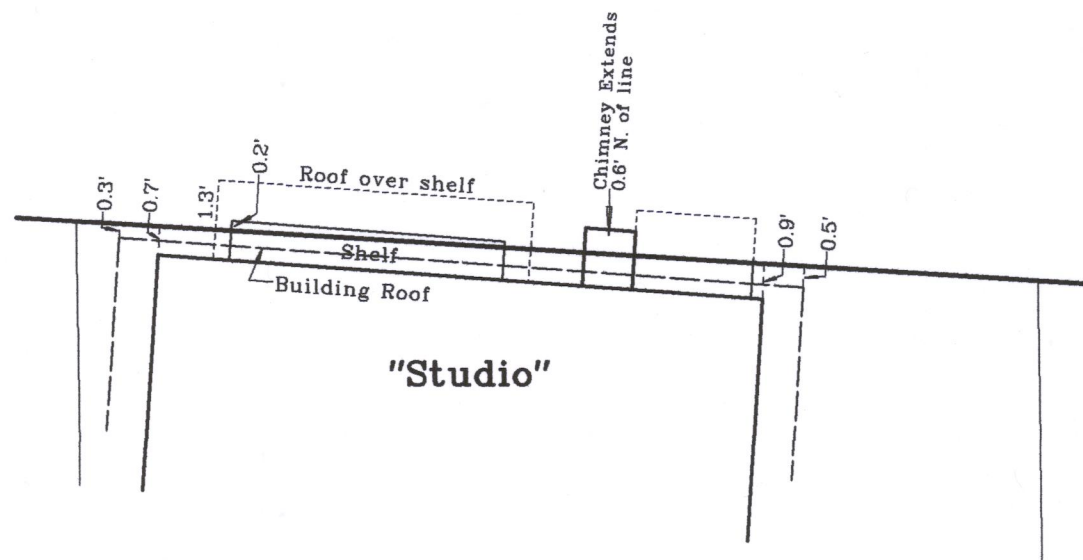

Notes:

- 1) This Plat of Survey is not certified unless signed and sealed in red ink.
- 2) This survey is subject to Wisconsin lien laws. This Plat of Survey is the notice of intent to file lien. Lien waiver required.
- 3) The Survey Date shown on this Plat of Survey is the completion date of the field work.

Copyright ©2017 by Olson Land Surveying, LLC.

All rights reserved. No part of this survey plat may be reproduced or transmitted in any form by any means - graphic, electronic, or mechanical, including photocopying, tracing, or information storage and retrieval systems - without permission in writing from Douglas G. Olson, Olson Land Surveying, LLC.

I hereby certify that I have surveyed the above described property in compliance with Chapter A-E 7 of the Wisconsin Administrative Code and that the map hereon is correct to the best of my professional knowledge and belief and shows the size and location of the property, its exterior boundaries, the location and dimensions of all visible structures thereon, boundary fences, apparent easements and roadways and visible encroachments, if any.

This survey is made for the exclusive use of the present owners of the property, and also those who purchase, mortgage or guarantee title thereto, within one year from the date hereof.

Douglas G. Olson
Wisconsin Professional Land Surveyor - 2093

GLW-174

316-2307

Plat of Survey

of


Lots 38, 39, 40, 41 & 42 in Block 93 of Lake Wandawega Subdivision,

located in Government Lot 1 in the Southwest 1/4 of Section 1, Town 3 North,
Range 16 East, Town of Sugar Creek, Walworth County, Wisconsin.

Surveyed for: **Janice Van Dulm-Herr**

W5284 Wisconsin Drive
Elkhorn, Wisconsin. 53121

Survey Date: June 6, 2017.
Revisions:

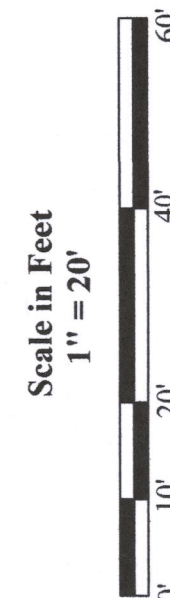

45 South Wisconsin Street | P.O. Box 322
Elkhorn, Wisconsin. 53121
Telephone: (262) 721-3434
Facsimile: (262) 721-8044
Email: doug@olsonsurveying.com
Website: www.olsonsurveying.com

OLSON
LAND SURVEYING, LLC
Rural | Residential | Commercial

Legend of Symbols & Abbreviations
Found Iron Pipe
Recorded Information
Utility Pole
Concrete Pedestal
Septic Vent Surface
Concrete Surface
Gravel Surface
N. North
S. South
E. East
W. West
In Bearings
In Degrees
In Distances
In Feet
In Inches

Sheet 1 of 1 Sheets

Drawing Name:

Job Reference Number

2017.050

2017.050