

Briarwood Road
(66' Wide)

Plat of Survey

of

Lot 52 of Sylvan Trace Subdivision,


located in Government Lot 3 in the Southwest 1/4 of Section 2, Town 3 North,
Range 16 East, Town of Sugar Creek, Walworth County, Wisconsin.

Surveyed for: **Hardyman Exteriors, L.L.C.**

2824 13th Street
Monroe, Wisconsin. 53566



Bearings referenced to the West line of Lot 52, recorded as S00°13'31"W on the plat of Sylvan Trace Subdivision.

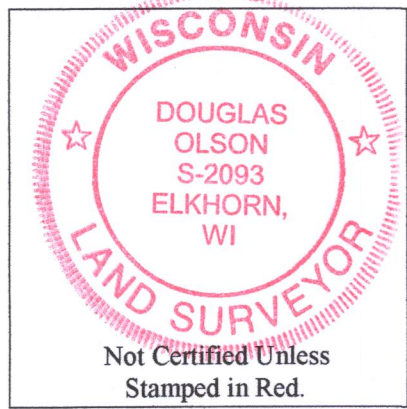

Notes:


- 1) This Plat of Survey is not certified unless signed and sealed in red ink.
- 2) This survey is subject to Wisconsin lien laws. This Plat of Survey is the notice of intent to file lien. Lien waiver required.
- 3) The Survey Date shown on this Plat of Survey is the completion date of the field work.

Copyright© 2017 by Olson Land Surveying, LLC.

All rights reserved. No part of this survey plat may be reproduced or transmitted in any form by any means - graphic, electronic, or mechanical, including photocopying, tracing, or information storage and retrieval systems - without permission in writing from Douglas G. Olson, Olson Land Surveying, LLC.

I hereby certify that I have surveyed the above described property in compliance with Chapter A-E 7 of the Wisconsin Administrative Code and that the map hereon is correct to the best of my knowledge and belief.

Douglas G. Olson
Wisconsin Professional Land Surveyor - 2093

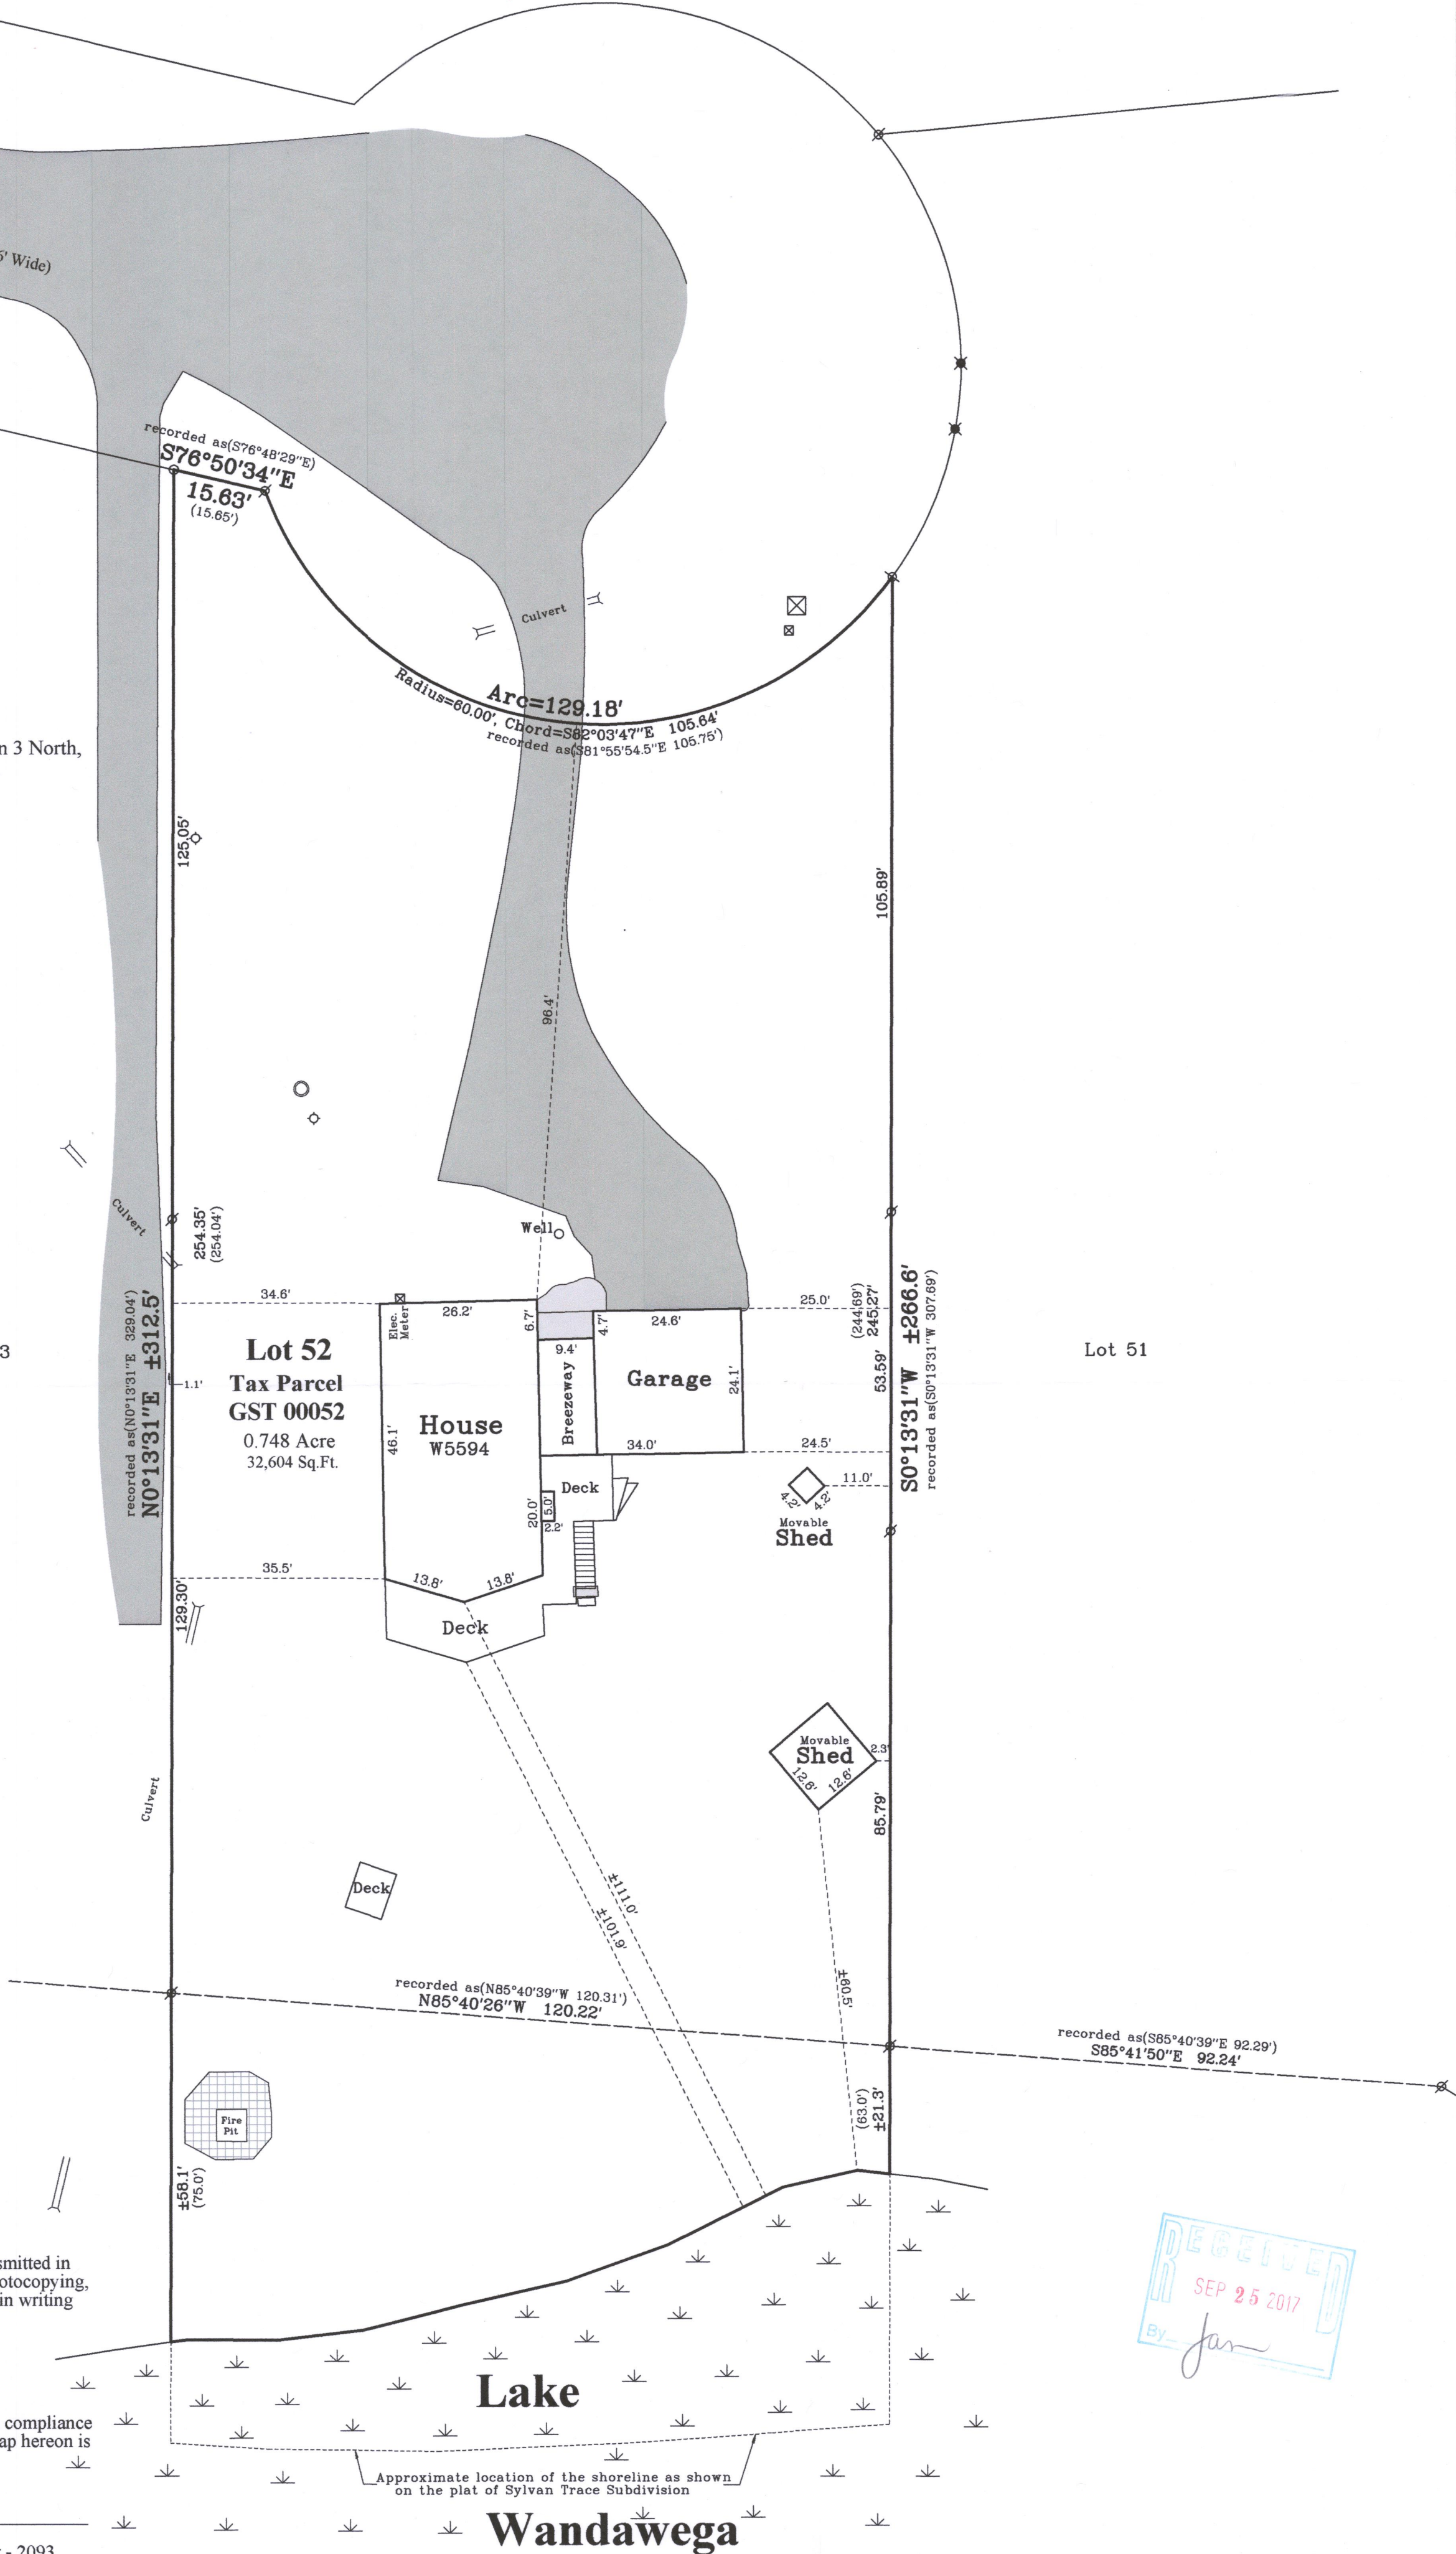

Sheet 1 of 1 Sheets

Drawing Name:

Job Reference Number
2017.036

Legend of Symbols & Abbreviations

- | | |
|-------------------------|--------------|
| Found Iron Pipe | N North |
| Found Mag Nail | S South |
| Set Iron Pipe, 1" dia. | E East |
| Recorded Information | W West |
| Utility Box or Pedestal | In Bearings |
| Concrete Cover | Degrees |
| Septic Vent | Minutes |
| Asphalt Surface | Seconds |
| Concrete Surface | In Distances |
| Brick Pavers | Feet |
| | Inches |



45 South Wisconsin Street | P.O. Box 322
Elkhorn, Wisconsin. 53121
Telephone: (262) 723-3434
Facsimile: (262) 723-8044
Email: doug@olsonsurveying.com
Website: www.olsonsurveying.com

Scale in Feet
1" = 20'



Survey Date: June 10, 2017.

Revisions:

GST-52

316-2308

2017.036