LAND-MARK SURVEYING Mark L. Miritz

Wisconsin Professional Land Surveyor S-2582


N9330 Knuteson Drive Whitewater, WI 53190 Phone: (262)495-3284 MARKMIRITZ@ LAND-MARKSURVEYING.COM

SURVE

LOTS 10 THROUGH 15, BLOCK H, NORTH LAKE BEACH TRACT NO. 1, LOCATED IN THE SOUTHWEST 1/4 OF SECTION 5, TOWN 3 NORTH,

ORDERED BY: CONNIE POGGENSEE THE RAULAND AGENCY **118 KENOSHA STREET** WALWORTH, WI 53184

BLACKTOP MAINTAINED BY TOWN SUGAR CREEK

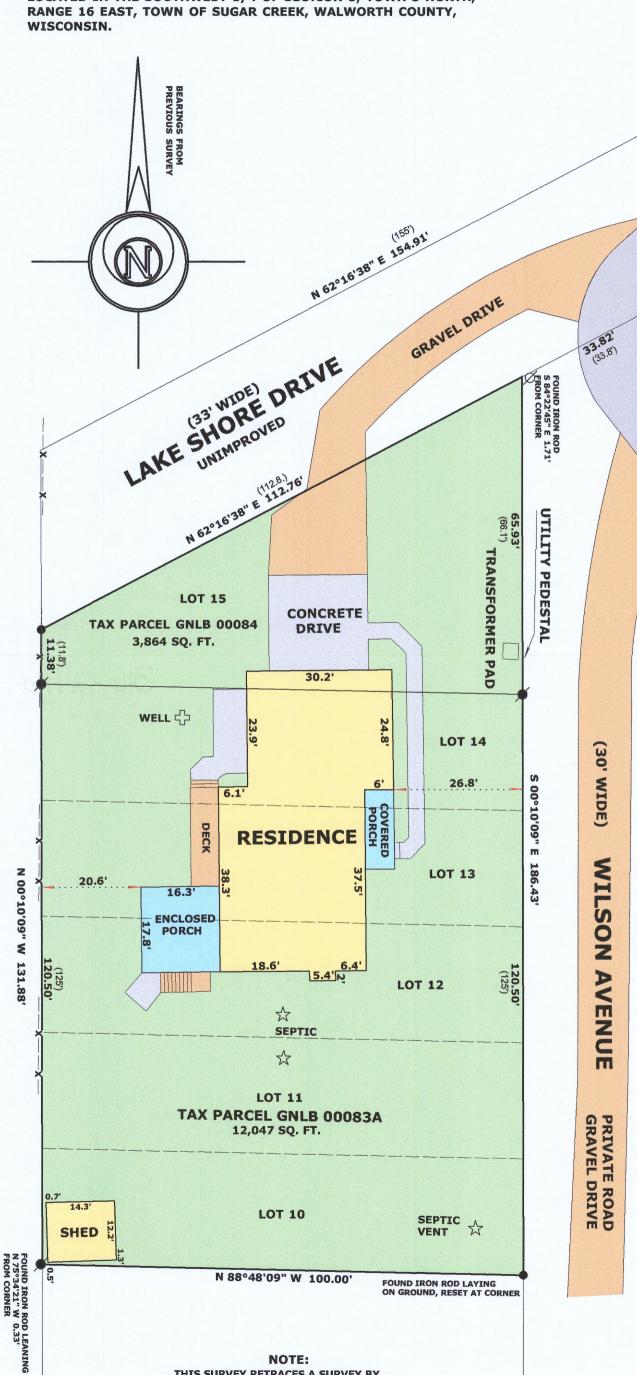





LEGEND

Ø **FOUND IRON PIPE FOUND IRON ROD**

¤ FOUND RAILROAD SPIKE

SET IRON ROD, 18" LONG, WEIGHING 1.5 LBS./LINEAL FT., 3/4" DIA.

RECORDED AS DIMENSION (xx)

EXISTING SPLIT RAIL FENCE -x--X

SCALE: 1 INCH = 20 FEET

"I hereby certify that the above described property has been surveyed by me or under my direction and that the above map is a true representation thereof and shows the size and location of the property, its exterior boundaries, the location of all visible structures and dimensions of all

principal buildings thereon, boundary fences, apparent easements, roadways and visible encroachments, if any."
"This survey is made for the use of the present owners of the property, and also those who purchase, mortgage, or guarantee the title thereto within one year from date hereof."

WISCONSIN PROFESSIONAL **LAND SURVEYOR S-2582**

DATE: JULY 11, 2020

JOB NO. 20.704

THIS SURVEY RETRACES A SURVEY BY

KENNETH B. ABERNATHY JR. DATED 2/10/1997