


PLAT OF SURVEY OF LOTS 4,5, & 6 OF BLOCK 2, NORTH LAKE EVERGREEN BEACH, A SUBDIVISION LOCATED IN THE SE^{1/4} OF SECTION 3, T3N R16, WALKER COUNTY, WISCONSIN, ALSO A PARCEL TO THE SOUTH DESCRIBED AS FOLLOWS: BEGIN AT THE SOUTHWEST CORNER OF LOT 6, BLOCK 2, NORTH LAKE EVERGREEN BEACH; THENCE S7°26'E 30.20 FEET; THENCE S89°40'E 116.18 FEET; THENCE N0°11'E 30.00 FEET TO THE SE CORNER OF LOT 4; THENCE NB9°40'W ALONG THE SOUTHEASTERLY LINE OF SAID LOTS 4,5, & 6, A DISTANCE OF 120.00 FEET TO THE POINT OF BEGINNING.

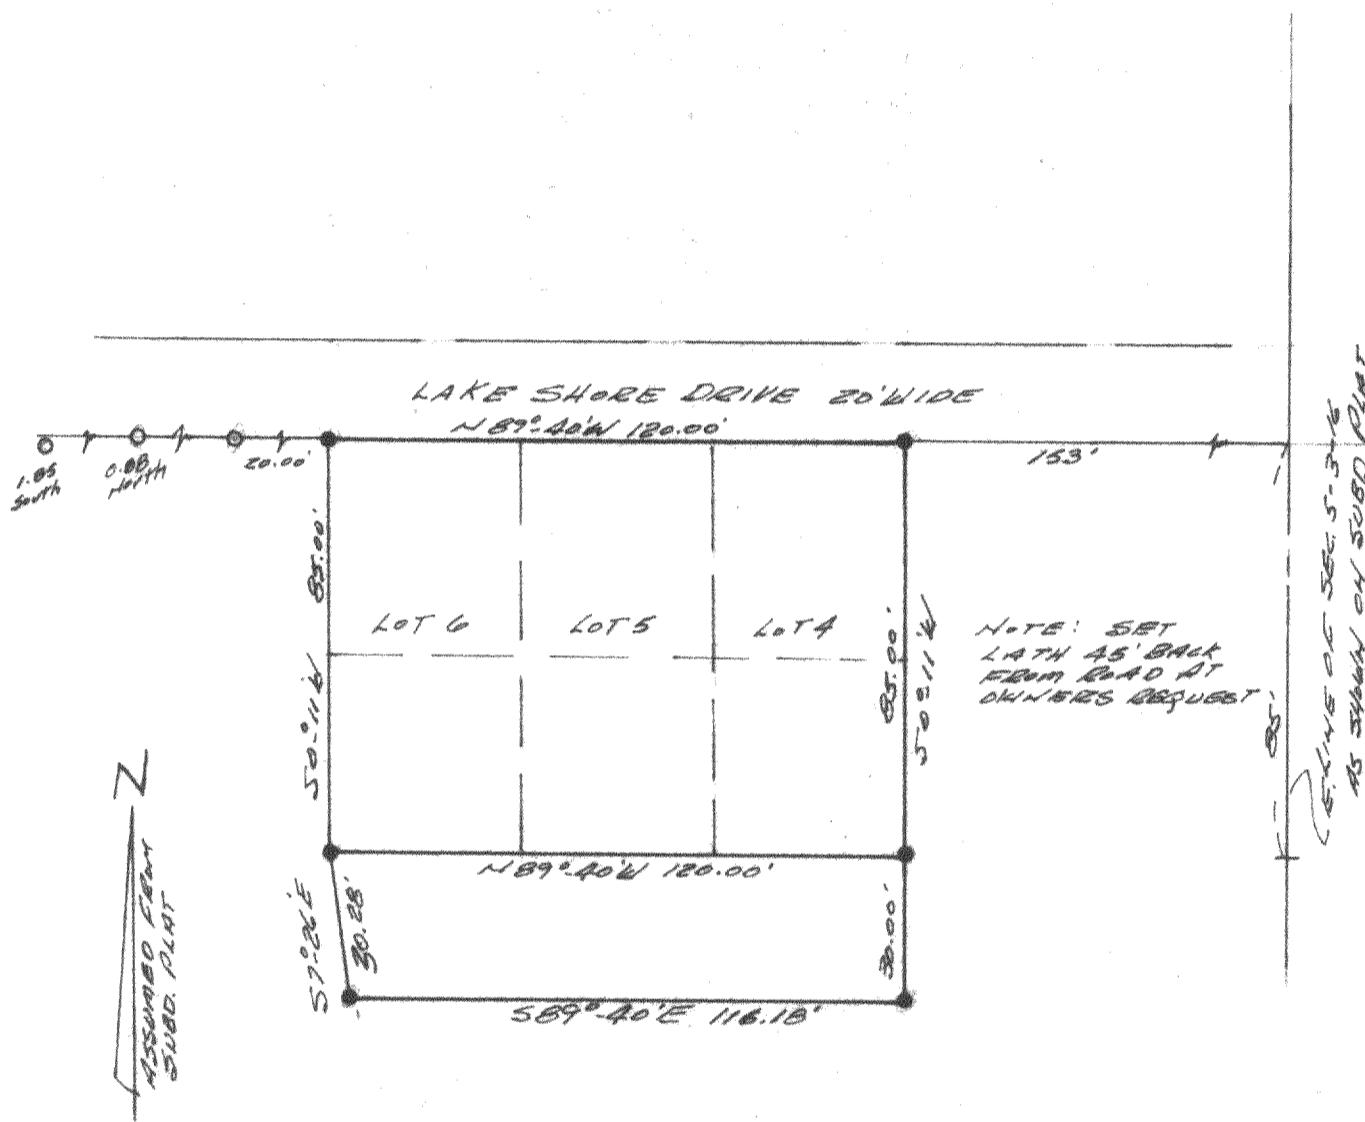


SCALE 1"-40'

- - 120W PIPE GROUT
- - $\frac{3}{4}$ " 120W ROO SET

OWNER: F. KOSZINSKI
SURVEYED FOR: C. MUDRICK
ELK CITY

I CERTIFY THAT I HAVE SURVEYED THE
ABOVE DESCRIBED PROPERTY & THAT THE
PLAT SHOWN HEREON IS AN ACCURATE
SURVEY & A TRUE REPRESENTATION
THEREOF & CORRECTLY SHOWS THE
BOUNDARY LINES AND ALL DIVISIONS
OF SAID PROPERTY.

October 10, 1977

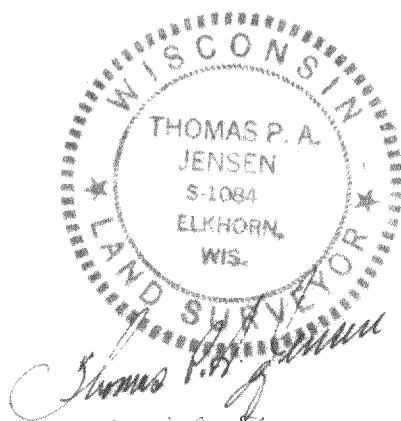

LEWIS & CLARK NATIONAL MUSEUM
ELKHORN, WISCONSIN

(NLE-5)
and parcel SC-5-7C

1977.06.2
316-244