

PLAT OF SURVEY


-OF-

LOTS 1,2 AND 3 OF BLOCK 48, 4TH MAP OF INTERLAKEN,
TOWN OF SUGAR CREEK, WALWORTH COUNTY, WISCONSIN
ACCORDING TO THE RECORDED PLAT THEREOF.

SURVEY FOR: GINA AFFINITO
PARCEL NO. GI 00434



Franklin J. Lehman
FRANKLIN J. LEHMAN S-2211
7/3/20 200606
DATE JOB NUMBER

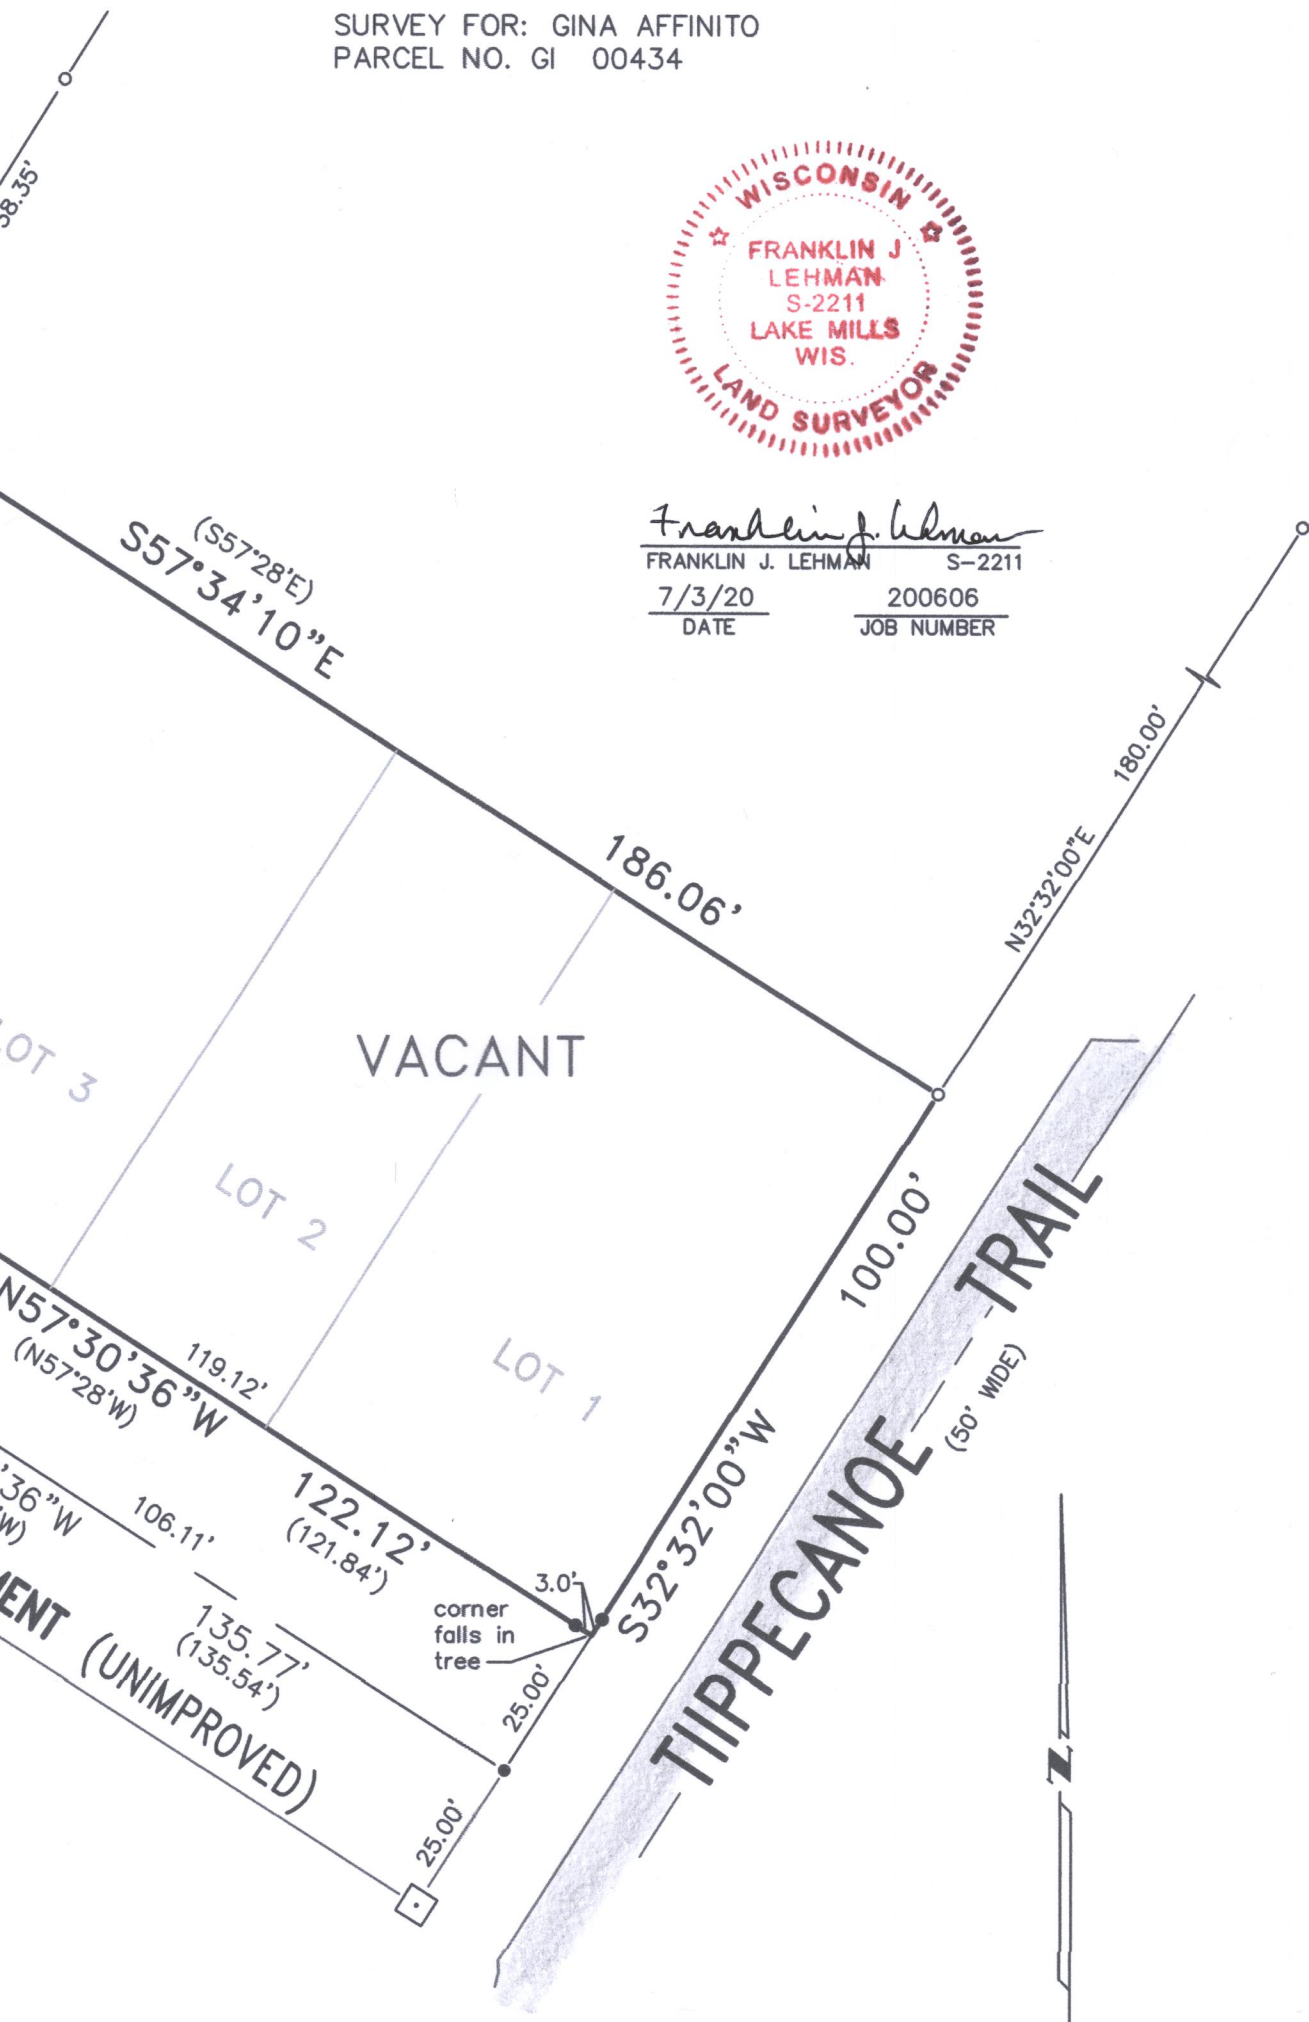

above described property
presentation thereof and
y, its exterior boundaries,
mensions of all principal
t easements, roadways

sent owners of the property,
antee the title thereto within


SURVEYING

551

L (262) 901-5116



SCALE: 1" = 30'

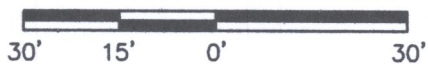

LEGEND

- FOUND IRON PIPE
- SET IRON ROD
- () RECORDED PLAT DISTANCE
- 4"x4" CONCRETE MONUMENT

316-2450

PLAT OF SURV


-OF-

LOTS 1,2 AND 3 OF BLOCK 48, 4TH MA
TOWN OF SUGAR CREEK, WALWORTH COUN
ACCORDING TO THE RECORDED PLAT THE

SURVEY FOR: GINA AFFINITO
PARCEL NO. GI 00434



Franklin J. Lehman
FRANKLIN J. LEHMAN S-
7/3/20 20060
DATE JOB NUME

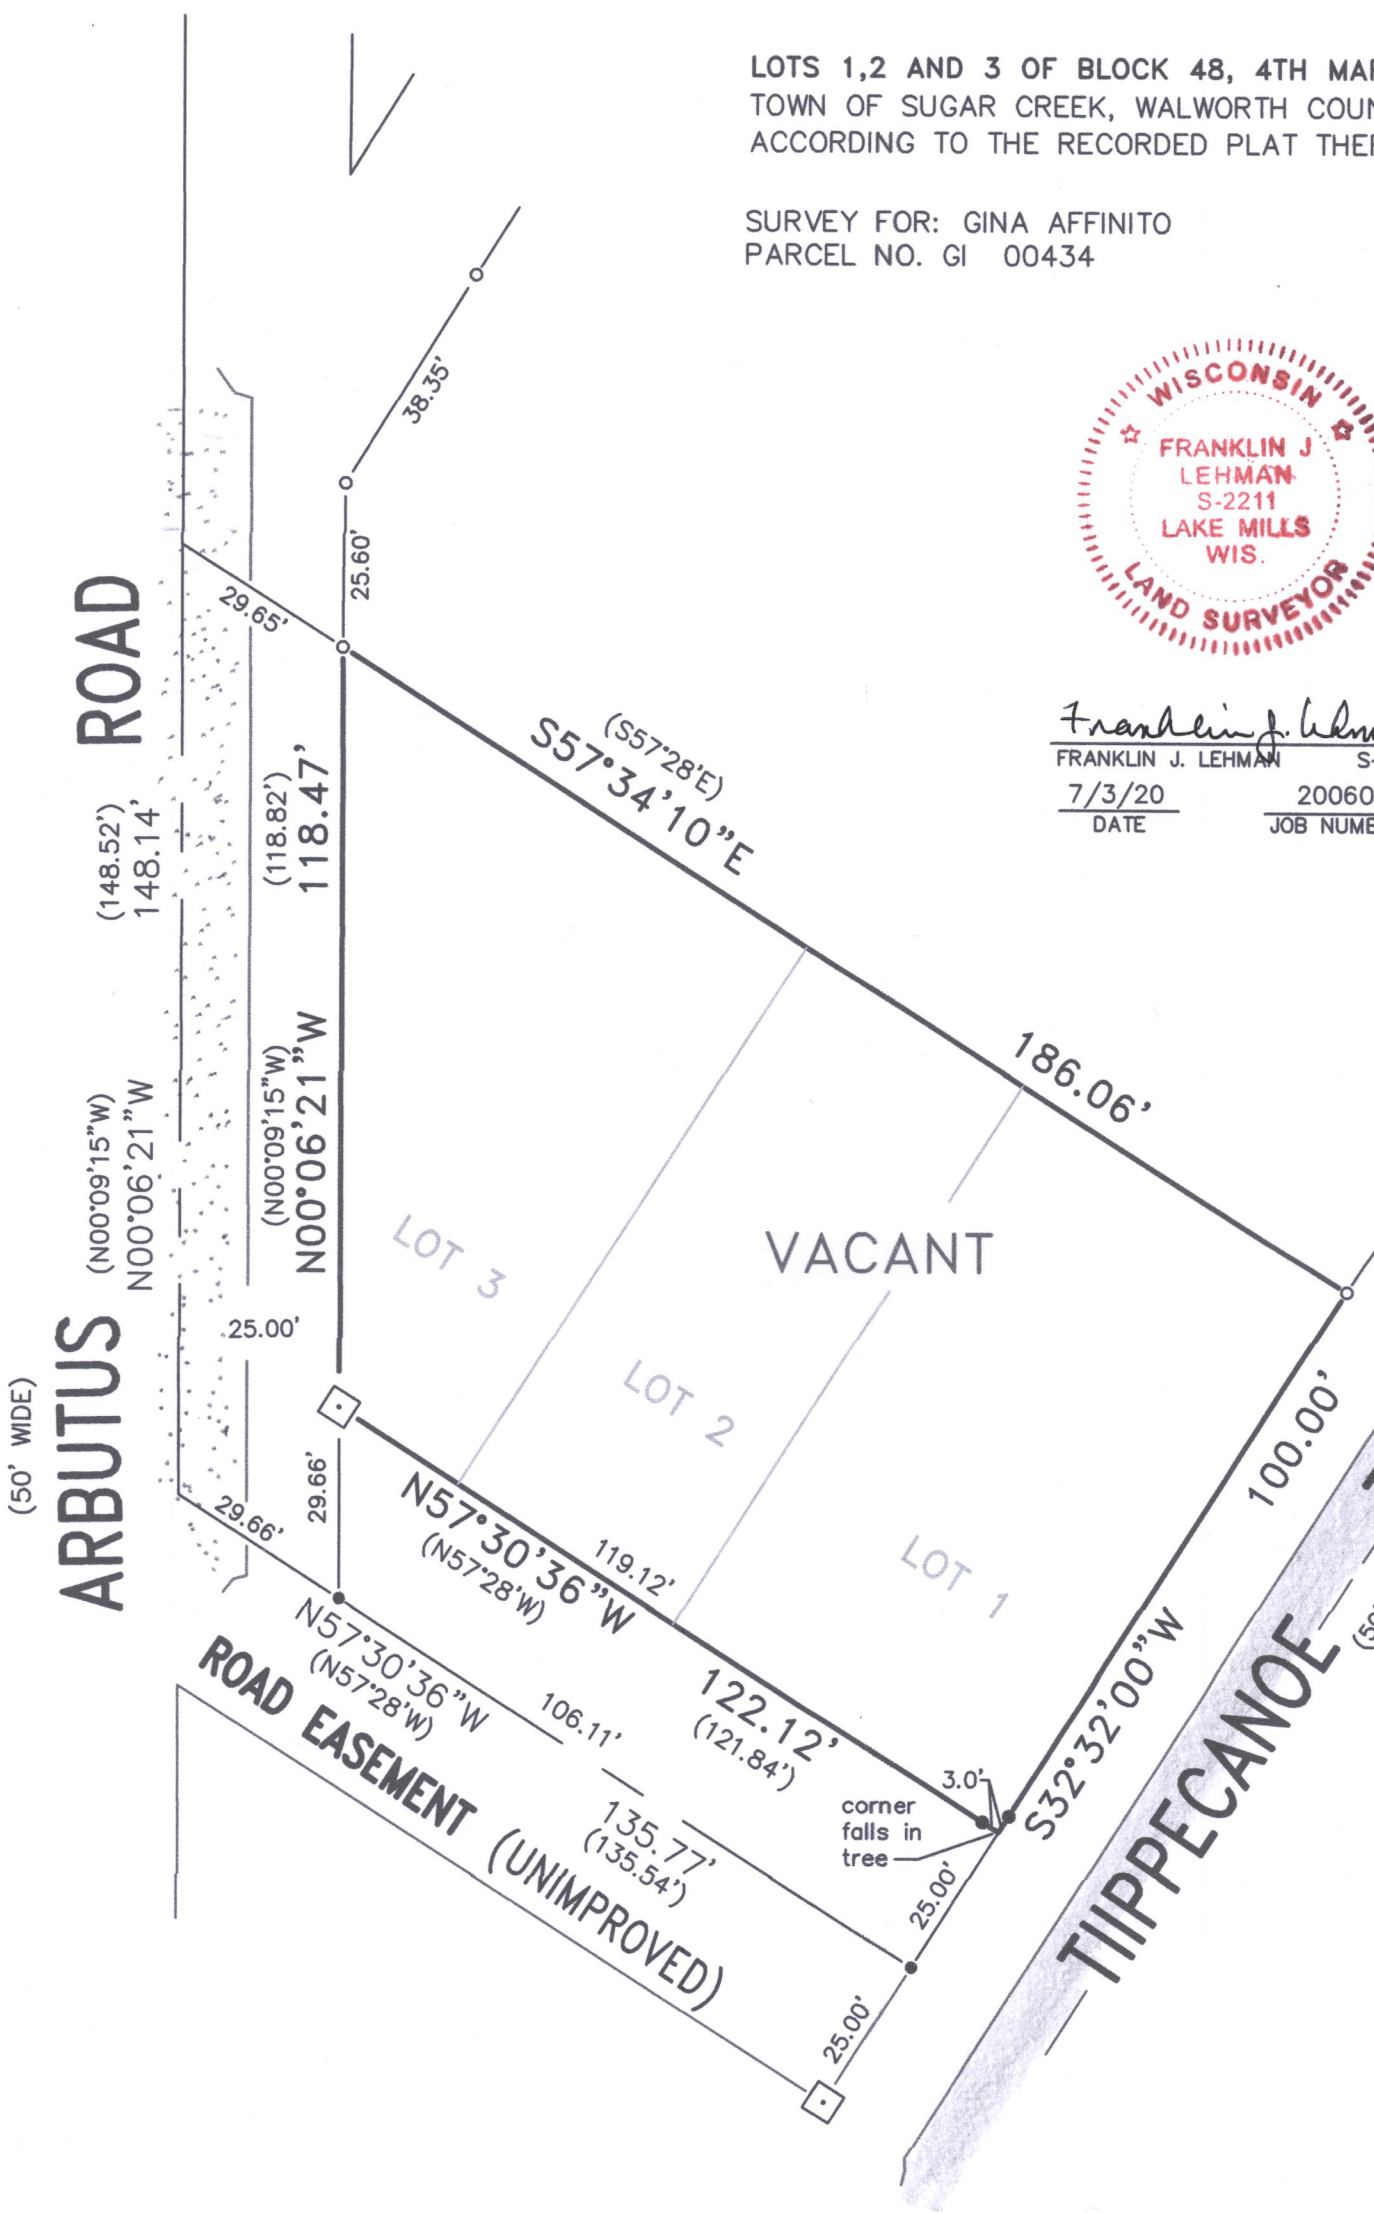

I hereby certify that I have surveyed the above described property and that the above map is a correct representation thereof and shows the size and location of the property, its exterior boundaries, the location of all visible structures and dimensions of all principal buildings thereon, boundary fences, apparent easements, roadways and encroachments, if any.
This survey is made for the use of the present owners of the property, and those who purchase mortgage or guarantee the title thereto within one year from date hereof.

LIBERTY LAND SURVEYING

PO BOX 202

LAKE MILLS, WI 53551

OFC (262) 767-8786

CELL (262) 901-5116



30'

GI 434