

Scale: 1" = 20'

DISTANCE UNITS BASED ON THE UNITED STATES SURVEY FOOT

BEARINGS BASED ON THE EAST LINE OF LAKE SHORE DRIVE BEARING N 23°23'48" E

VERTICAL DATUM BASED ON NAVD-88 (2012)

Keistm J Belingin

Kristin J. Belongia, P.L.S. Wisconsin Professional Land Surveyor S-2943


State of Wisconsin County of Rock }

If the surveyor's signature is not red in color, the plan is a copy that should be assumed to contain unauthorized alterations.

The certification contained on this document shall not apply to any copies.

I hereby certify that I have supervised the survey of the property described above and to the best my knowledge and belief, the plat drawn hereon complies with Chapter A-E 7 of the State of Wisconsin Administrative Code, Minimum Standards for Property Surveys and correctly represents the size and location of the property, exterior boundaries, the location of all visible structures, and dimensions of all principle buildings thereon, fences, easements of record, and roadways, if any. This survey is made for the use of the present owners of the property, and also those who purchase, mortgage, or guarantee the title thereto within one year from the date hereof.

Given under my hand and seal this 10th day of November, 2020 at Beloit, Wisconsin Last day of field work November 6th, 2020

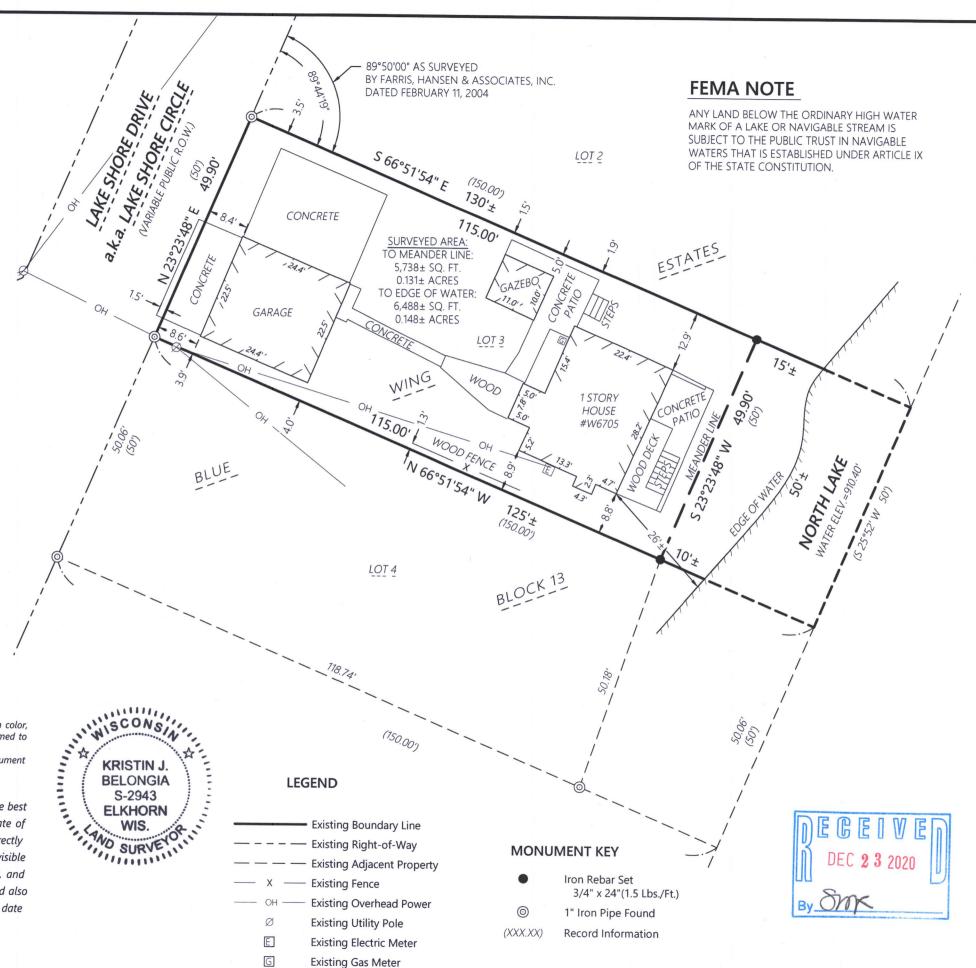

GBW-35

316-2451

Batterman

SURVEY

OF

PLAT

The Rauland Agency, In 118 Kenosha Street Walworth, WI 53184

> FIELD CREW: DJE DRAWN BY: DJE

**ORDER NO: 33791**