



PLAT OF SURVEY OF Lots 3, 4, & 5 of Block 65, Fifth Map of Interlaken, a Subdivision located in the Northwest $\frac{1}{4}$ of Section 14, T3N R16E, Walworth County, Wisconsin.

Dated September 8, 1977

Surveyed for: Peter Kouzes, Elkhorn, Wis.

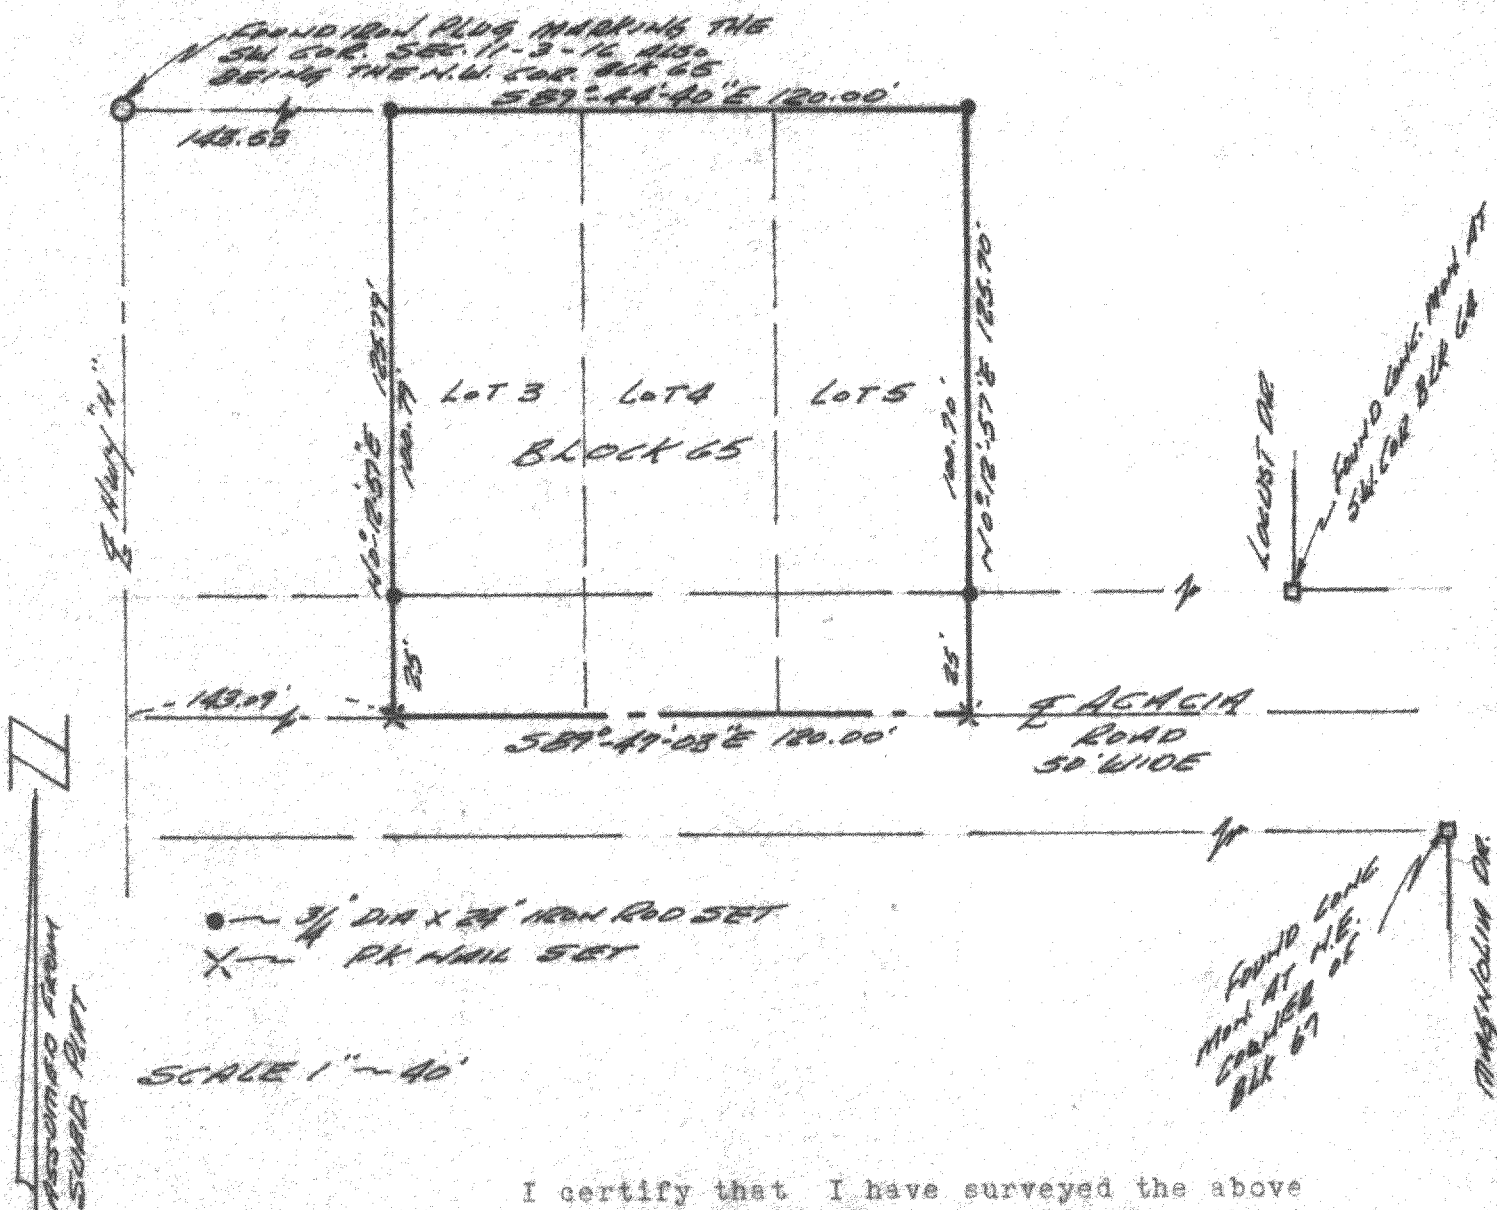

I certify that I have surveyed the above described land & that the plat shown hereon is an accurate survey & a true representation thereof & correctly shows the exterior boundary lines & all divisions of said property.

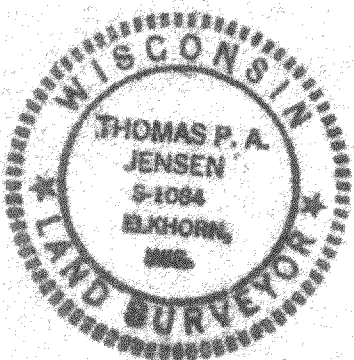

Thomas P. A. Jensen
 Thomas P. A. Jensen S-1084
 JENSEN SURVEYING AND MAPPING
 ELKHORN, WISCONSIN

P.O. 1977-040

316-247

61-592