
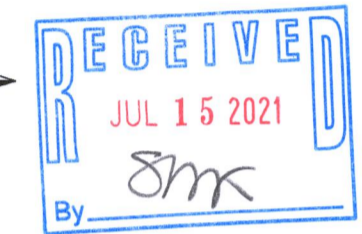


of

a subdivision located in Government Lot 5 in the Southeast 1/4 of Section 11, Town 3 North, Range 16 East, Town of Sugar Creek, Walworth County, Wisconsin.


Surveyed for:

N7066 Lakeshore Avenue
Elkhorn, Wisconsin. 53121

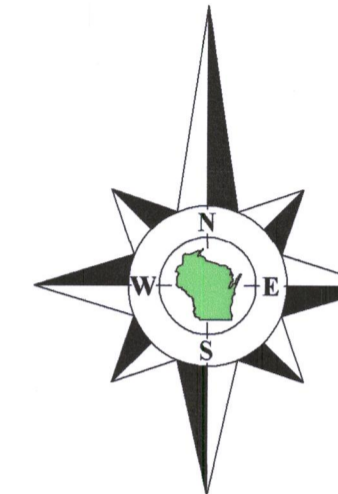

Bearings referenced to the Southerly line of Rosewood Road, recorded as N78°54'48"E on the plat of the Third Map of Interlaken, a rotation of 1°58'15" from the Wisconsin State Plane Coordinate System, South Zone, (NAD-27).

Coordinates are referenced to the Wisconsin State Plane Coordinate System, South Zone, (NAD-27).

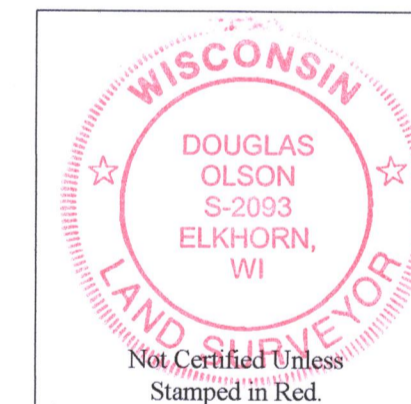

Notes:

- 1) This Plat of Survey is not certified unless signed and sealed in red ink.
- 2) This survey is subject to Wisconsin lien laws. This Plat of Survey is the notice of intent to file lien. Lien waiver required.
- 3) The Survey Date shown on this Plat of Survey is the completion date of the field work.

Southeast Corner
Section 11-3-16
(N. 268,629.83)
(E. 2,386,318.67)

Copyright © 2021 by Olson Land Surveying, LLC.

All rights reserved. No part of this survey plat may be reproduced or transmitted in any form by any means - graphic, electronic, or mechanical, including photocopying, tracing, or information storage and retrieval systems - without permission in writing from Douglas G. Olson, Olson Land Surveying, LLC.


I hereby certify that I have surveyed the above described property in compliance with Chapter A-E 7 of the Wisconsin Administrative Code and that the map hereon is correct to the best of my professional knowledge and belief and shows the size and location of the property, its exterior boundaries, the location and dimensions of all visible structures thereon, boundary fences, apparent easements and roadways and visible encroachments, if any.

This survey is made for the exclusive use of the present owners of the property, and also those who purchase, mortgage or guarantee title thereto, within one year from the date hereof.

Douglas G. Olson
Wisconsin Professional Land Surveyor - 2093

Survey Date: February 23, 2021.
Revisions:

Scale in Feet
1" = 20'



45 South Wisconsin Street | P.O. Box 322
Elkhorn, Wisconsin. 53121
Telephone: (262) 723-3434
Facsimile: (262) 723-8044
Email: doug@olsonsurveying.com
Website: www.olsonsurveying.com

OLSON
LAND SURVEYING, LLC
Rural | Residential | Commercial

	N	North
Found County Section Corner	S	South
Found Concrete Monument	E	East
Found Iron Rod 3/4" dia.	W	West
Found Iron Pipe, 1" dia.		Bearings
Found Iron Pipe, 1" dia.		" Minutes
Recorded Information		" Seconds
Utility Box or Pedestal		In Distances
Gravel Surface		" inches

Sheet 1 of 1 Sheets

Drawing Name:

Job Reference Number

2021.009

2021.009