
PLAT OF SURVEY

OF LOT 2 OF CERTIFIED SURVEY MAP NO. 604, RECORDED IN VOLUME 3 ON PAGE 64, BEING PART OF THE NE 1/4 OF THE NE 1/4 OF SECTION 2, TOWNSHIP 3 NORTH, RANGE 16 EAST, OF THE 4TH P.M., TOWN OF SUGAR CREEK, WALWORTH COUNTY, WISCONSIN

PLANTATION ROAD

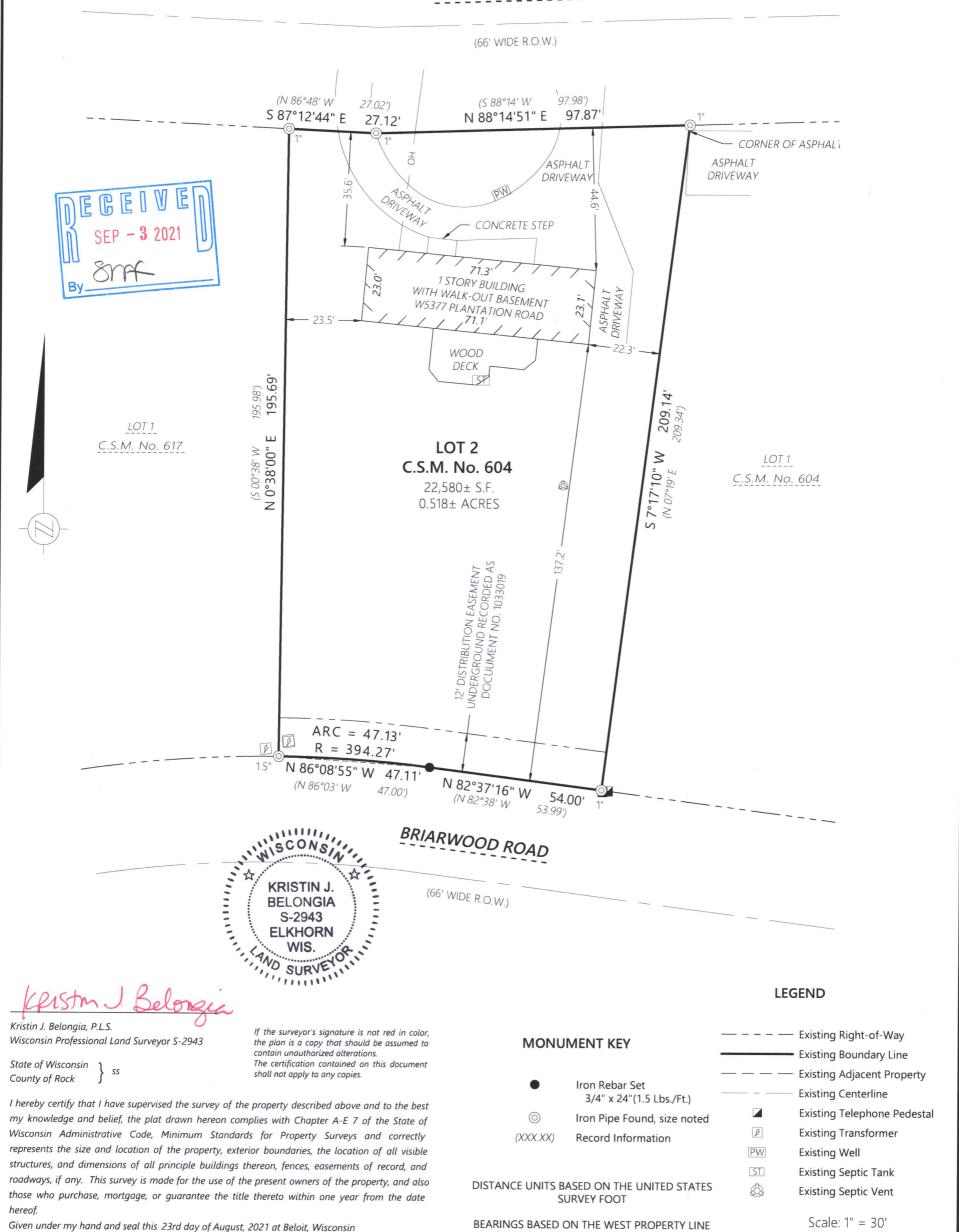

ORDER NO: 34012

Last day of field work August 13th, 2021

FIELD CREW: DGM / BMR DRAWN BY: BMR

FOR THE EXCLUSIVE USE OF. Matthew & Michelle Buelow W5377 Plantation Road Elkhorn, WI 53121

PLAT OF SURVEY

HAVING A BEARING OF N 0°38'00" E

2857 Bartells Drive Beloit, Wisconsin 53511

www.rhbatterman.com

608.365.4464

60

30

W5377 Plantation Rd\SURVEY\RHB DRAWING FILES