
## PLAT OF SURVEY

LOCATION: Canary Road, Sugar Creek, Wisconsin

## LEGAL DESCRIPTION:

The East 1/2 of Lot 9, except the North 8 feet, all of Lots 10 and 11, except the North 8 feet and the West 1/2 of Lot 12, except the North 8 feet, and the West 1/2 of Lot 21, all of Lots 22 and 23, and the East 1/2 of Lot 24, all in Block 71, INTERLAKEN SUBDIVISION (5TH Map), Town of Sugar Creek, Walworth County, Wisconsin.

November 7, 2022 Survey No. 113472-B

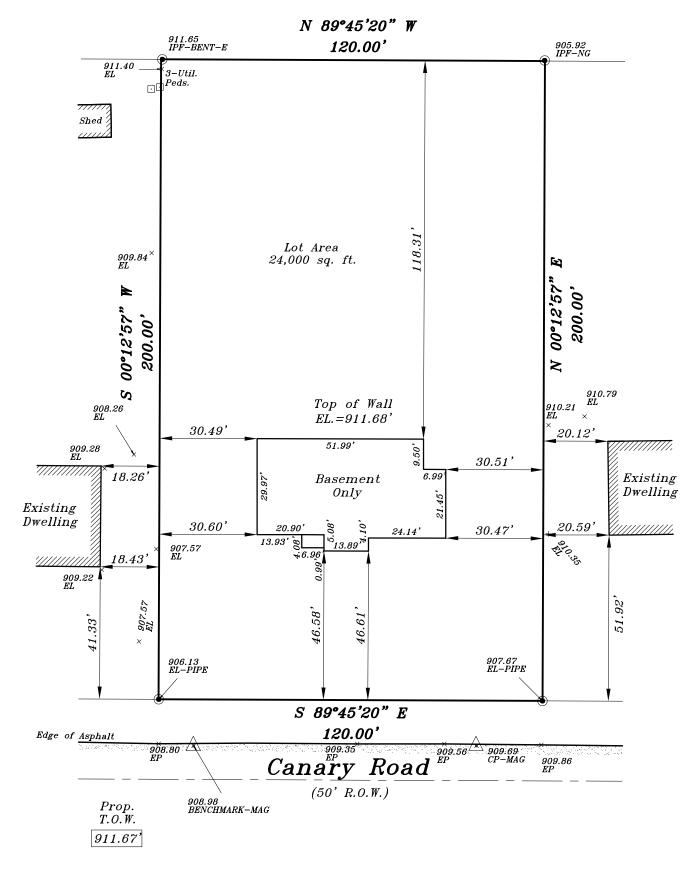

Prop. Fin. Yd. Gr. 911.0'

Prop.

Gar. Slab

911.33

Proposed finished yard, 1st floor or top of foundation grade shown on this drawing is a suggested grade and should be verified by the owner, builder or municipality

## METROPOLITAN SURVEY SERVICE, INC.

## PROFESSIONAL LAND SURVEYORS

9415 West Forest Home Avenue, Suite 202
Hales Corners, Wisconsin 53130
PH. (414) 529-5380
survey@metropolitansurvey.com

www.metropolitansurvey.com

• — Denotes Iron Pipe Found


© — Denotes Iron Pipe Set

000.0 — Denotes Proposed Grade
Denotes Proposed Silt Screen



( IN FEET ) 1 inch = 30 ft.



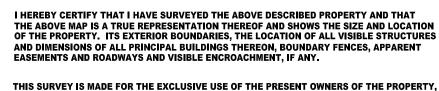

AND ALSO THOSE WHO PURCHASE, MORTGAGE, OR GUARANTEE THE TITLE THERETO WITHIN ONE (1) YEAR FROM THE DATE HEREOF.

Dennis C. Sauer
Professional Land Surveyor S-2421