

PLAT OF SURVEY—PERMIT PLAT

LOTS 32 THROUGH 36 AND THE S. 1/2 OF LOT 37 OF BLOCK 16 OF INTERLAKEN, A SUBDIVISION

LOCATED IN PART OF THE SOUTHEAST 1/4 OF THE SOUTHWEST 1/4 OF SECTION 11, TOWN 3 NORTH, RANGE 16 EAST, WALWORTH COUNTY, WISCONSIN




PLAT OF SURVEY
N6543 BIRCH ROAD
ELKHORN, WISCONSIN


- WORK ORDERED BY -
FRED LYNN
N6543 BIRCH ROAD
ELKHORN, WI 53121

FARRIS, HANSEN & ASSOCIATES, INC.
ENGINEERING - ARCHITECTURE - SURVEYING
7 RIDGWAY COURT, P.O. BOX 437
ELKHORN, WISCONSIN 53121
PHONE: (262) 723-2098 e-mail: office@farrishansen.com


REVISIONS

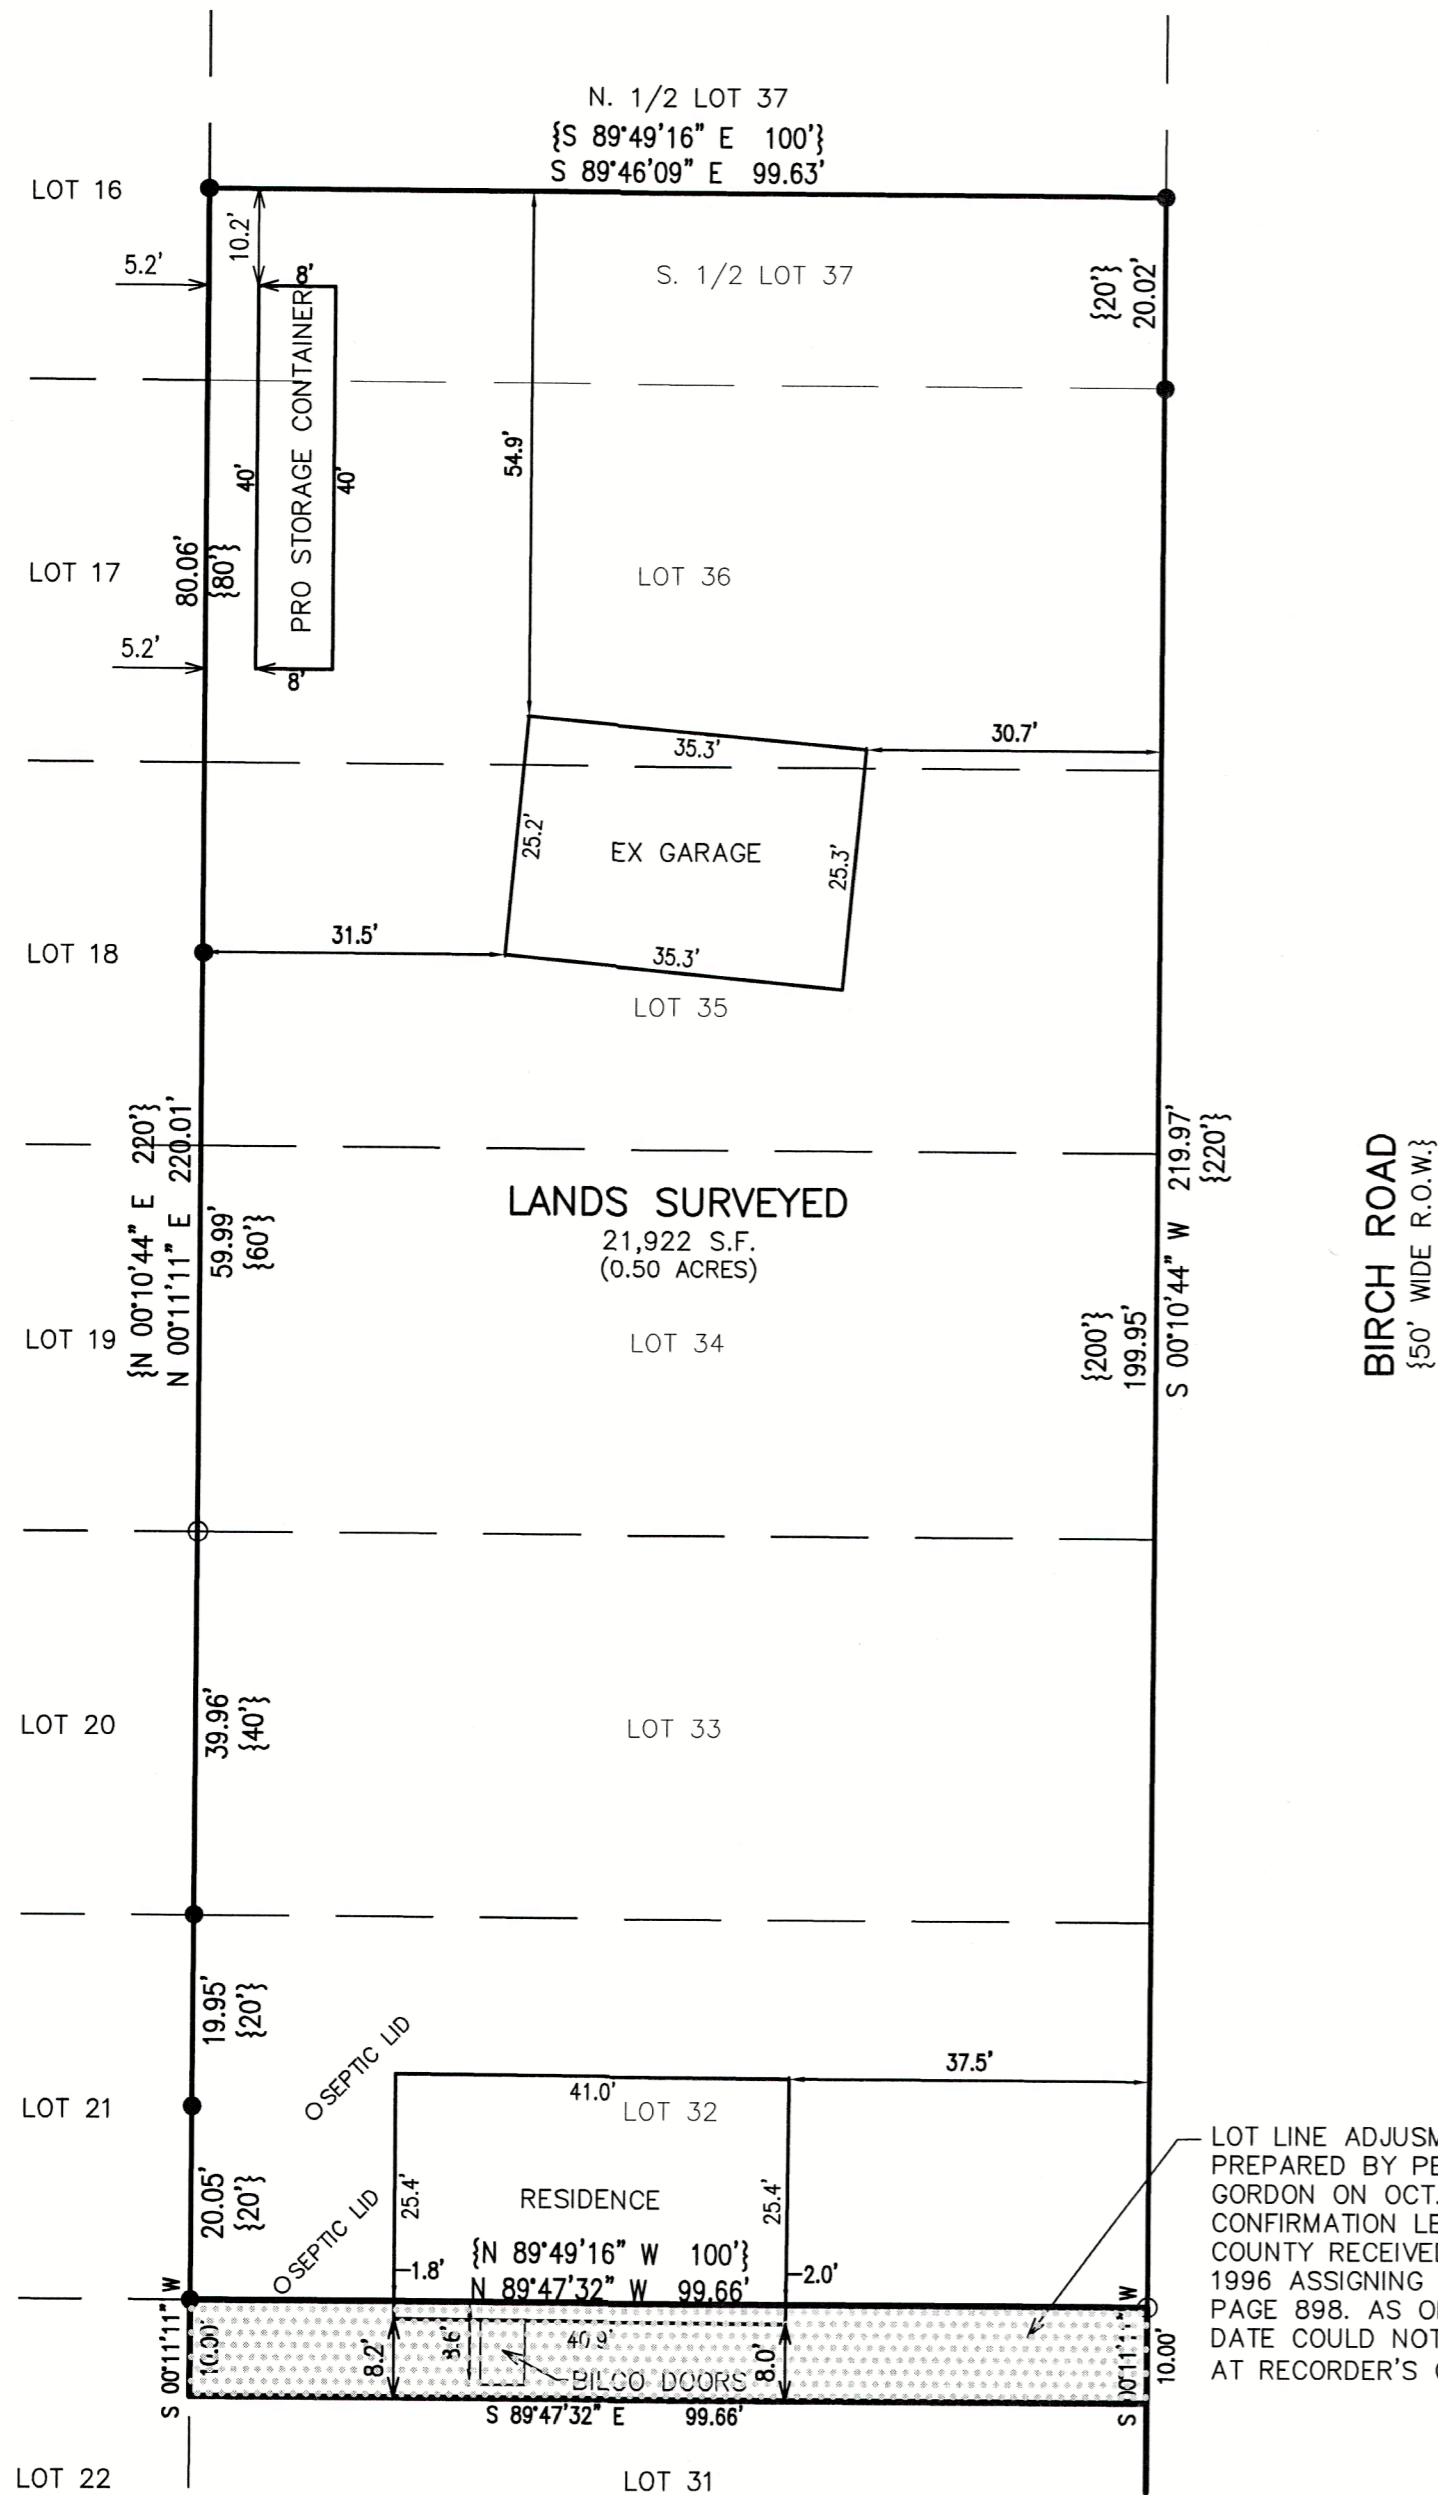

LOT LINE ADJUSTMENT MAP
PREPARED BY PETER
GORDON ON OCT. 10, 1996.
CONFIRMATION LETTER FORM
COUNTY RECEIVED NOV. 14,
1996 ASSIGNING VOL 316
PAGE 898. AS OF THIS
DATE COULD NOT LOCATE
AT RECORDER'S OFFICE.

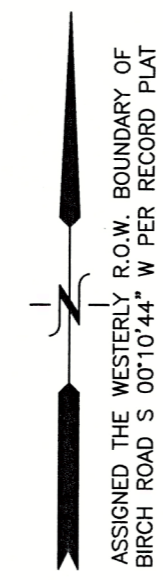

- LEGEND**
- = FOUND IRON PIPE STAKE
 - = FOUND IRON REBAR STAKE
 - {XXX} = RECORDED AS

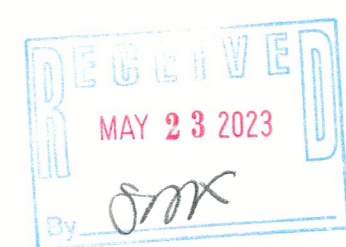

NOTE: COPIES OF THIS MAP TO WHICH THE FOLLOWING CERTIFICATE WILL APPLY SHOW THE SURVEYOR'S ORIGINAL SEAL AND SIGNATURE IN RED INK. COPIES BY ANY OTHER MEANS MAY HAVE ALTERATIONS WHICH DO NOT REPRESENT THE SURVEYOR'S WORK PRODUCT.

I HEREBY CERTIFY THAT THE ABOVE DESCRIBED PROPERTY HAS BEEN SURVEYED UNDER MY DIRECTION AND THAT THE ABOVE MAP IS A TRUE REPRESENTATION THEREOF AND SHOWS THE SIZE AND LOCATION OF THE PROPERTY AND ITS EXTERIOR BOUNDARIES. THIS SURVEY IS MADE FOR THE USE OF THE PRESENT OWNERS OF THE PROPERTY, AND ALSO THOSE WHO PURCHASE, MORTGAGE, OR GUARANTEE THE TITLE THERETO WITHIN ONE YEAR FROM THE DATE HEREOF.



DATED: 5/22/2023

Christopher A. Hodges
CHRISTOPHER A. HODGES P.L.S. 2760

PROJECT NO.	10860
DATE:	05/22/2023
SHEET NO.	1 OF 1

X:\PROJECTS\10860\ACAD\10860.dwg

GI-212

316-2557