


SAME CONC. MONUMENT

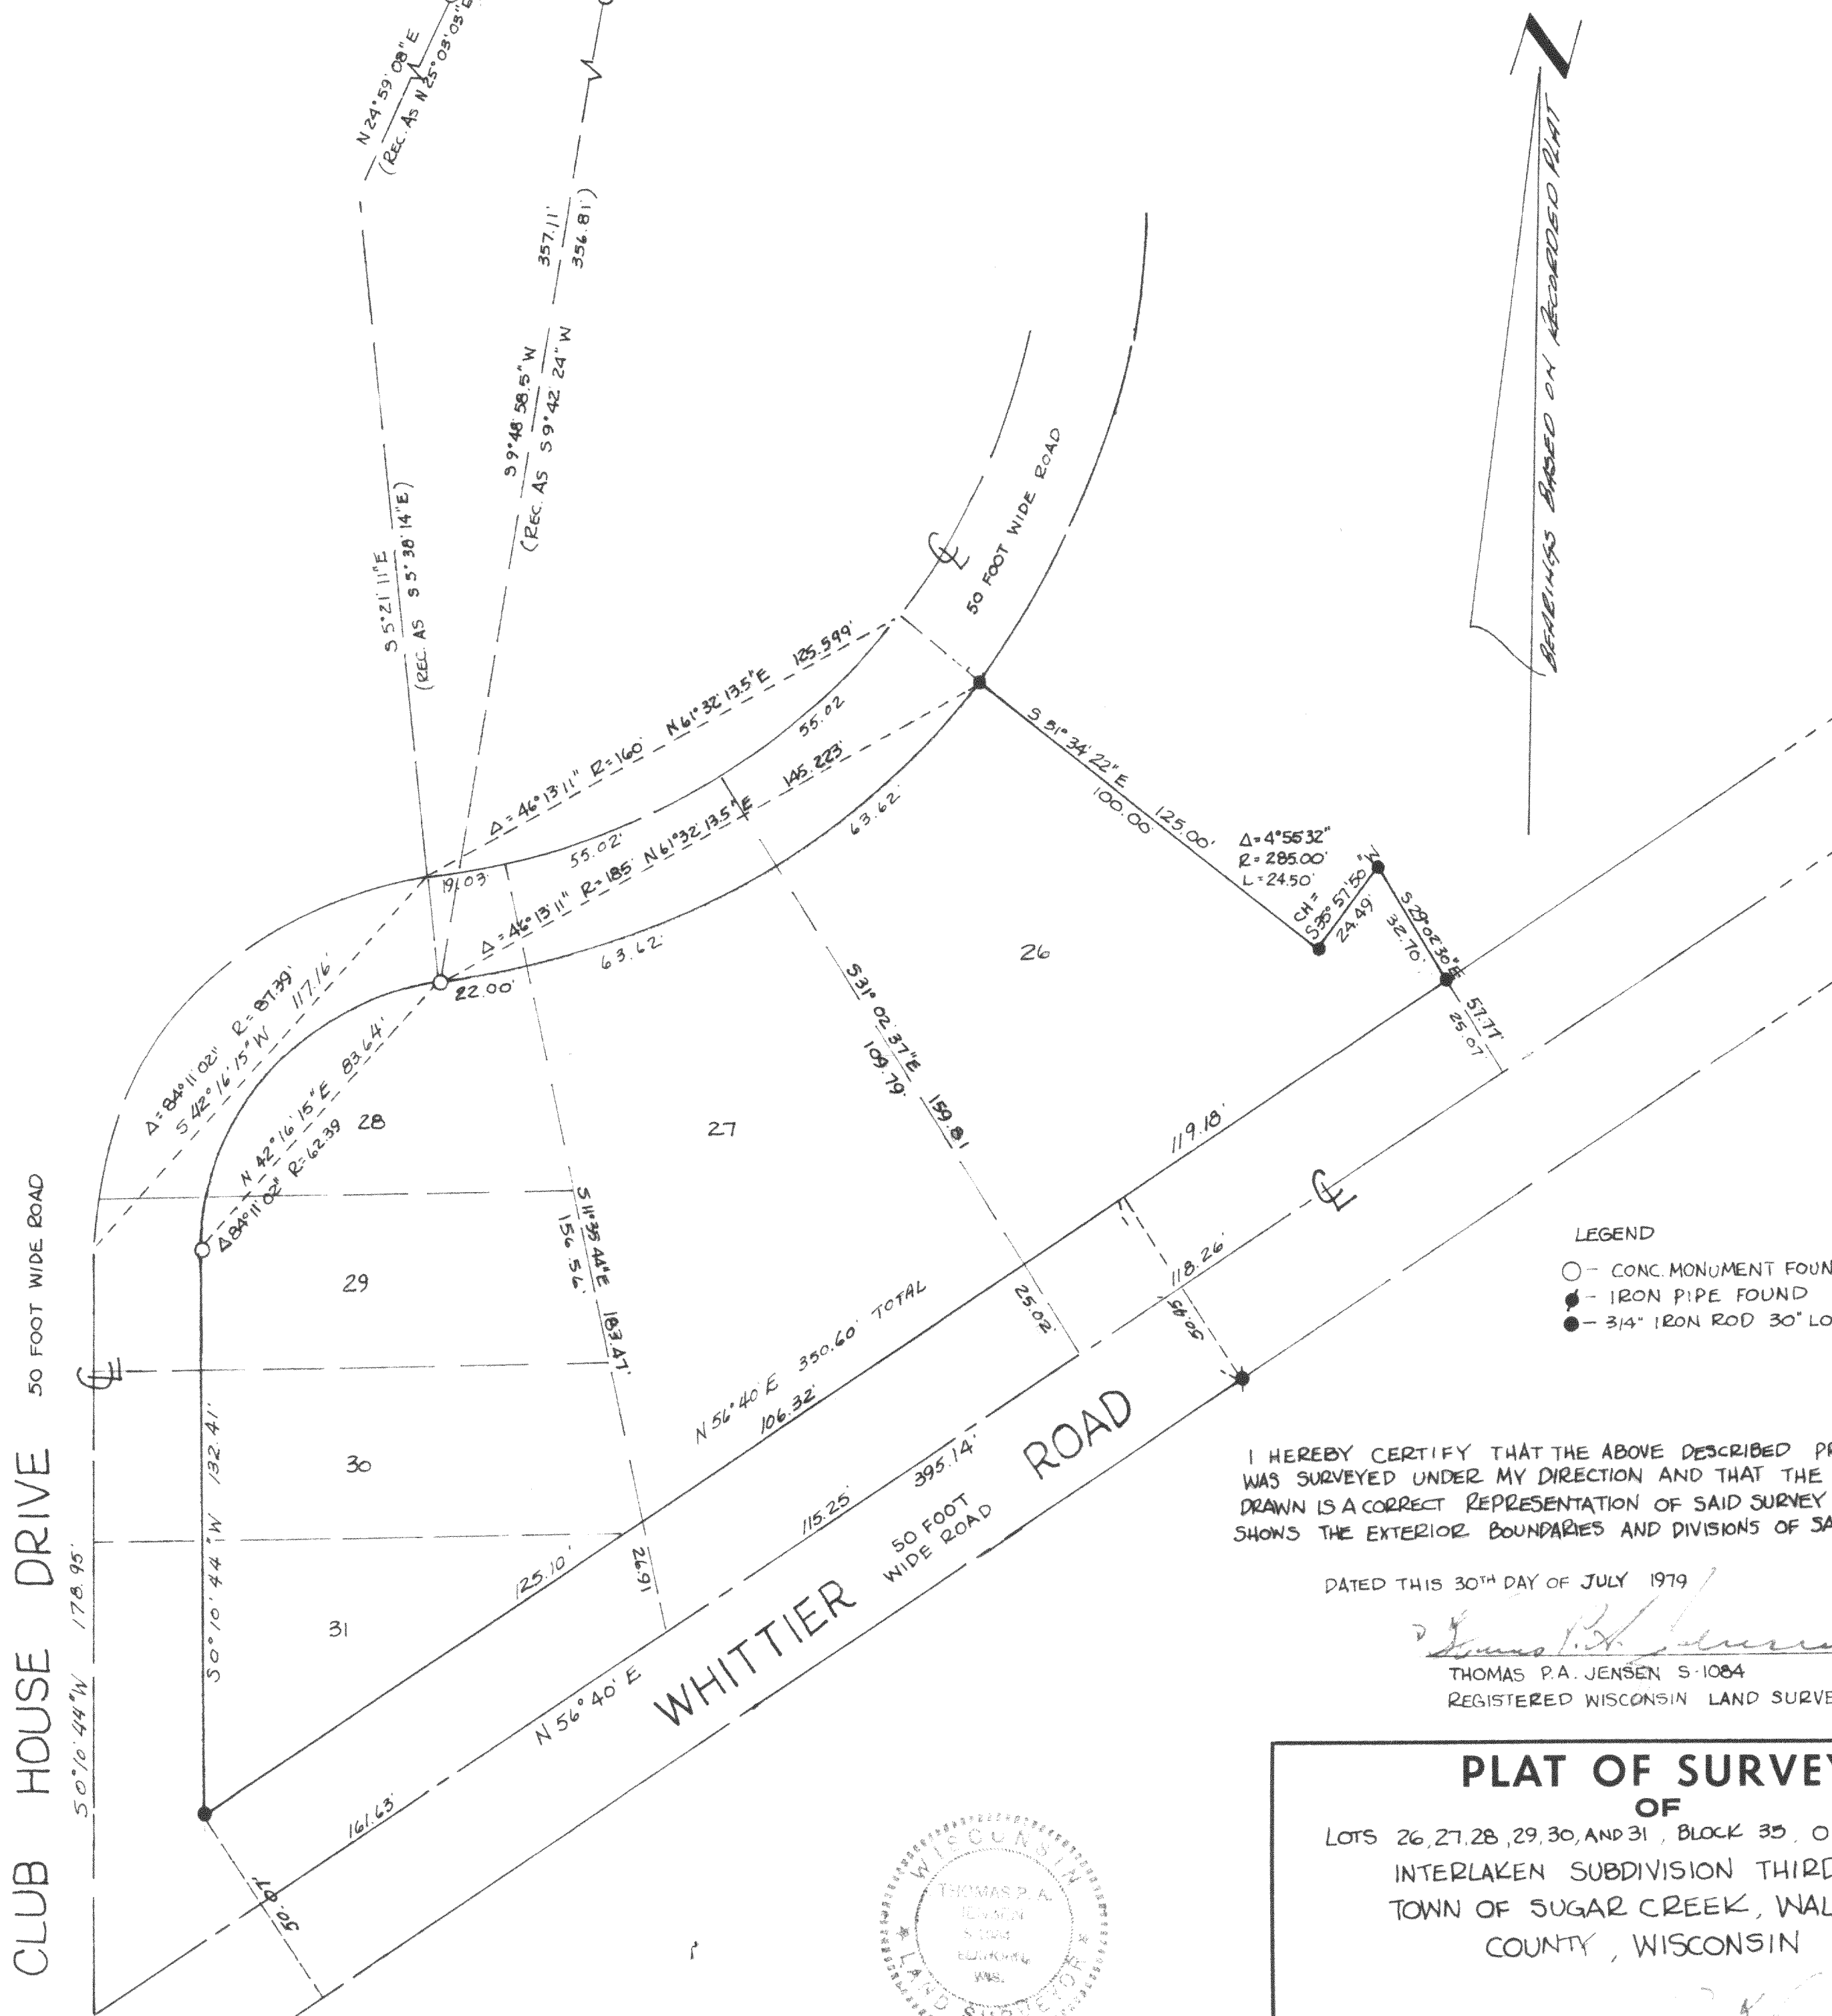

LEGEND

- - CONC. MONUMENT FOUND 4" SQUARE
- - IRON PIPE FOUND
- - 3/4" IRON ROD 30" LONG SET

I HEREBY CERTIFY THAT THE ABOVE DESCRIBED PROPERTY WAS SURVEYED UNDER MY DIRECTION AND THAT THE PLAT HEREON DRAWN IS A CORRECT REPRESENTATION OF SAID SURVEY AND CORRECTLY SHOWS THE EXTERIOR BOUNDARIES AND DIVISIONS OF SAID PROPERTY

DATED THIS 30TH DAY OF JULY 1979


Thomas P. Jensen

THOMAS P. JENSEN S-1084
REGISTERED WISCONSIN LAND SURVEYOR

PLAT OF SURVEY
OF

LOTS 26, 27, 28, 29, 30, AND 31, BLOCK 35, OF
INTERLAKEN SUBDIVISION THIRD ADDITION
TOWN OF SUGAR CREEK, WALWORTH
COUNTY, WISCONSIN

Thomas P. Jensen
SURVEYOR

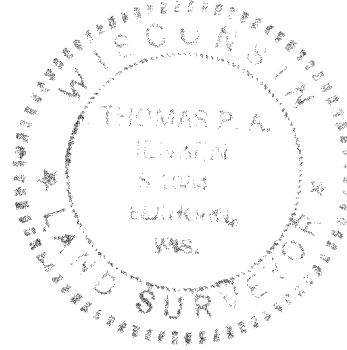

SURVEYED FOR: R. SCOTT
LOT 4 BOX 263
ELKHORN, WIS. 53121

SCALE 1" = 30'

DATE 7-30-79