



PLAT OF SURVEY OF LOTS 16, 17, 18 & 19, BLOCK 48,  
OF INTERLAKEN, 4th MAP, TOWN OF SUGAR  
CREEK, WALWORTH COUNTY, WISCONSIN.

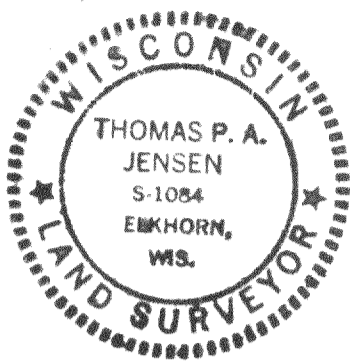

QUEEN ROAD 50' WIDE SUBD. ROAD

(S 57° 28' E) 125.00'

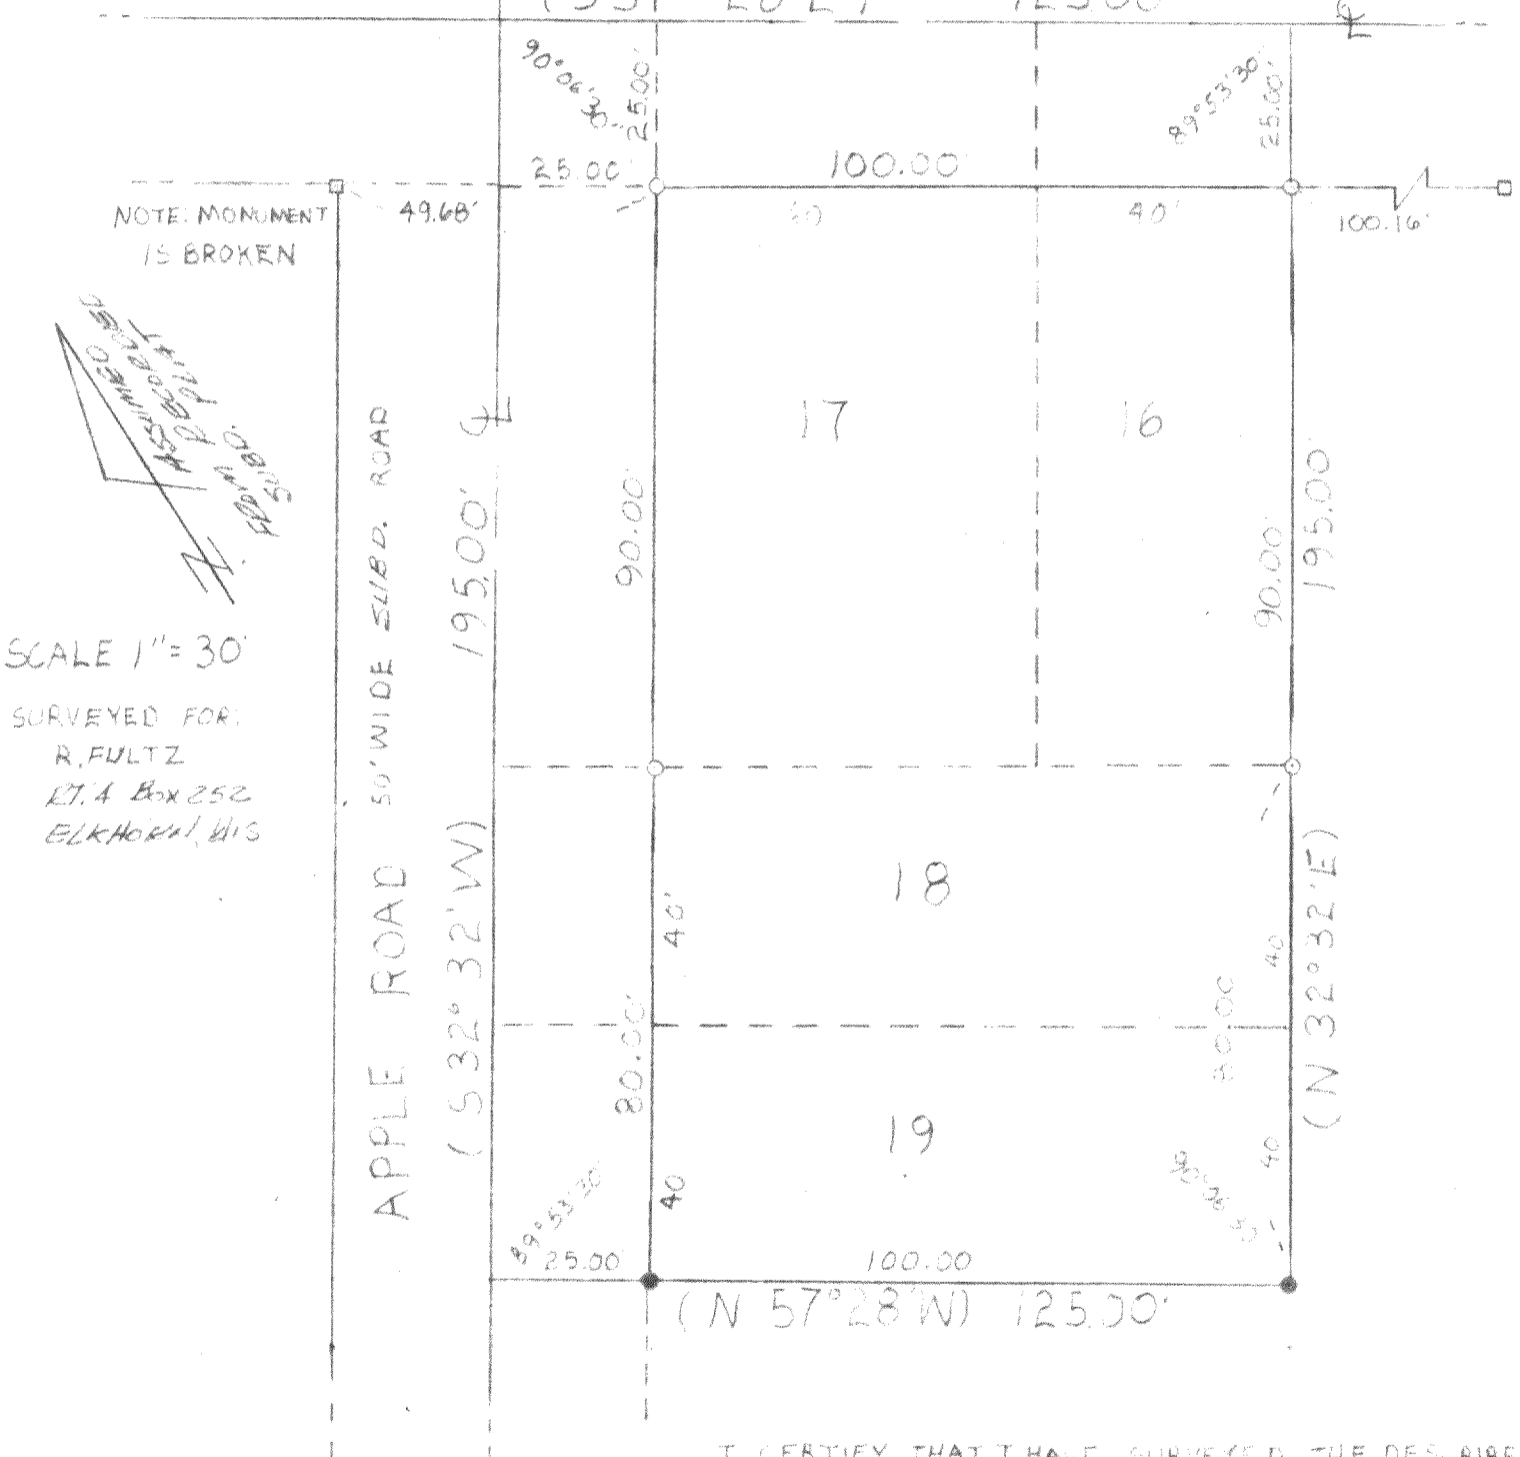

LEGEND

- ( ) ~ RECORDED AS
- ~ FOUND 1" IRON PIPE
- ~ FOUND CONCRETE MONUMENT
- ~ SET 1" IRON PIPE 24" LONG

I CERTIFY THAT I HAVE SURVEYED THE DESCRIBED PROPERTY AND THAT THE PLAT SHOWN HEREON IS AN ACCURATE SURVEY & A TRUE REPRESENTATION THERE OF & CORRECTLY SHOWS THE BOUNDARY LINES OF SAID PROPERTY.

JULY 24, 1980

*Thomas P. A. Jensen*  
THOMAS P. A. JENSEN S-1084

JENSEN SURVEYING & MAPPING  
P.O. BOX 322  
ELKHORN, WISCONSIN