## Heritage Engineering and Surveying, Itd.


Civil Engineers & Land Surveyors 3213 WASHINGTON AVE. RACINE, WI 53405 Phone: (414)637-8808

1 - 1-	hl.	8429
1.4	NA	and the said

MORTGAGE INSPECTION

	Michael	R.	Lakin	and	Barbara	Lakin,	his	wife	
OF PROPERTY OF		AND	page por process and the second secon	house and constitute the same	STEETEN VIII TOO ON TOO ON TOO ON THE STEETEN VIII TOO	Signature control of the second of the secon		nga mga nga nga nga nga nga nga nga nga nga n	

described as follows: Lot 2 of Certifies Survey Number 408 located in the Southwest & of Section 12, T3N, R16E, according to the plat thereof recorded in Volume 2 of Certified Surveys on page 205 as Document Number 682413. Said land lying Walworth County, Wisconsin.

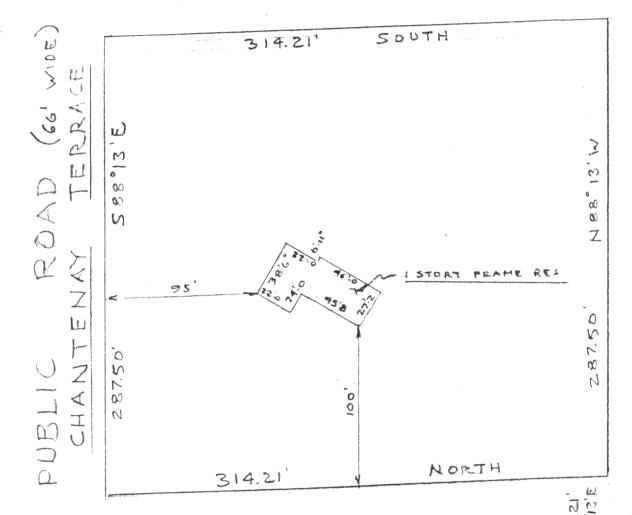

Monumentation has been waived in accordance with &.E. 5.01(b) of the Wisconsin Administrative Code.



1 NO1" 12 30"E 900

SEC 12, T3N, RIGE WALWORTH COUNTY

State of Wisconsin County of Racine

I hereby certify that I have surveyed the property described above according to official records and that the plat above drawn is a correct representation of said survey and shows the size and location of the property, it's exterior boundaries, the location and dimensions of all visable structures thereon, fonces, apparent easements roadways and visible encreachments. This survey is made for the exclusive use of the present owners of the property; also those who purchase, mortgage or guarantee the title thereto, within one year of date hereof.

Scale .....

Racine, Wis. 3 / 12 , 19 84

6-804A