
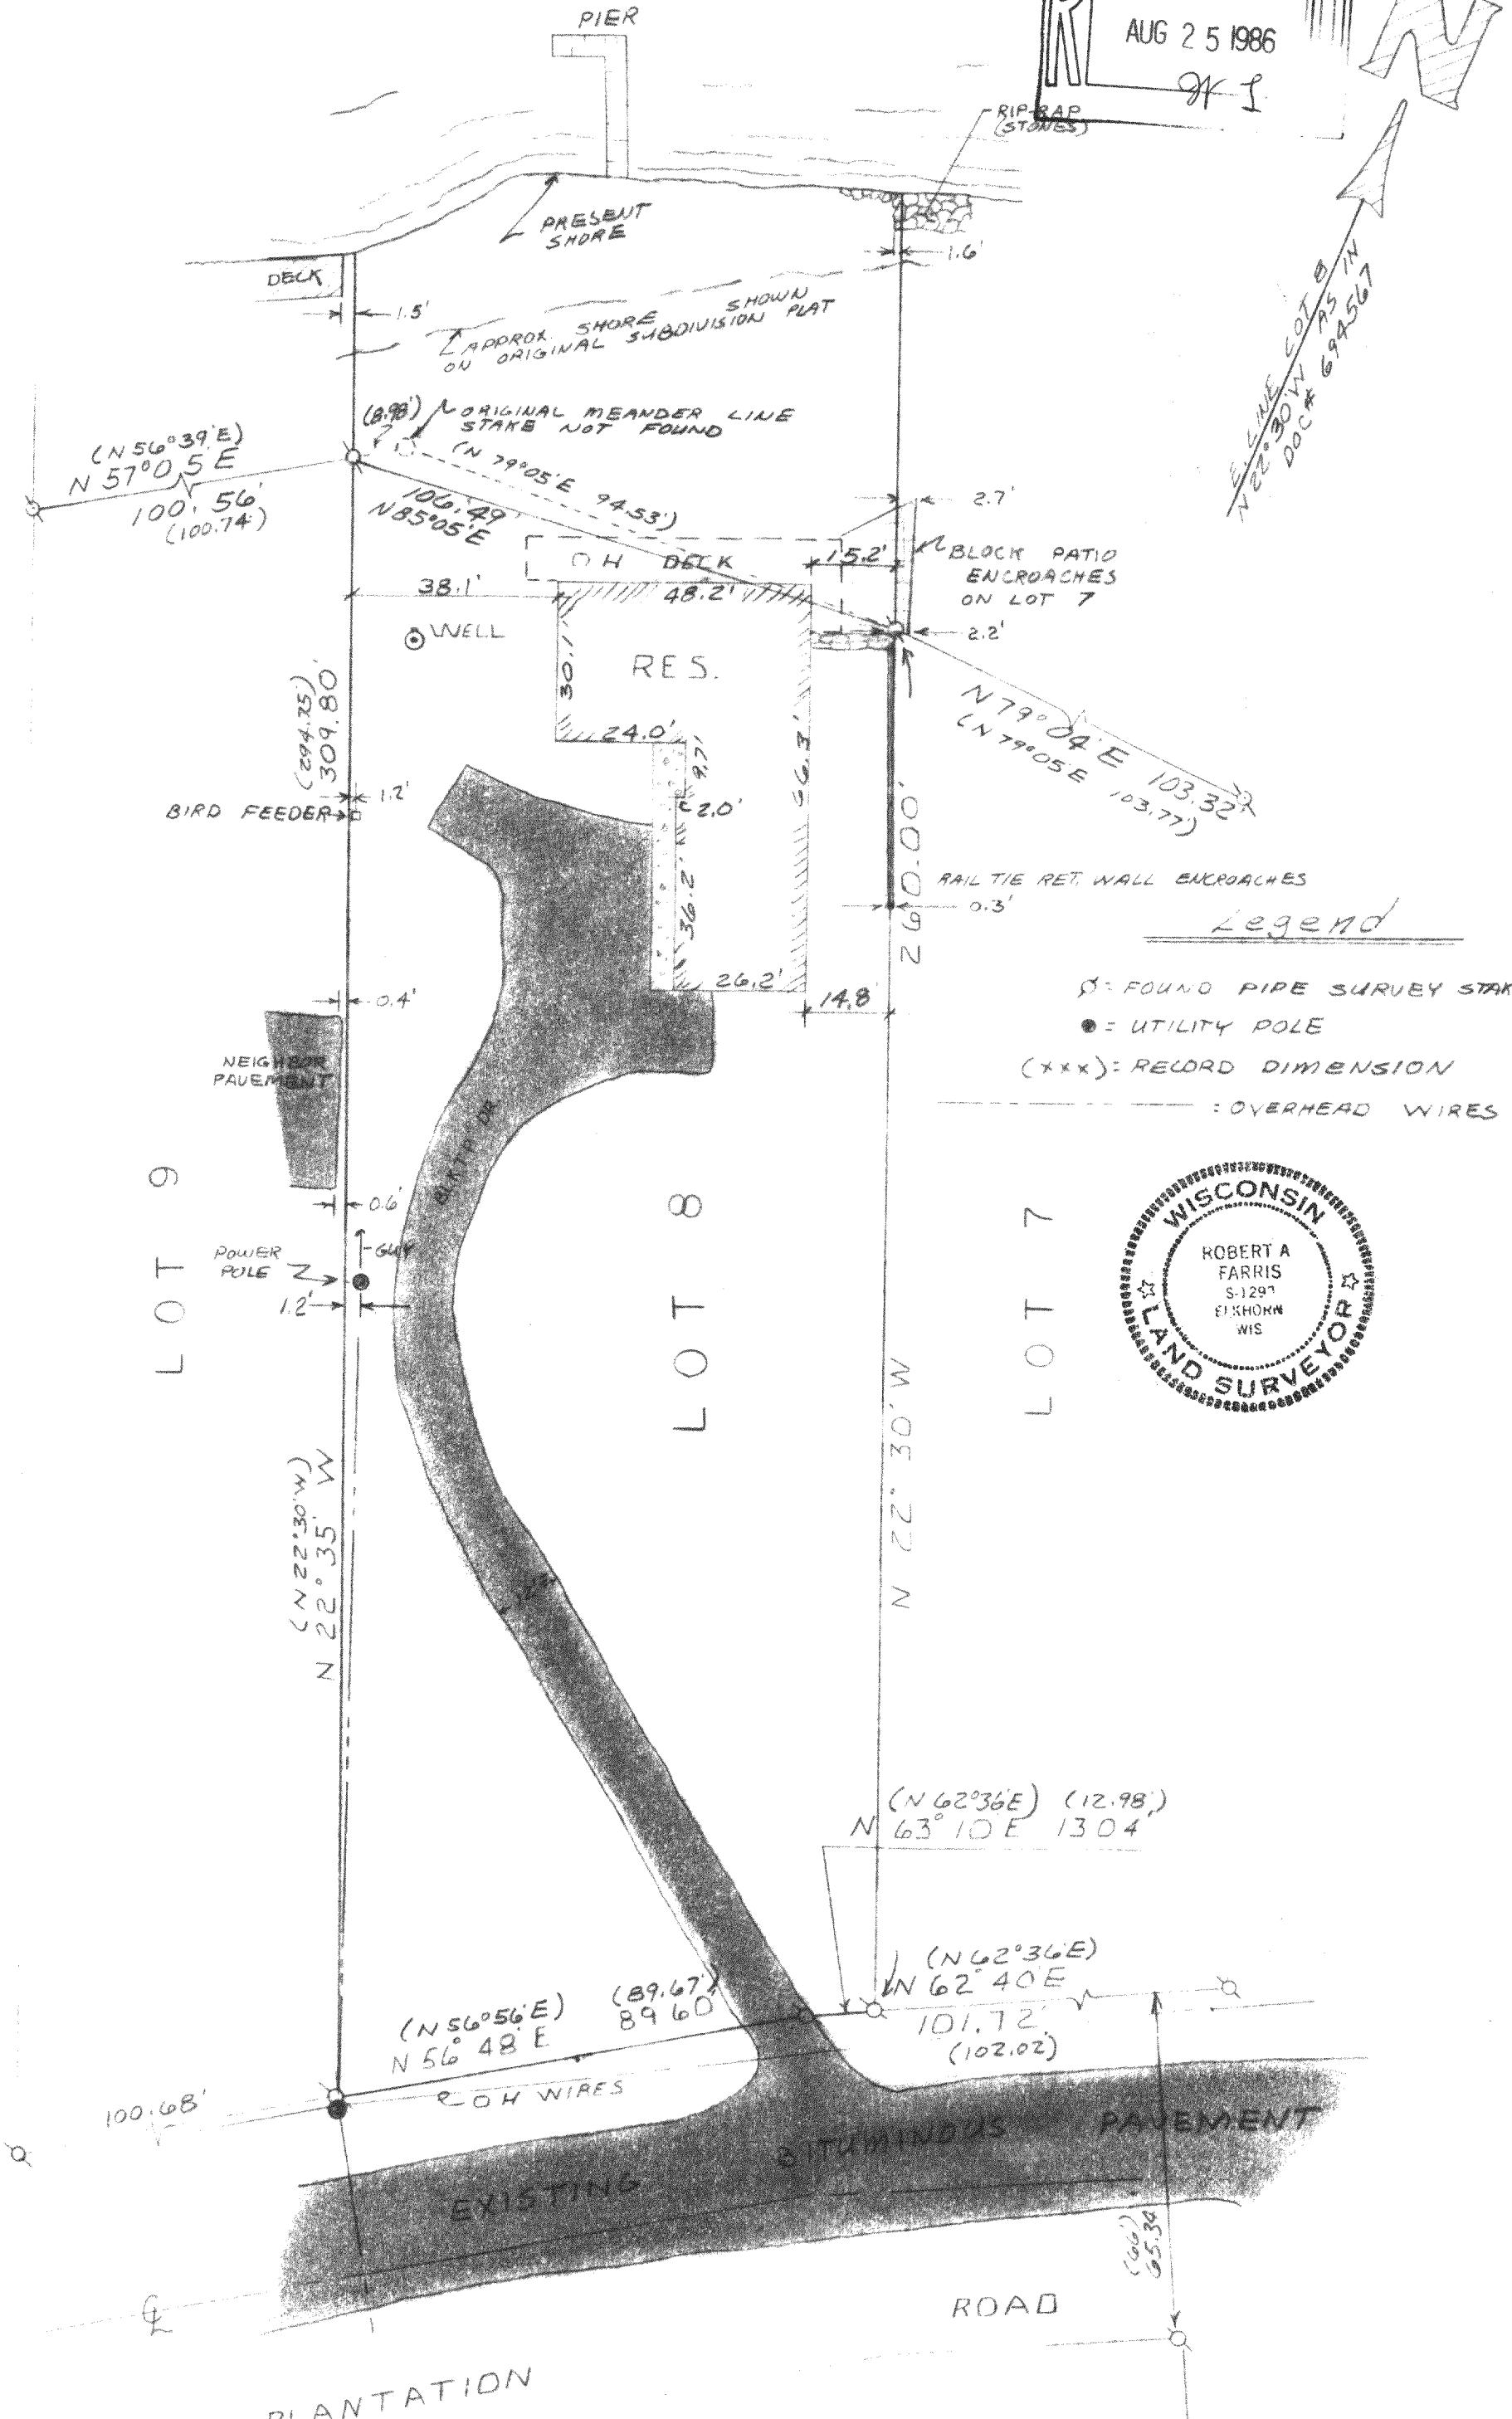


- PLAT OF SURVEY -

LOT 8 BAYWOOD ESTATES SUBDIVISION WALWORTH COUNTY, WISCONSIN
AS AMENDED BY DOC. # 694567 VOL. 140, P32B WAL. CO. RECORDS

LAUDERDALE

LAKE

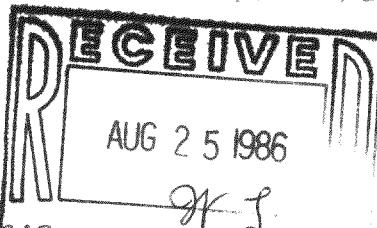

WORK ORDERED BY THOMAS MEYER FOR ROBERT WELLMAN

I hereby certify that the above described property has been surveyed under my direction and that the above map is a true representation thereof and shows the size and location of the property, its exterior boundaries, the location of all visible structures and dimensions of all principal buildings thereon, boundary fences, apparent easements, roadways and visible encroachments, if any. This survey is made for the use of the present owners of the property, and also for those who purchase, mortgage, or guarantee the title thereto within one (1) year from the date hereof.

Robert A. Farris, R.L.S.

Dated this 14th day of July, 1986

PROJECT NO. 2614

G-BE-8