
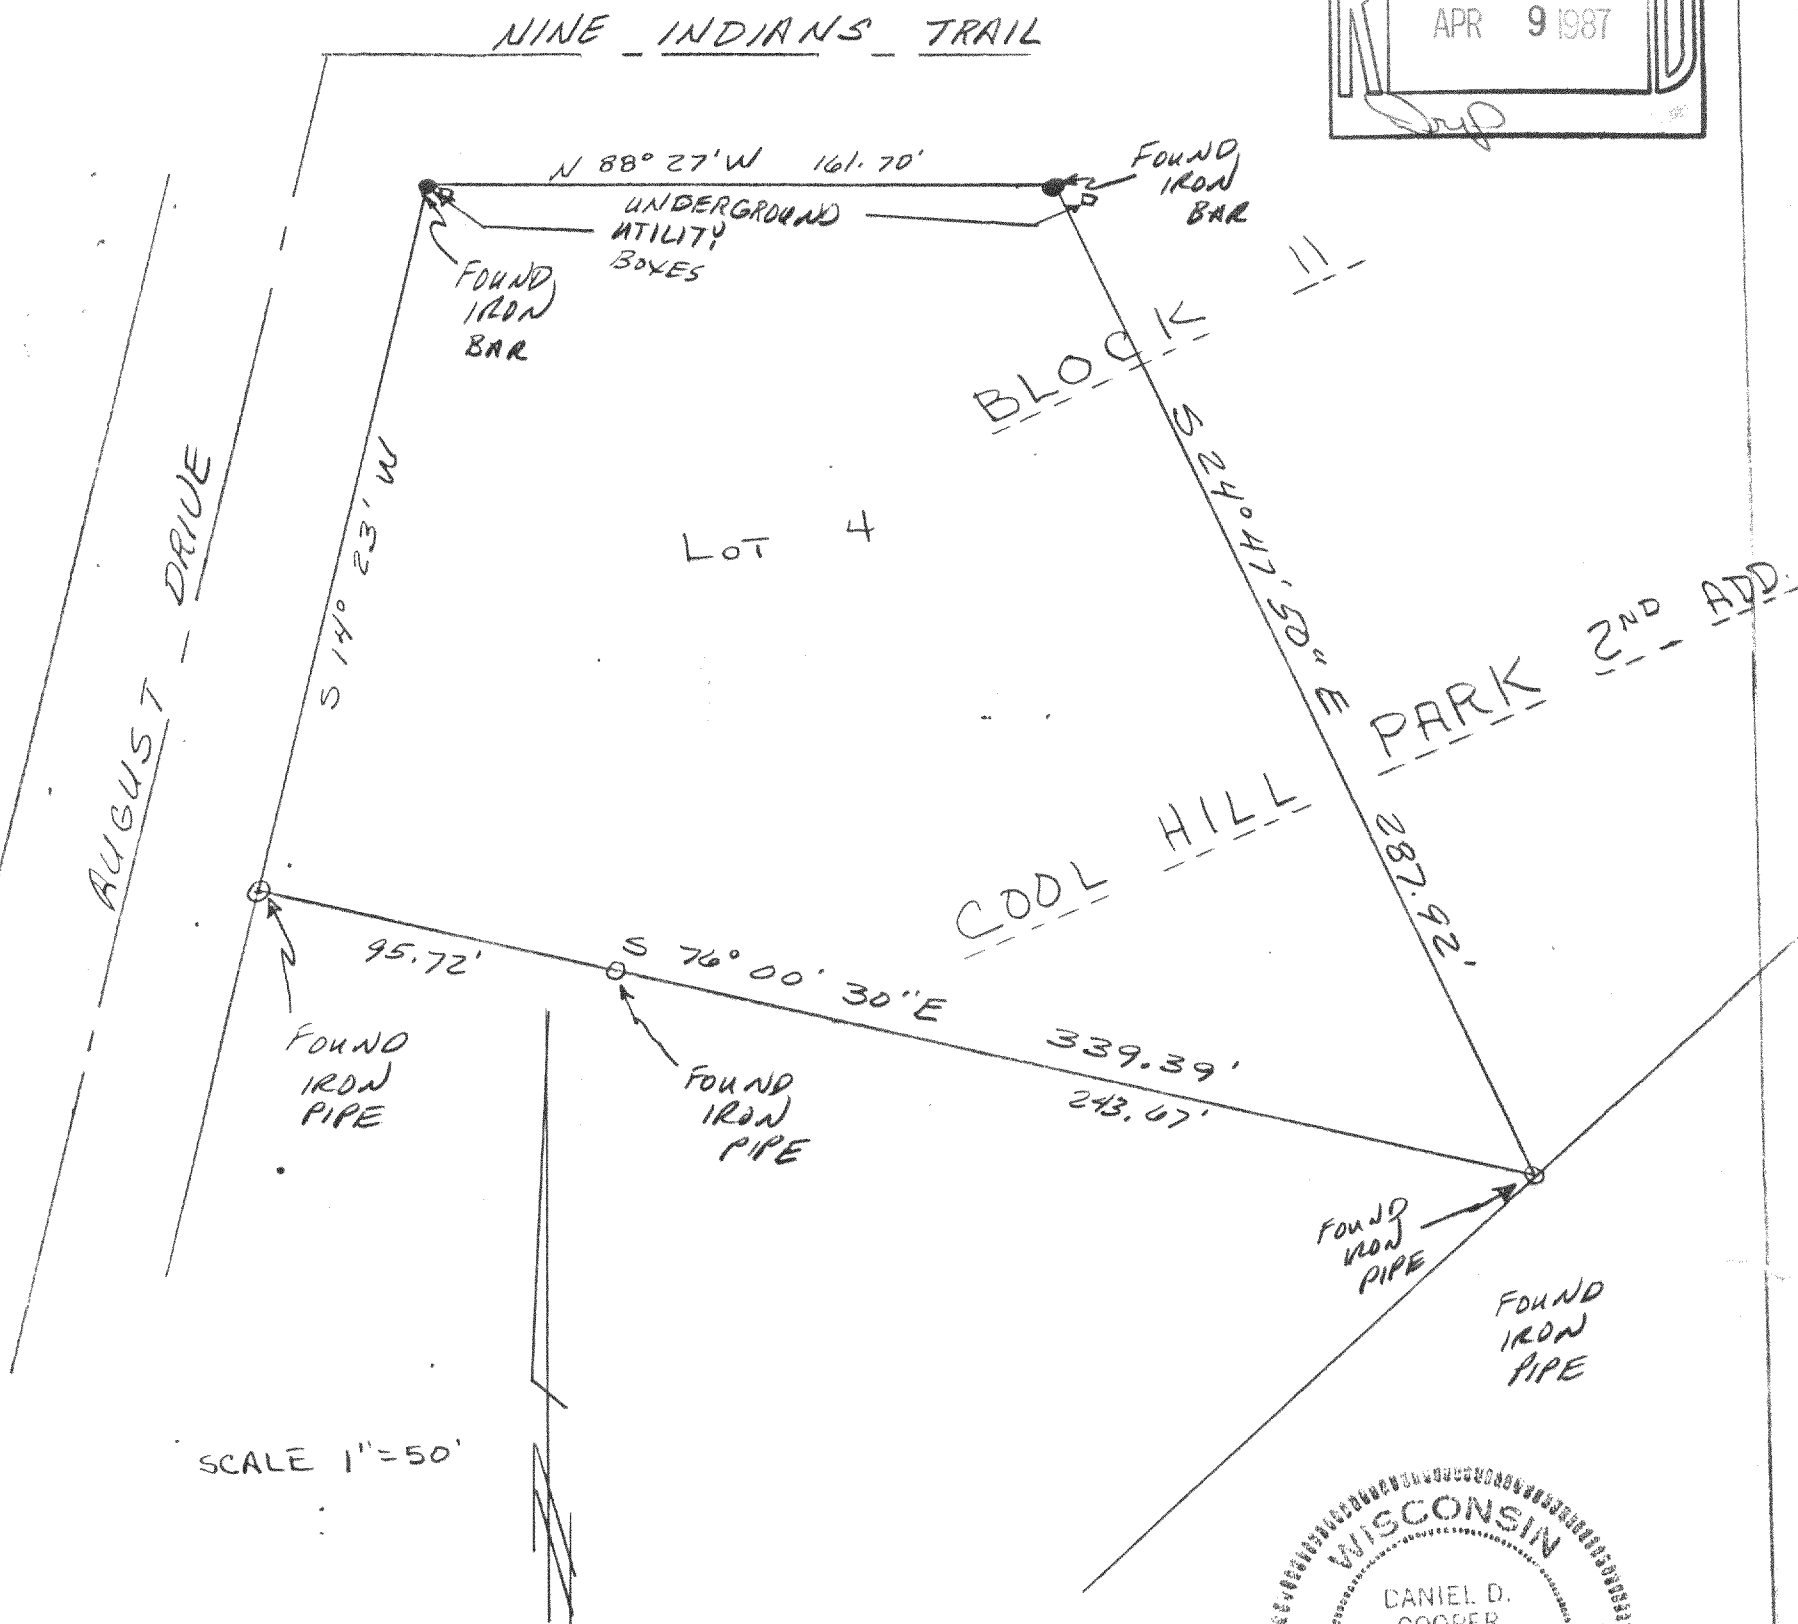


D. D. COOPER & CO., INC.
Daniel D. Cooper
Rt. 4 Box 5088
Elkhorn, WI 53121

Bearing reference: Southerly line of
Nine Indians Trail Assumed to bear
N 88° 27' W

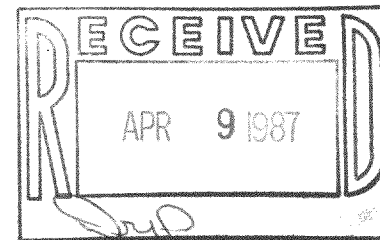

Plat of Survey of Lot 4 Block 11 Cool Hill Park 2nd Addition
located in the Town of Sugar Creek, Walworth County Wisconsin

I hereby Certify that I have surveyed the property described hereon and
that the above map is a true and accurate representation thereof to the
best of my professional knowledge and belief.

Dated this 26 day of Feb., 1987

Daniel D. Cooper
Daniel D. Cooper, RLS No. S-1464

Survey ordered by Century 21
Whitewater

