



ABELL  
SURVEYING & MAPPING  
DELAVAN, WISCONSIN 53115  
414-728-6737

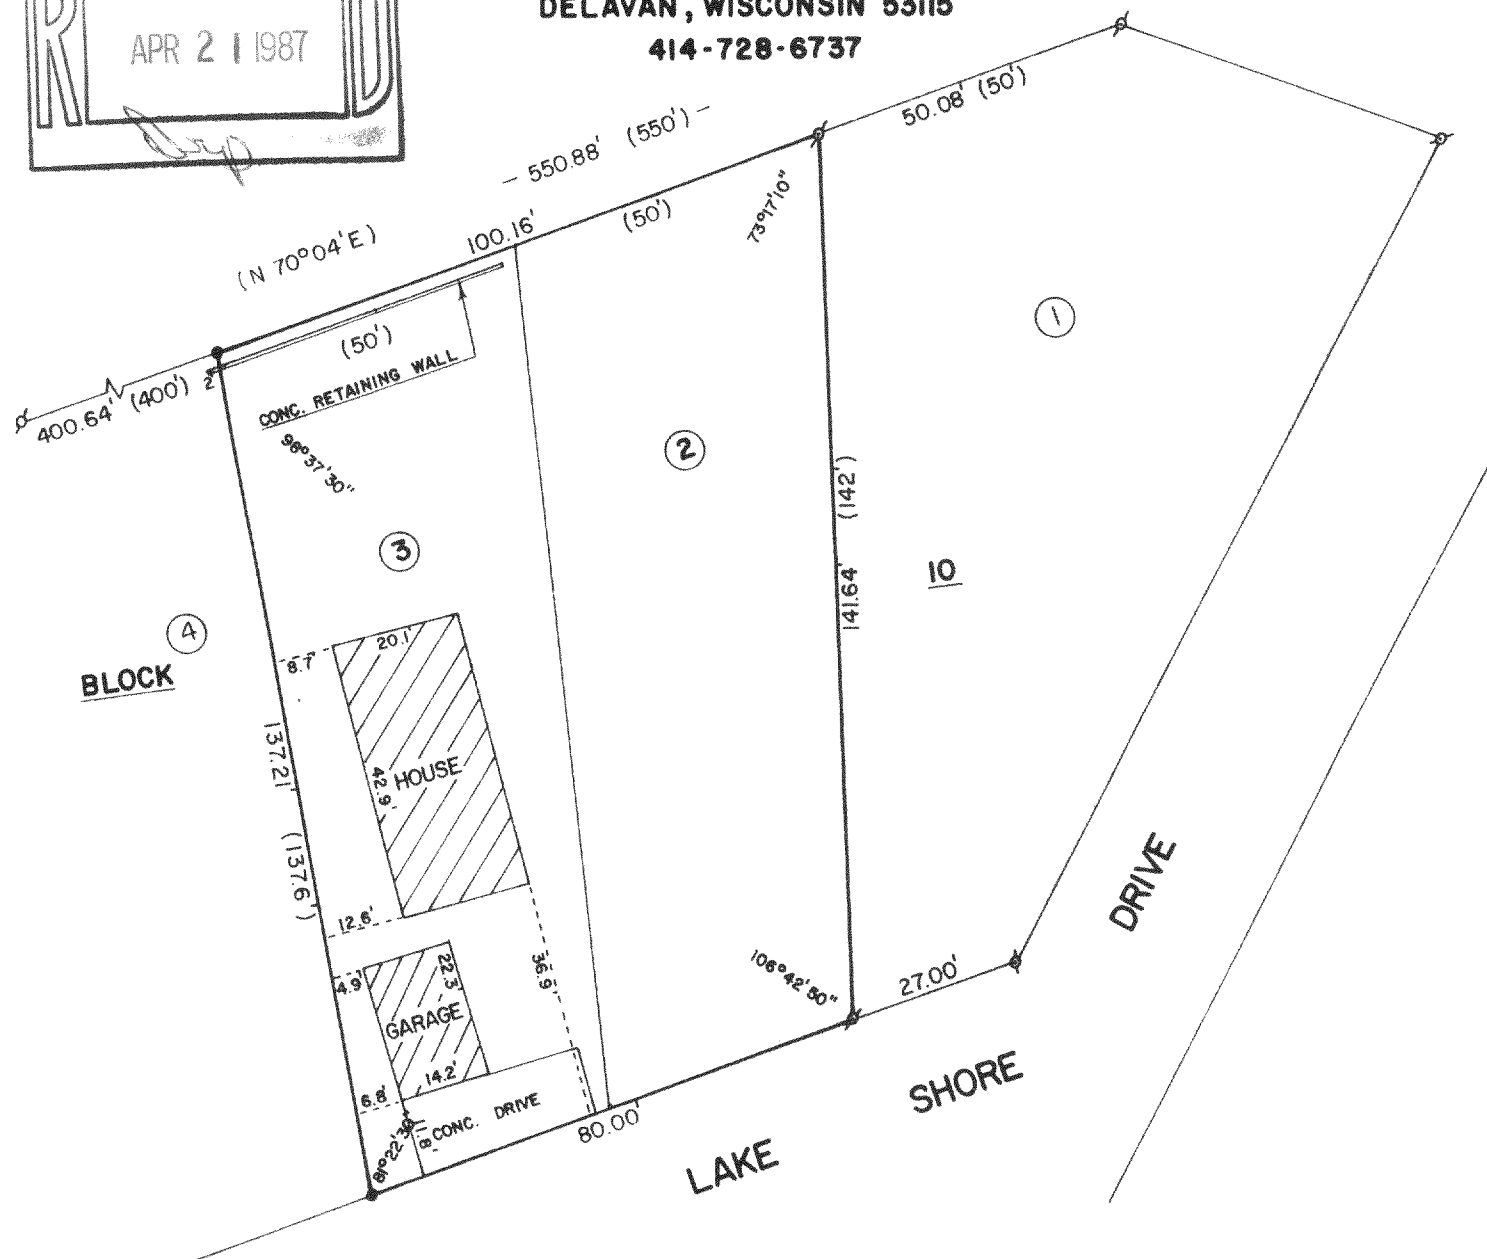

PLAT OF SURVEY OF

LOTS 2 AND 3, BLOCK 10, BLUE WING ESTATES,  
T3N,R16E, WALWORTH COUNTY, WISCONSIN.

ORDERED BY: CENTURY 21 - SKANDIA REALTY  
312 S. 7th STREET  
DELAVAN, WISCONSIN 53115

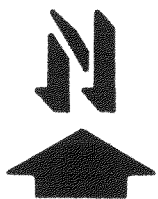

SCALE - 1"=30'

LEGEND

- ∘ - IRON PIPE FOUND
- - 3/4" IRON ROD SET
- ( ) - RECORDED AS


I, DAVID F. ABELL, DO HEREBY CERTIFY  
THAT I HAVE SURVEYED THE PROPERTY  
HEREON DESCRIBED ACCORDING TO THE  
OFFICIAL RECORDS AND THAT THE PLAT  
HEREON IS A CORRECT REPRESENTATION  
OF THE PROPERTY LINES TO THE BEST OF  
MY KNOWLEDGE AND BELIEF.

*David F. Abell*


DAVID F. ABELL  
WISCONSIN REGISTERED LAND SURVEYOR, S-1596

*March 28, 1987*

DATE JOB NUMBER - 87027  
NOTE: THIS IS NOT A CERTIFIED COPY UNLESS SEALED.

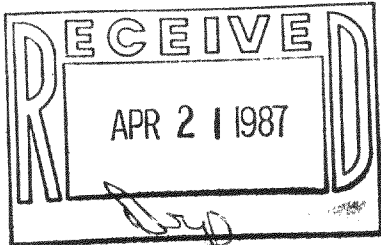


ABELL  
SURVEYING & MAPPING  
DELAVER, WISCONSIN 53115  
414-728-6737

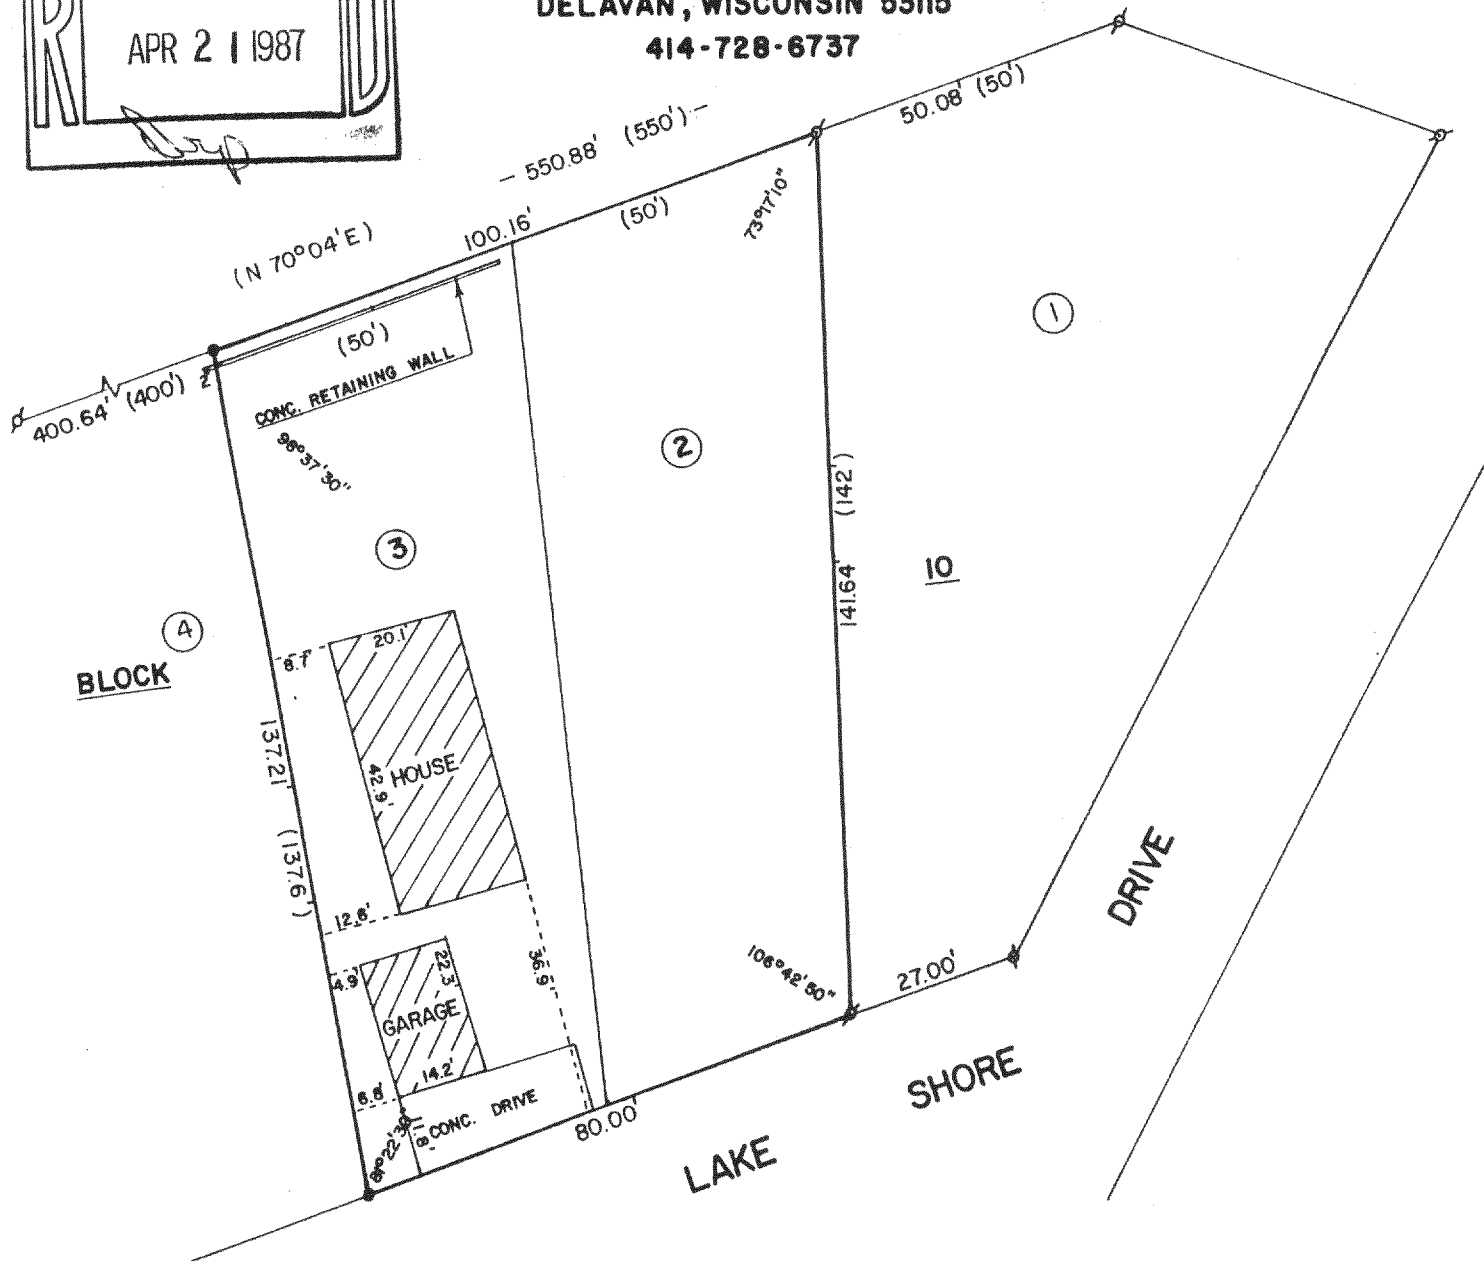

PLAT OF SURVEY OF

LOTS 2 AND 3, BLOCK 10, BLUE WING ESTATES,  
T3N, R16E, WALWORTH COUNTY, WISCONSIN.

ORDERED BY: CENTURY 21 - SKANDIA REALTY  
312 S. 7th STREET  
DELAVER, WISCONSIN 53115

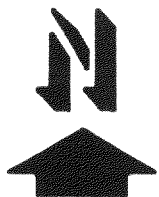

SCALE - 1"=30'

LEGEND

- σ - IRON PIPE FOUND
- - 3/4" IRON ROD SET
- ( ) - RECORDED AS

I, DAVID F. ABELL, DO HEREBY CERTIFY  
THAT I HAVE SURVEYED THE PROPERTY  
HEREON DESCRIBED ACCORDING TO THE  
OFFICIAL RECORDS AND THAT THE PLAT  
HEREON IS A CORRECT REPRESENTATION  
OF THE PROPERTY LINES TO THE BEST OF  
MY KNOWLEDGE AND BELIEF.

*David F. Abell*  
DAVID F. ABELL  
WISCONSIN REGISTERED LAND SURVEYOR, S-1596

*March 28, 1987*  
DATE JOB NUMBER - 87027  
NOTE: THIS IS NOT A CERTIFIED COPY UNLESS SEALED.