



ABELL  
SURVEYING & MAPPING  
DELAVAN, WISCONSIN 53115  
414-728-6737

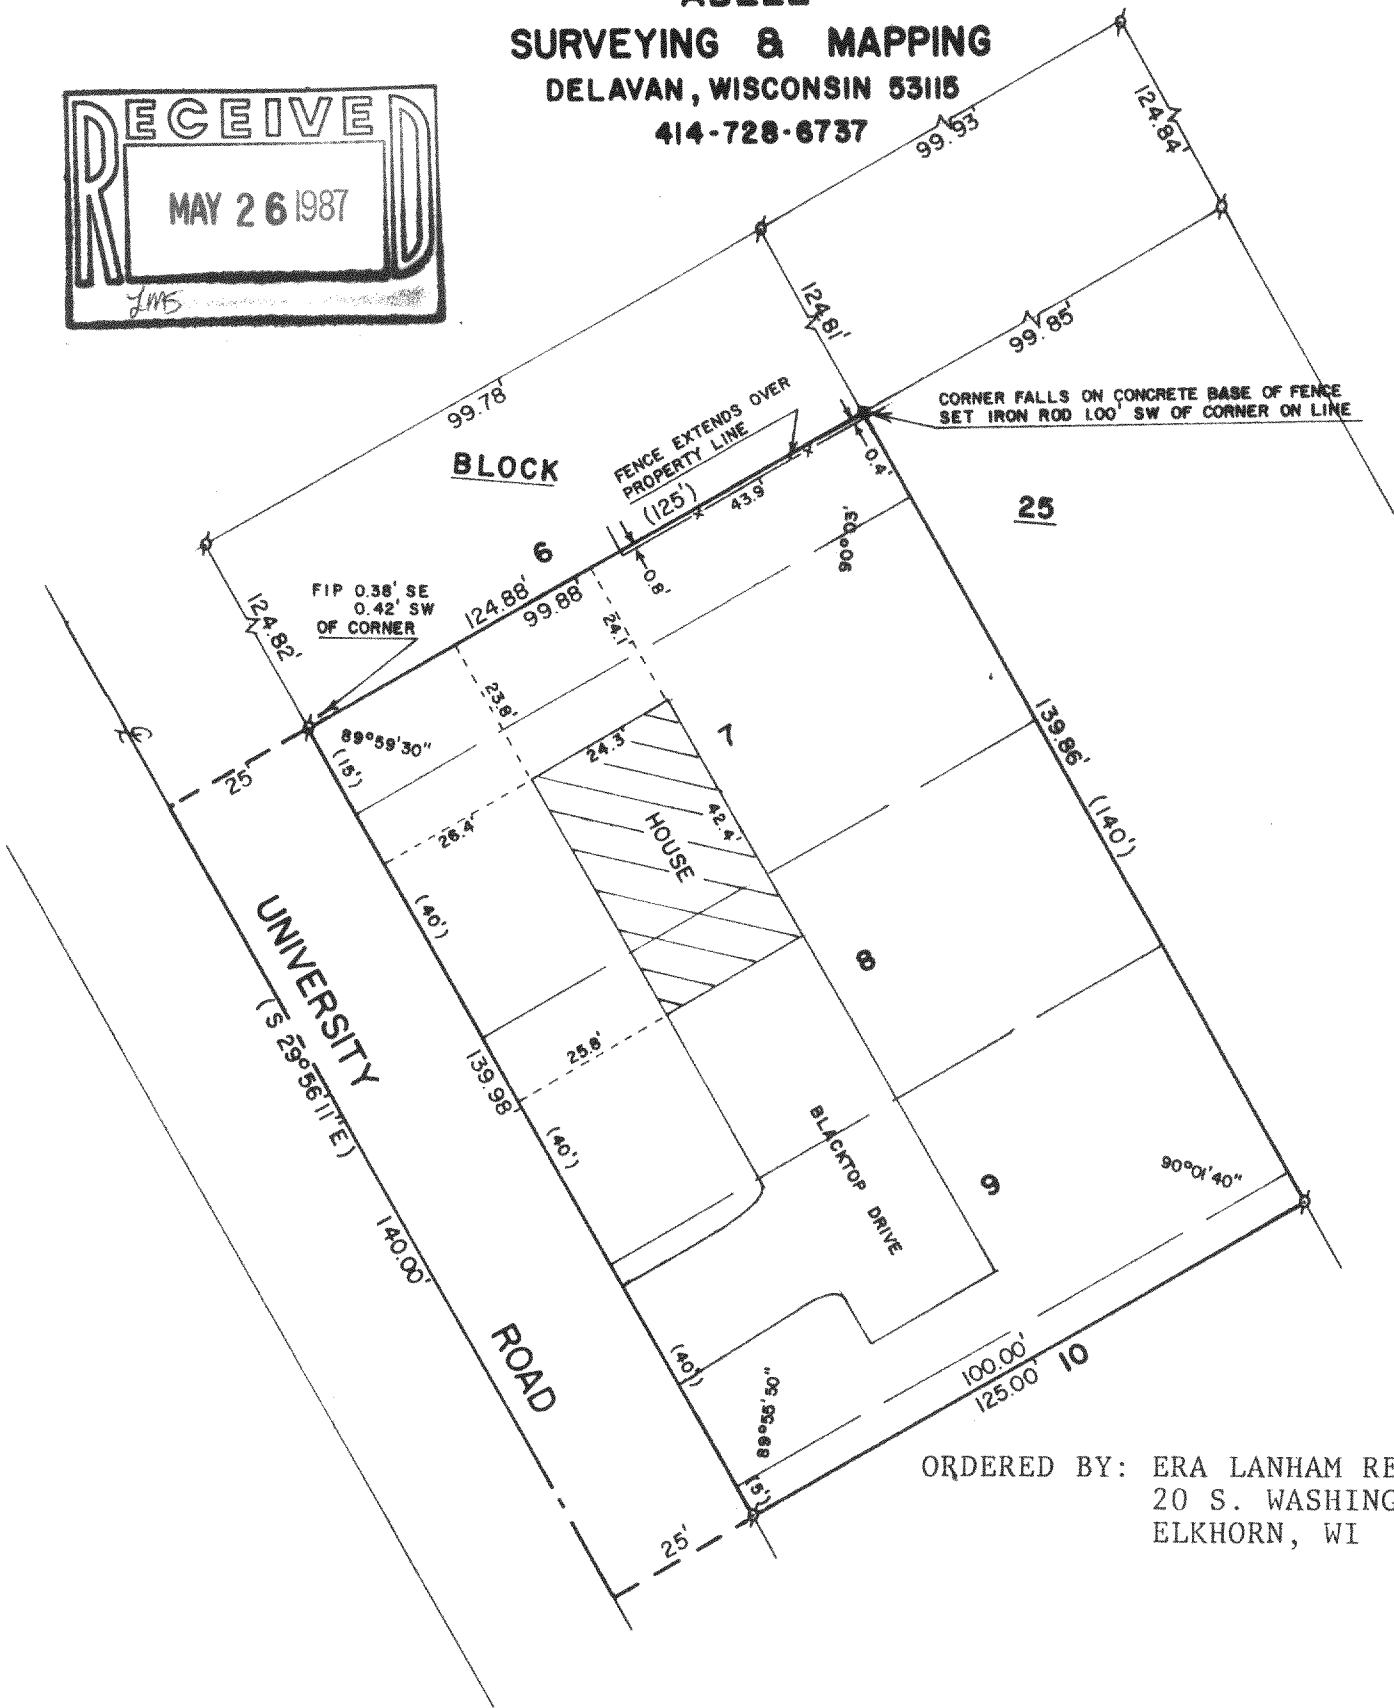

ORDERED BY: ERA LANHAM REALTY  
20 S. WASHINGTON  
ELKHORN, WI 53121

PLAT OF SURVEY OF

THE SOUTHERLY 15 FEET OF LOT 6, LOTS 7-9, AND  
THE NORTHERLY 5 FEET OF LOT 10, BLOCK 25 OF THE  
THIRD MAP OF INTERLAKEN, T3N,R16E, WALWORTH  
COUNTY, WISCONSIN.

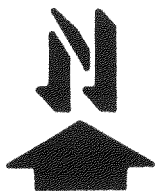

SCALE - 1"=30'

LEGEND

- ⊘ - IRON PIPE FOUND
- - IRON ROD SET
- ( ) - RECORDED AS

I, DAVID F. ABELL, DO HEREBY CERTIFY  
THAT I HAVE SURVEYED THE PROPERTY  
HEREON DESCRIBED ACCORDING TO THE  
OFFICIAL RECORDS AND THAT THE PLAT  
HEREON IS A CORRECT REPRESENTATION  
OF THE PROPERTY LINES TO THE BEST OF  
MY KNOWLEDGE AND BELIEF.

*David F. Abell*

DAVID F. ABELL  
WISCONSIN REGISTERED LAND SURVEYOR, S-1596

*April 16, 1987*  
DATE JOB NUMBER - 87037

NOTE: THIS IS NOT A CERTIFIED COPY UNLESS SEALED.