

ABELL SURVEYING & MAPPING DELAVAN, WISCONSIN 53115 414-728-6737

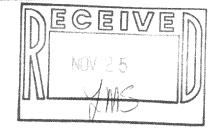

LANE

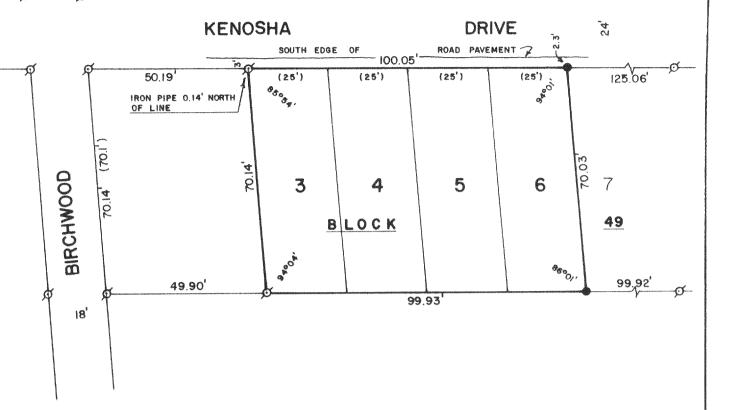

PLAT OF SURVEY OF

LOTS 3-6, BLOCK 49, LAKE WANDAWEGA SUBDIVISION, T3N, R16, WALWORTH COUNTY, WISCONSIN.

ORDERED BY:

CENTURY 21 - WALTON REALTY

704 N. LINCOLN

ELKHORN, WI. 53121



SCALE - 1"=30'

LEGEND

Ø - IRON PIPE FOUND

• - 3/4" DIA. IRON ROD SET ()- RECORDED AS

I, DAVID F. ABELL, DO HEREBY CERTIFY THAT I HAVE SURVEYED THE PROPERTY HEREON DESCRIBED ACCORDING TO THE OFFICIAL RECORDS AND THAT THE PLAT HEREON IS A CORRECT REPRESENTATION OF THE PROPERTY LINES TO THE BEST OF MY KNOWLEDGE AND BELIEF.

David 7. abell
DAVID F. ABELL

WISCONSIN REGISTERED LAND SURVEYOR, S-1596

.30 /987 JOB NUMBER - 87153

NOTE: THIS IS NOT A CERTIFIED COPY UNLESS SEALED.