



**ABELL**  
**SURVEYING & MAPPING**  
 DELAVAN, WISCONSIN 53115  
 414-728-6737

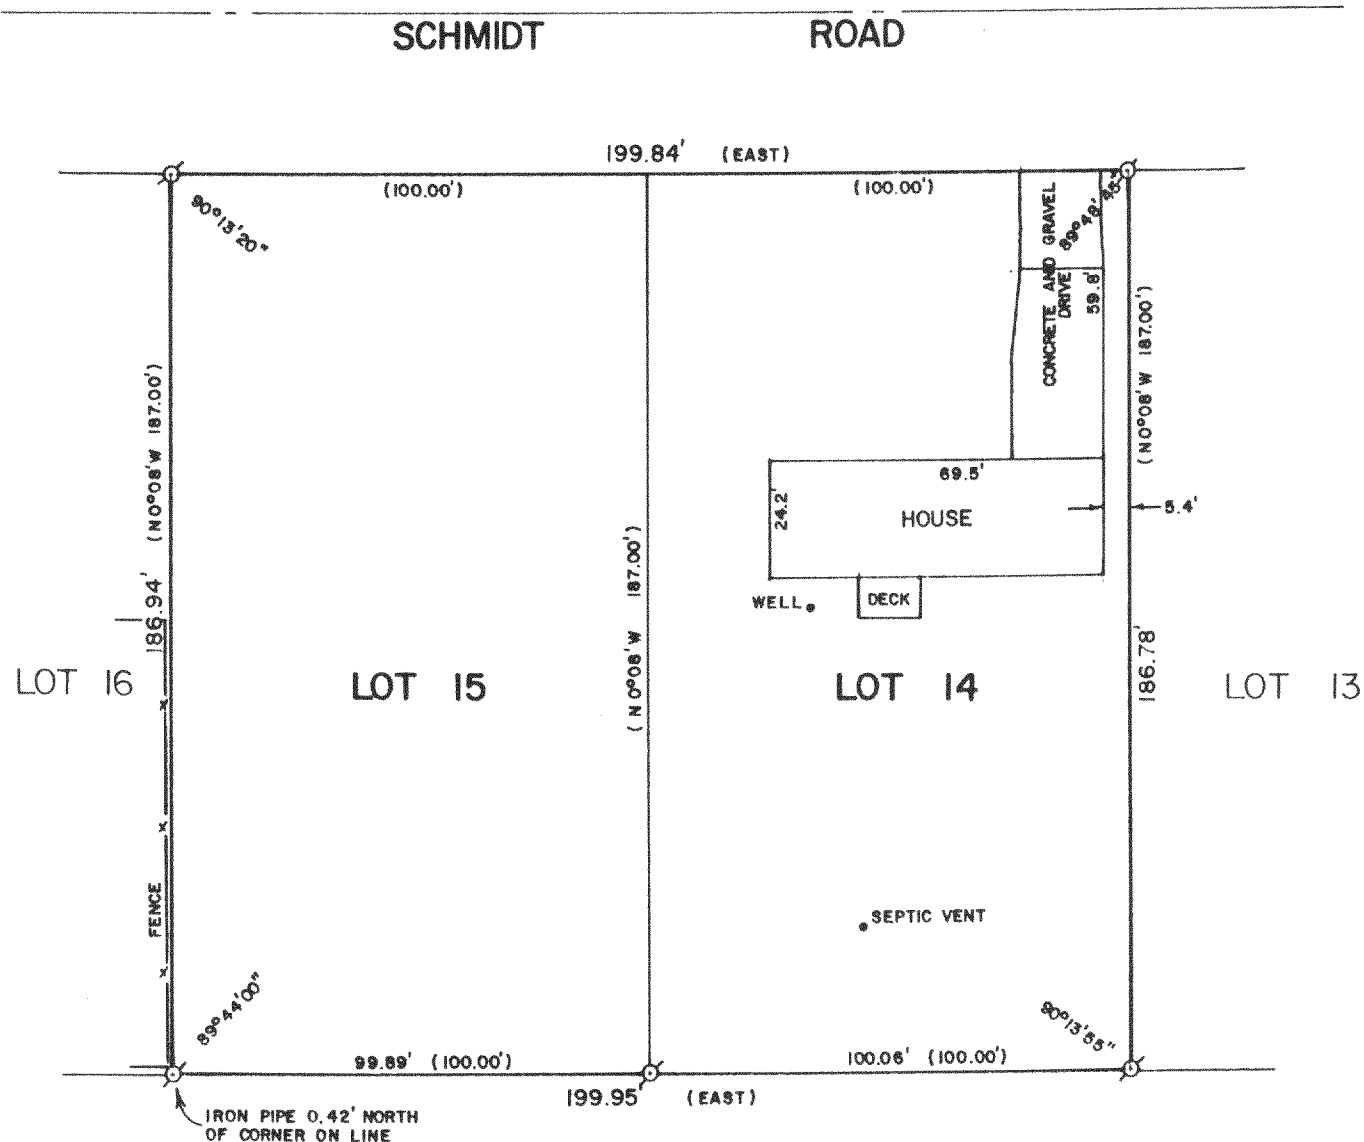

PLAT OF SURVEY OF

LOTS 14 AND 15 OF TWIN HEIGHTS ESTATES SUBDIVISION, LOCATED  
 IN SECTION 23, T3N,R16E, WALWORTH COUNTY, WISCONSIN.

ORDERED BY: CENTURY 21 - WALTON REALTY  
 704 N. LINCOLN  
 ELKHORN, WI. 53121

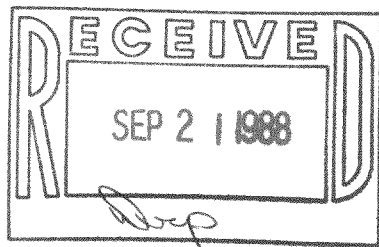

SCALE - 1"=40'

**LEGEND**  
 ∅ - IRON PIPE FOUND  
 ( ) - RECORDED AS

I, DAVID F. ABELL, DO HEREBY CERTIFY  
 THAT I HAVE SURVEYED THE PROPERTY  
 HEREON DESCRIBED ACCORDING TO THE  
 OFFICIAL RECORDS AND THAT THE PLAT  
 HEREON IS A CORRECT REPRESENTATION  
 OF THE PROPERTY LINES TO THE BEST OF  
 MY KNOWLEDGE AND BELIEF.

*David F. Abell*

DAVID F. ABELL  
 WISCONSIN REGISTERED LAND SURVEYOR, S-1596

DATE *July 30, 1988*

JOB NUMBER - 88161

NOTE: THIS IS NOT A CERTIFIED COPY UNLESS SEALED.