
ABERNATHY and ASSOCIATES Kenneth B. Abernathy Jr.

Wisconsin Registered Land Surveyor S-1594

Rt. 3, Box 273 Elkhorn, Wisconsin 53121 Phone: (414) 723-4260 (office) (414) 723-4813 (residence)

PLAT OF SURVEY

Lot 5 of Block 11 of COOL HILL PARK ADDITION NO. 2 located in Section 3 , Town 3 North, Range 16 East, Town of Surgar Creek, Walworth County, Wisconsin.

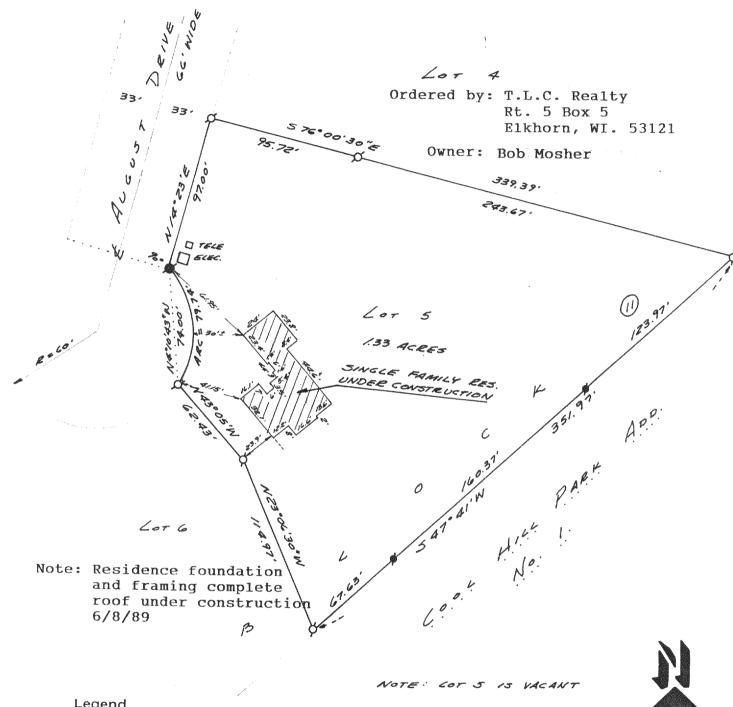

Legend

FOUND IRON PIPE

FOUND IRON ROD

FOUND BRASS CAPPED MONUMENT

FOUND CONCRETE MONUMENT

CHISEL CUT IN CONCRETE

SET IRON ROD, 24" LONG, WEIGHING 1.5 LBS./LINEAL FT., 3/4" DIA.

SET IRON ROD, 30" LONG, WEIGHING 4.5 LBS./LINEAL FT., 1-11/16" DIA.

RECORDED AS DIMENSION

EXISTING FENCE

BGEIVE

JUN 2 6 1989

WASION CONCUM KENNETH B. ABERNATHY, JR. S-1594 ELKHORN, AND SURVE WAND SURVE

SCALE: 1"= 60 FEET

"I hereby certify that I have surveyed the above described property and that the above map is a true representation thereof and shows the size and location of the property, its exterior boundaries, the location of all visible structures and dimensions of all principal buildings thereon, boundary fences, apparent easements, roadways and visible encroachments, if any."

"This survey is made for the use of the present owners of the property, and also those who purchase, mortgage, or guarantee the title thereto within one year from date hereof."

KENNETH B. ABERNATHY, JR.

WISCONSIN REGISTERED LAND SURVEYOR,

12/30/88 Date:_ Job No._ "AS BUILT LOCATION"