


Reduced

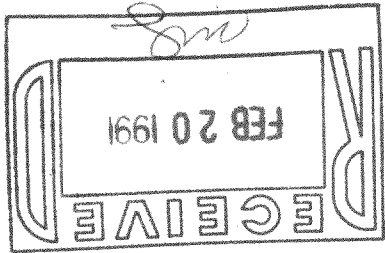

TAX KEY # GI 00287


316-484

D. Cooper & CO., INC
Rt 4 Box 508B * Elkhorn WI 53121

Plat of Survey of Lots 11,12,13,
Block 33 Interlaken 3rd Map, being
located in the Town of Sugar Creek
Walworth County, Wisconsin.

SCALE 1"=20'

Survey ordered by Rick Dugan
Rt 4 Box 367ABC
Elkhorn WI

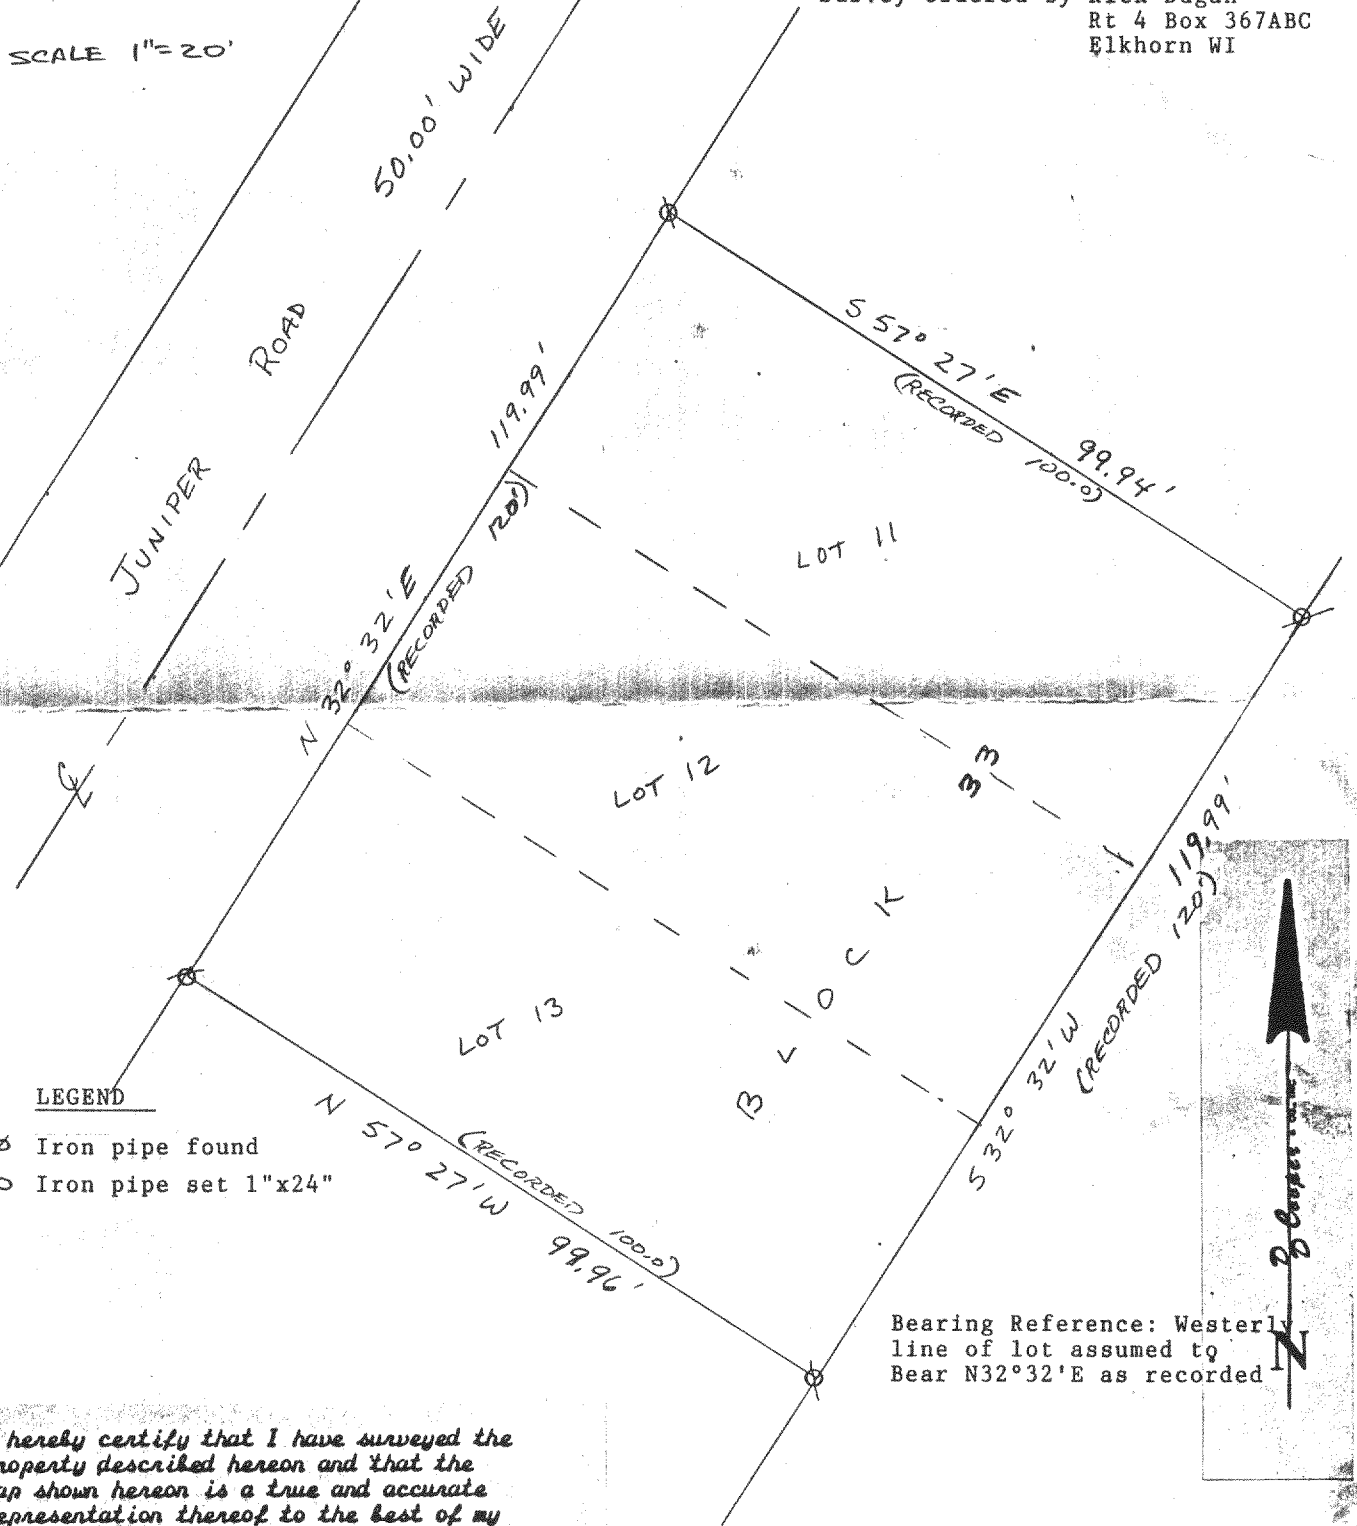

I hereby certify that I have surveyed the
property described hereon and that the
map shown hereon is a true and accurate
representation thereof to the best of my
professional knowledge and belief.

Dated this 4 day of SEPT, 1990

Daniel D. Cooper
Daniel D. Cooper, RLS No. S-1464

316-484

Original Copy only if Sealed in Red Ink