


Reduced

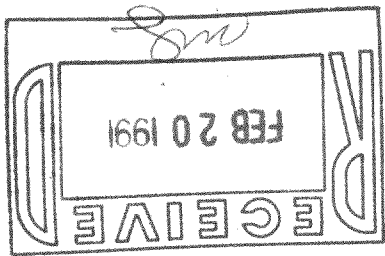

TAX KEY # GI 00287


316-484

D Cooper & CO., INC
Rt 4 Box 508B * Elkhorn WI 53121

Plat of Survey of Lots 11,12,13,
Block 33 Interlaken 3rd Map, being
located in the Town of Sugar Creek
Walworth County, Wisconsin.

Survey ordered by Rick Dugan
Rt 4 Box 367ABC
Elkhorn WI

SCALE 1"=20'

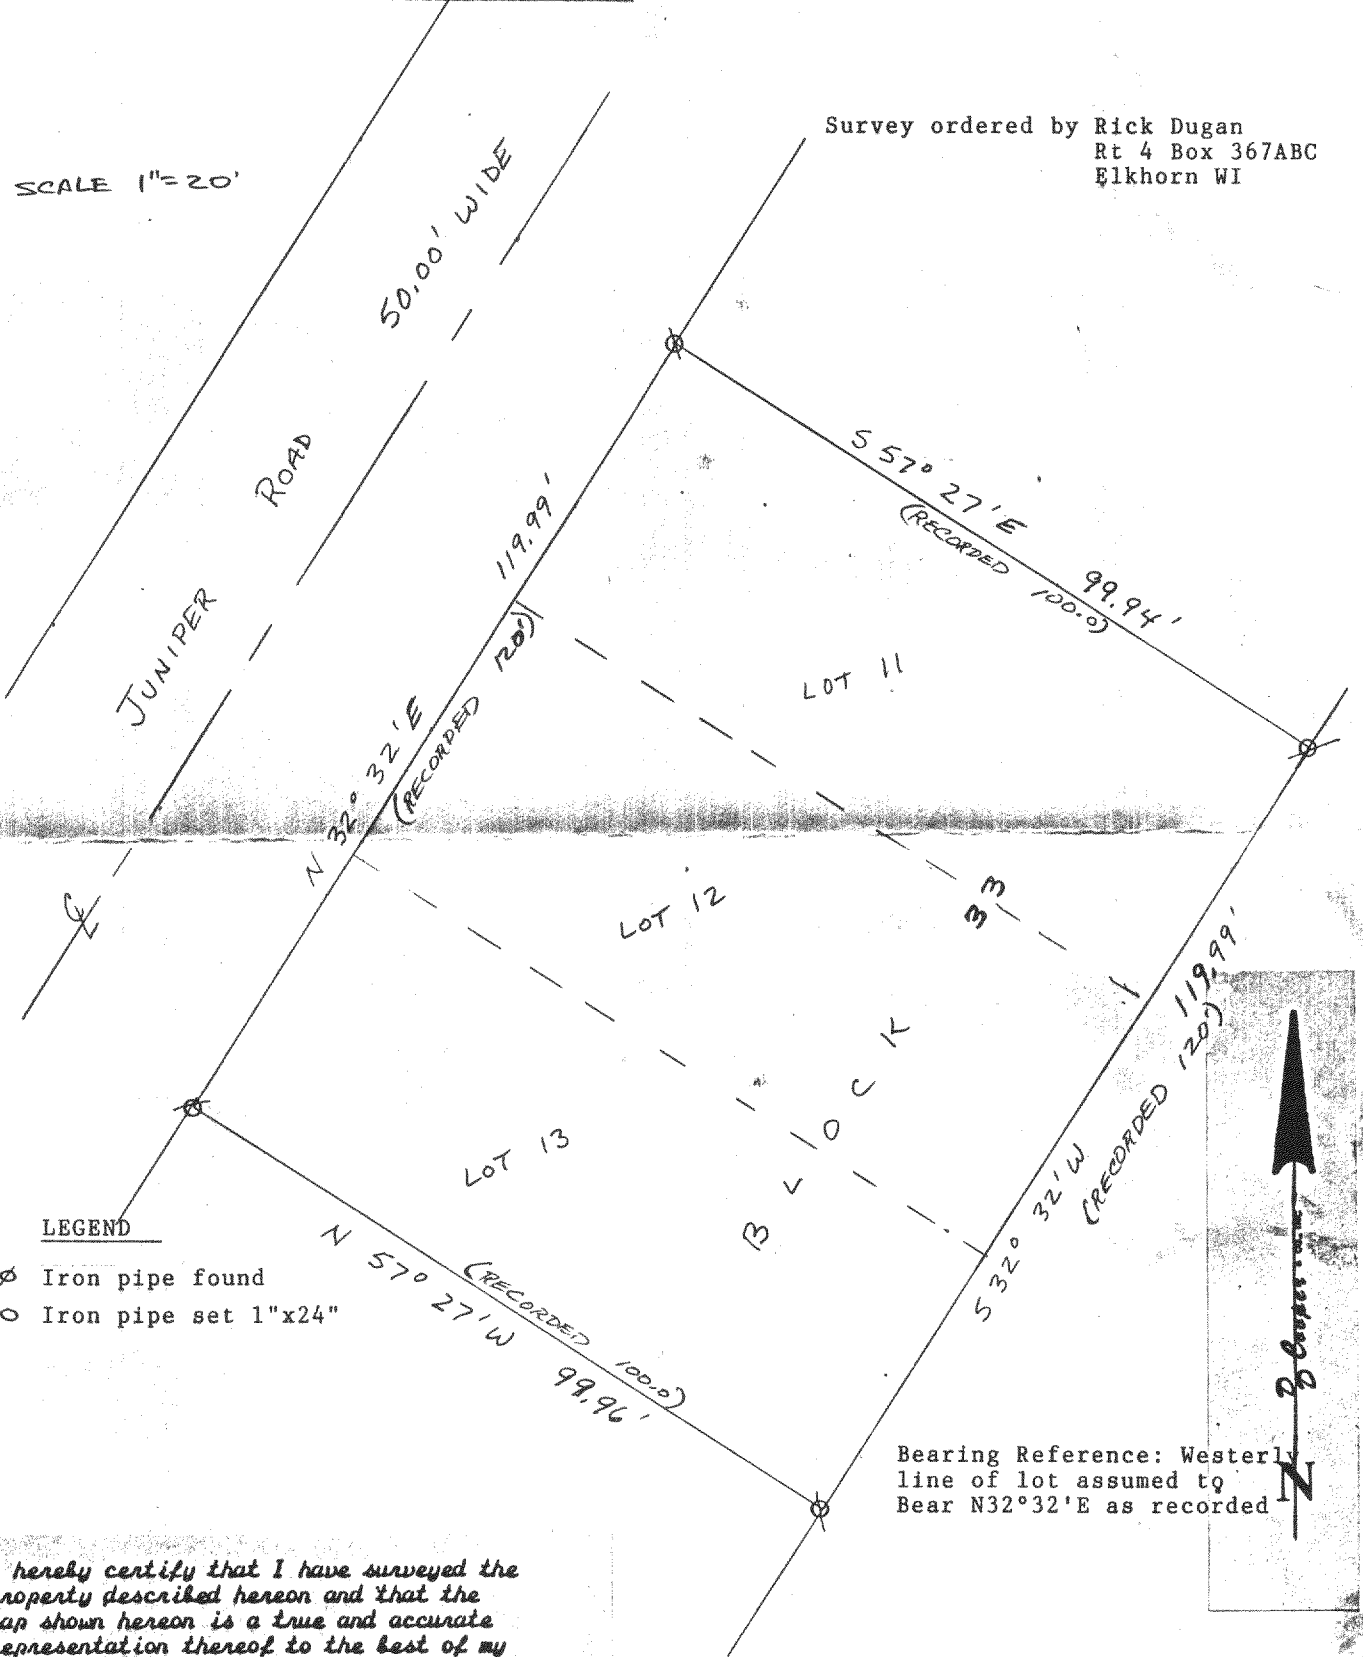

LEGEND

- ⊘ Iron pipe found
- Iron pipe set 1"x24"

Bearing Reference: Westerly
line of lot assumed to
Bear N32°32'E as recorded

I hereby certify that I have surveyed the
property described hereon and that the
map shown hereon is a true and accurate
representation thereof to the best of my
professional knowledge and belief.

Dated this 4 day of SEPT, 1990

Daniel D. Cooper
Daniel D. Cooper, RLS No. S-1464

316-484

Original Copy only if Sealed in Red Ink