


D. D. COOPER, S.S.
Daniel D. Cooper
Rt. 4 Box 508B
Elkhorn, WI 53121

Plat of survey of LOT 17 of Sylvan Trace Subdivision
located in the town of Sugar Creek, Walworth County, WI


SURVEY ORDERED BY TLC REALTY
ELKHORN WI

Bearing Reference: North line of lot assumed to bear N89°52'50"E

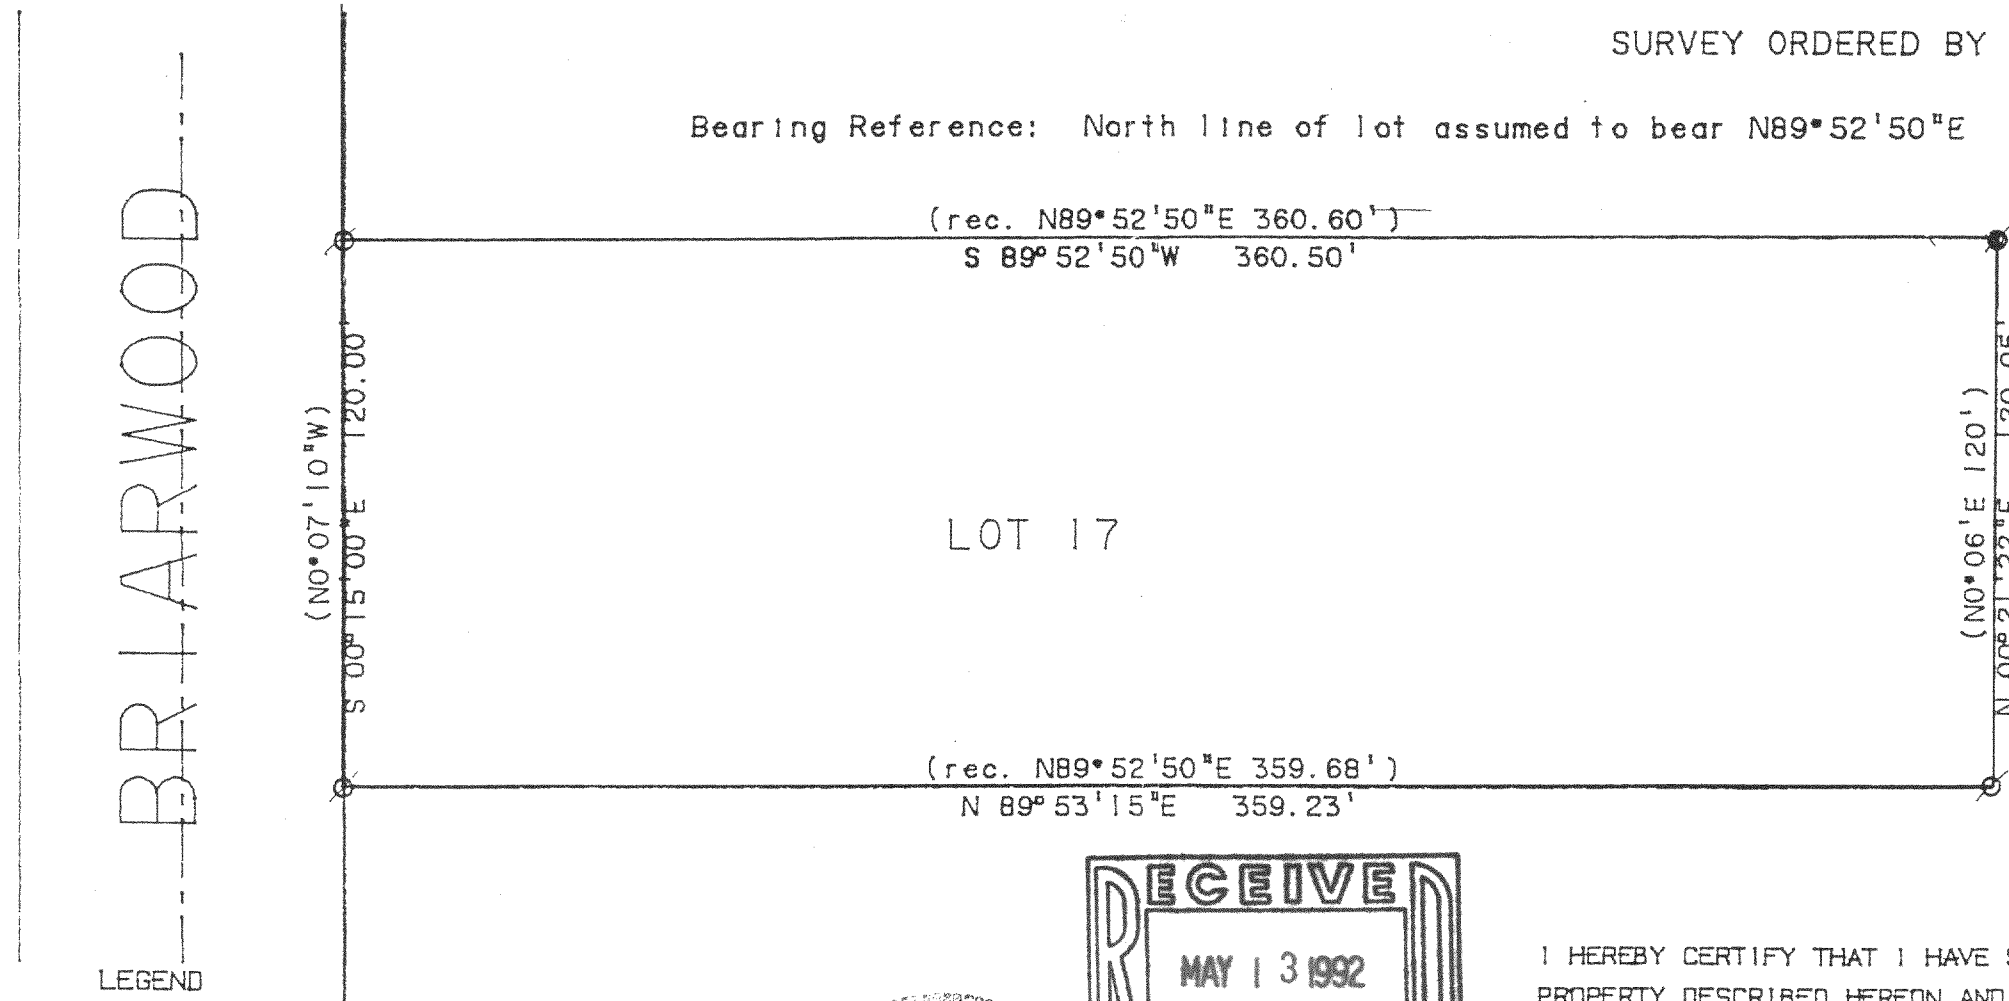

LEGEND

- Ø INDICATES IRON PIPE FOUND
- INDICATES IRON PIPE SET 1"X24"
- INDICATES CROSS CUT IN CONCRETE
- INDICATES CONCRETE MONUMENT
- (XXX) INDICATES RECORDED DISTANCES & BEARINGS
- INDICATES IRON ROD FOUND
- INDICATES IRON ROD SET 3/4"X24"

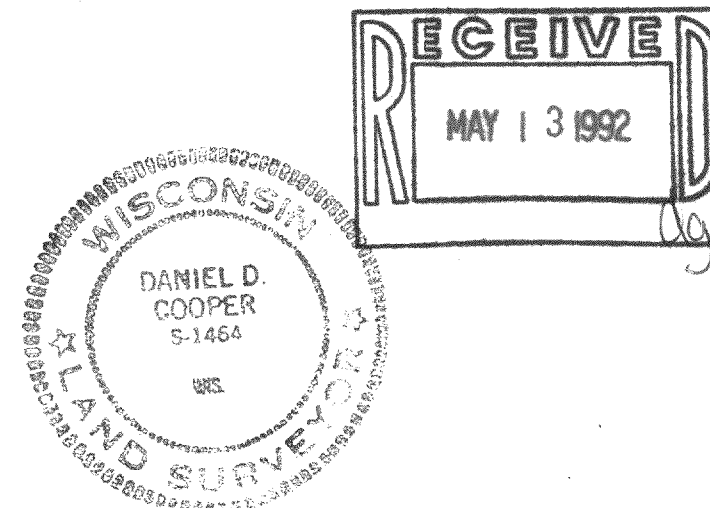

I HEREBY CERTIFY THAT I HAVE SURVEYED THE
PROPERTY DESCRIBED HEREON AND THAT THE
MAP SHOWN HEREON IS A TRUE AND ACCURATE
REPRESENTATION THEREOF TO THE BEST OF MY
PROFESSIONAL KNOWLEDGE AND BELIEF.

DATED THIS 27 DAY OF Nov, 1990

Daniel D. Cooper
DANIEL D. COOPER, RLS NO. S-1464

Drawing No. 3709

316-547

GST-17