

FARRIS, HANSEN & ASSOCIATES, INC.

7 RIDGEWAY COURT, P.O. BOX 437
ELKHORN, WISCONSIN 53121

PHONE: (414) 723-2088
FAX: (414) 723-5888

PROJ. # 3736

LOCATION: & LEGAL DESCRIPTION


LOTS 1-7 & 9-11 BLOCK 46 FOURTH MAP OF INTERLAKEN
TOWN OF SUGAR CREEK SEC. II, T. 3 N, R. 16 E,
WALWORTH COUNTY, WISCONSIN

WORK ORDERED BY: MICHAEL MROCH
ROUTE 4 BOX 348
ELKHORN, WI. 53121

MAP LEGEND

- IRON PIPE STAKE FOUND
- SQUARE IRON BAR IN CONCRETE FOUND
- IRON PIPE IN CONCRETE FOUND
- IRON ROD STAKE SET
- CONCRETE MONUMENT FOUND
- RECORD DIMENSION



(XXXXX)

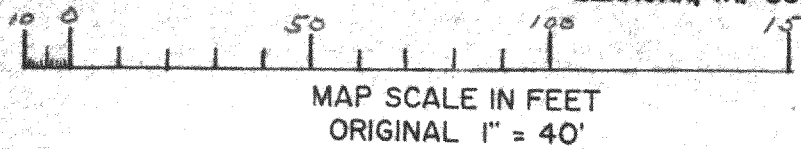

BLOCK 45

(N83°00'20"E)
N82°59'E 201.92'

N00°13'48"W
106.49'

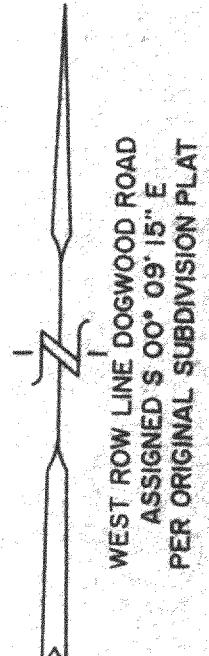
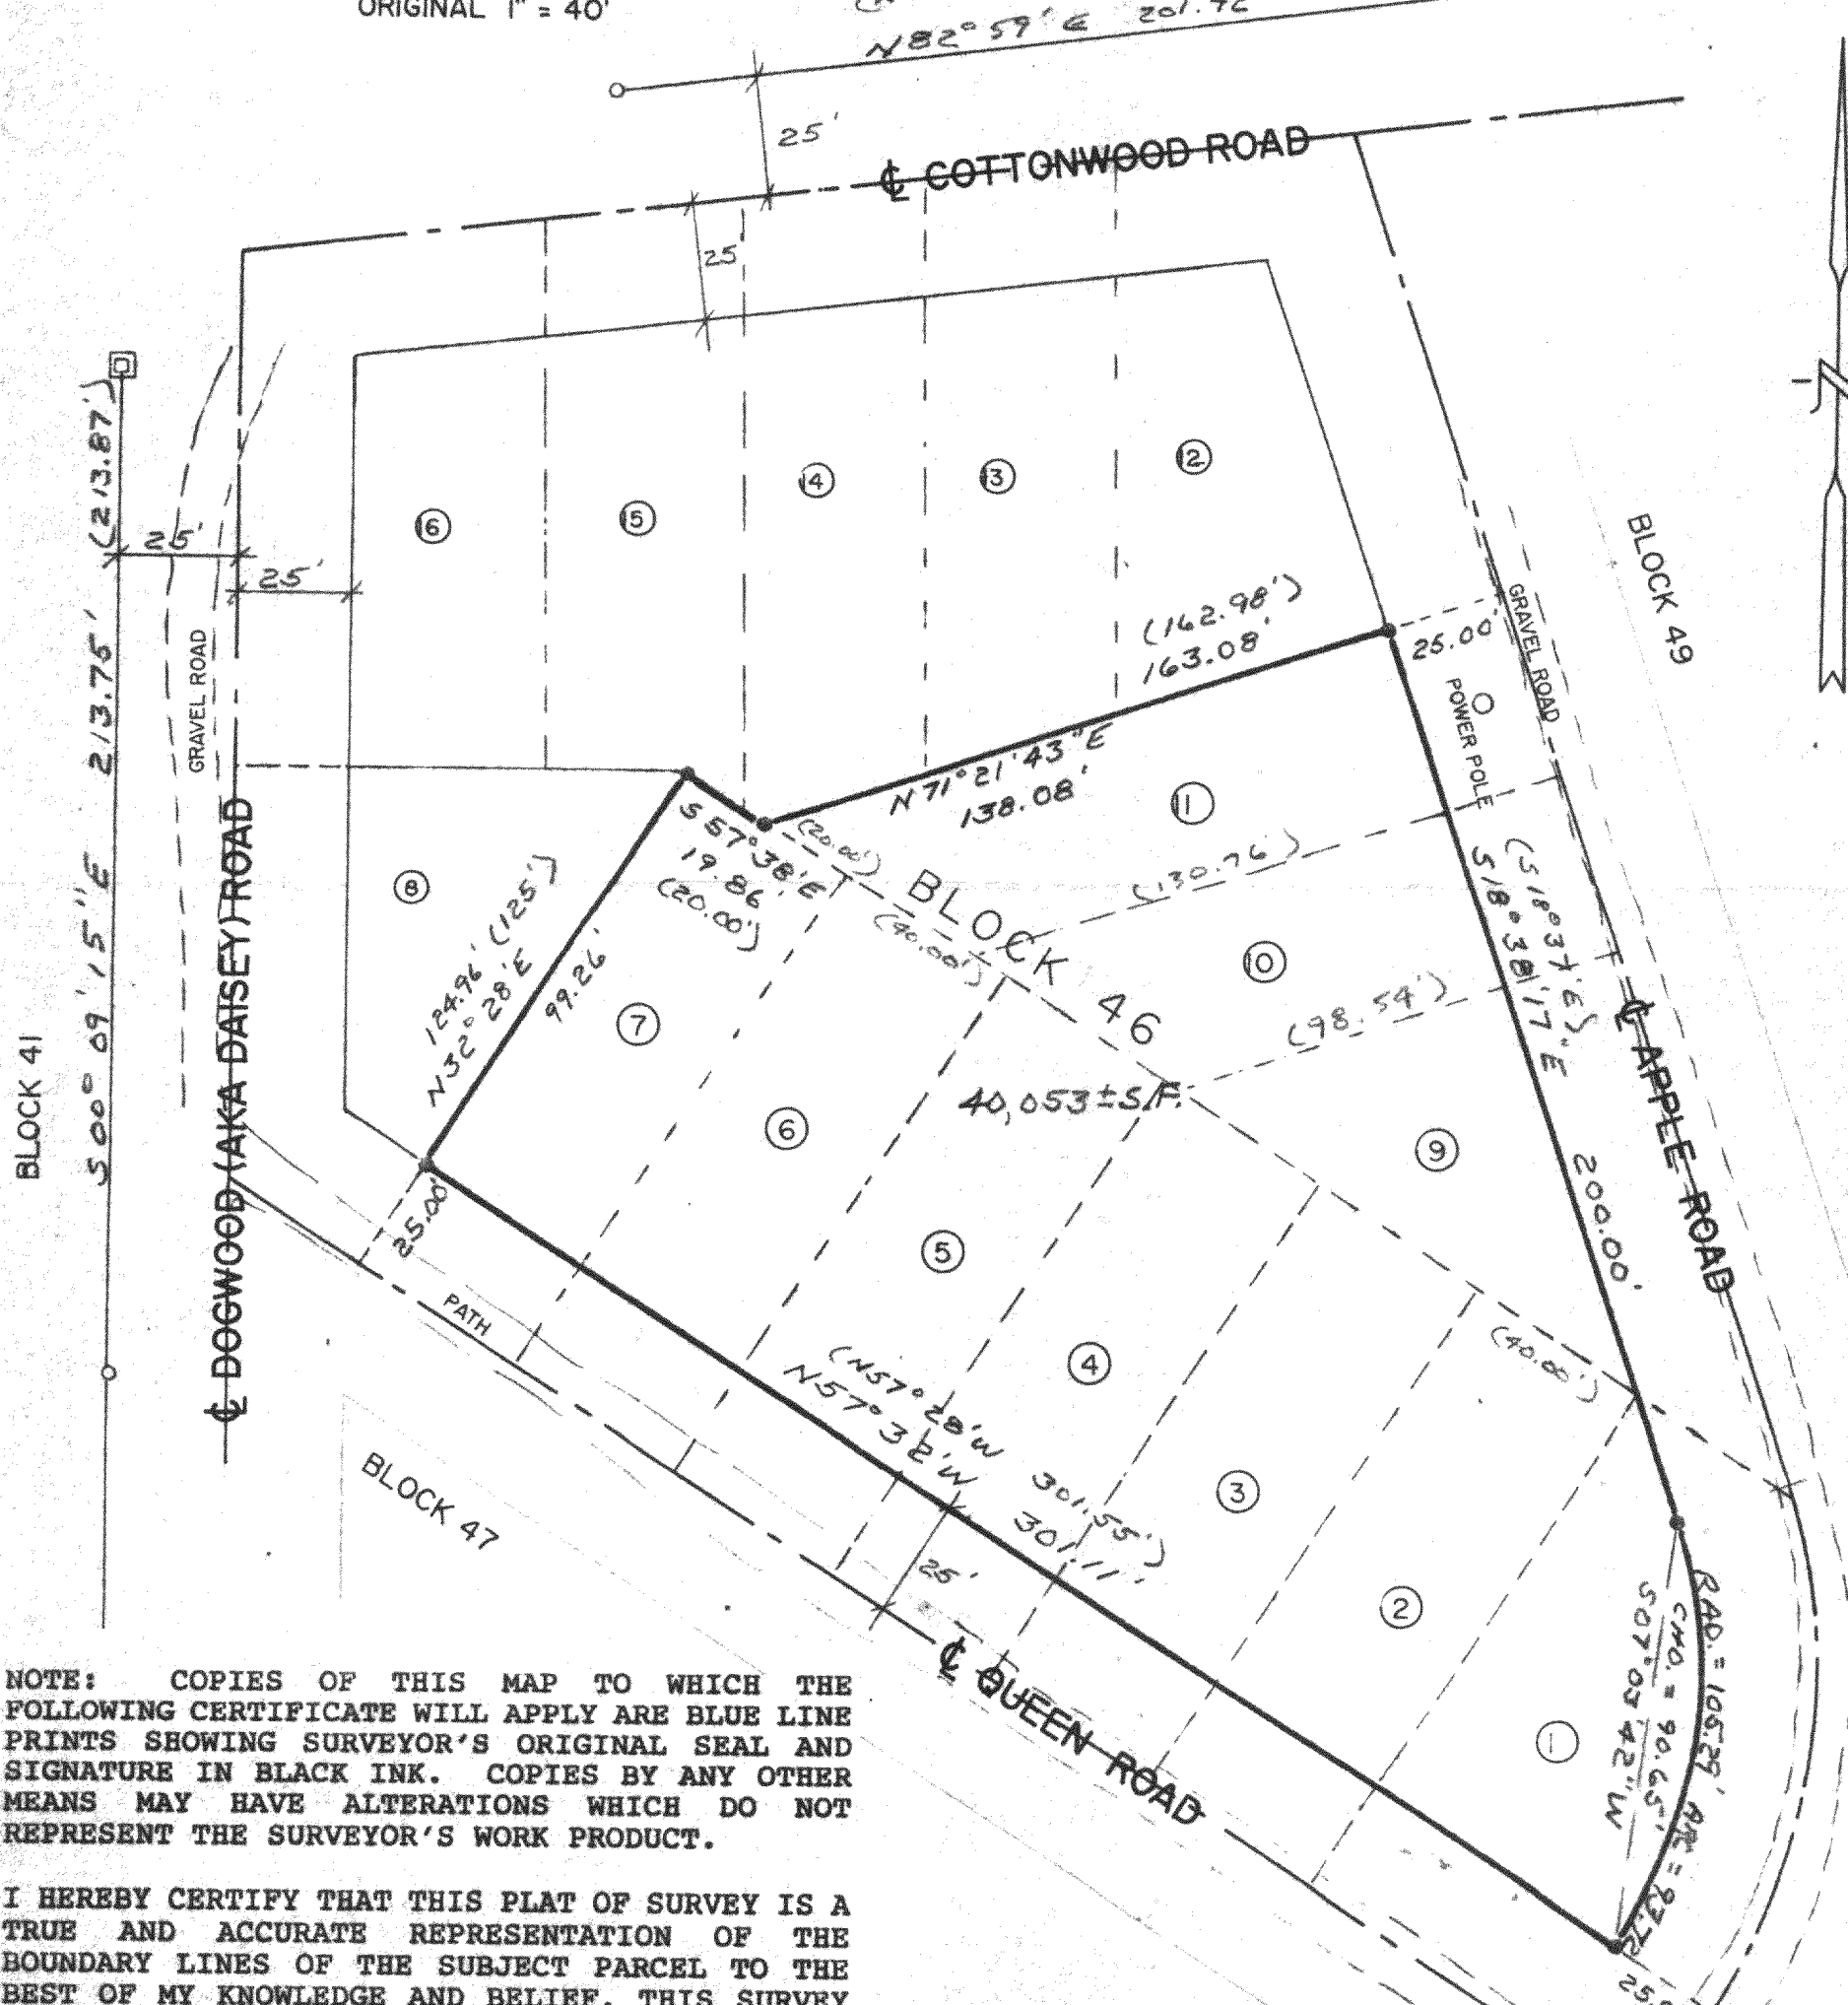


NOTE: COPIES OF THIS MAP TO WHICH THE FOLLOWING CERTIFICATE WILL APPLY ARE BLUE LINE PRINTS SHOWING SURVEYOR'S ORIGINAL SEAL AND SIGNATURE IN BLACK INK. COPIES BY ANY OTHER MEANS MAY HAVE ALTERATIONS WHICH DO NOT REPRESENT THE SURVEYOR'S WORK PRODUCT.

I HEREBY CERTIFY THAT THIS PLAT OF SURVEY IS A TRUE AND ACCURATE REPRESENTATION OF THE BOUNDARY LINES OF THE SUBJECT PARCEL TO THE BEST OF MY KNOWLEDGE AND BELIEF. THIS SURVEY IS MADE FOR THE USE OF THE PRESENT OWNERS OF THE PROPERTY, AND ALSO THOSE WHO PURCHASE, MORTGAGE, OR GUARANTEE THE TITLE THERETO WITHIN ONE YEAR FROM THE DATE HEREOF.

DATED: 10/28/92

Peter S. Gordon
PETER S. GORDON RLS 210

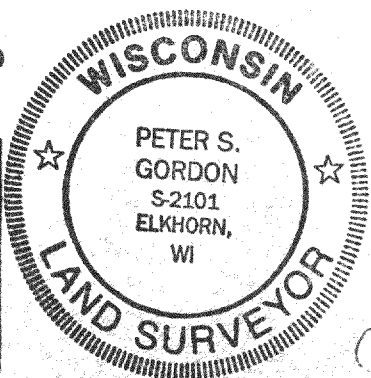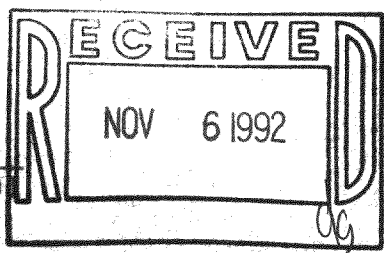

GI-422
GI-423
GI-424
GI-426

316-597