



WALWORTH COUNTY
SURVEYING & MAPPING
727 HENRY STREET
LAKE GENEVA, WISCONSIN
414-248-0505

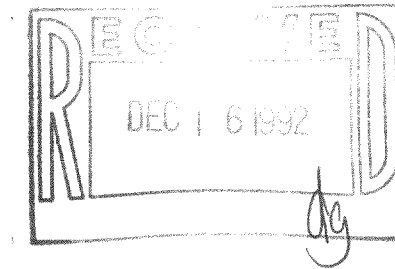

TOPPECANOE TRAIL

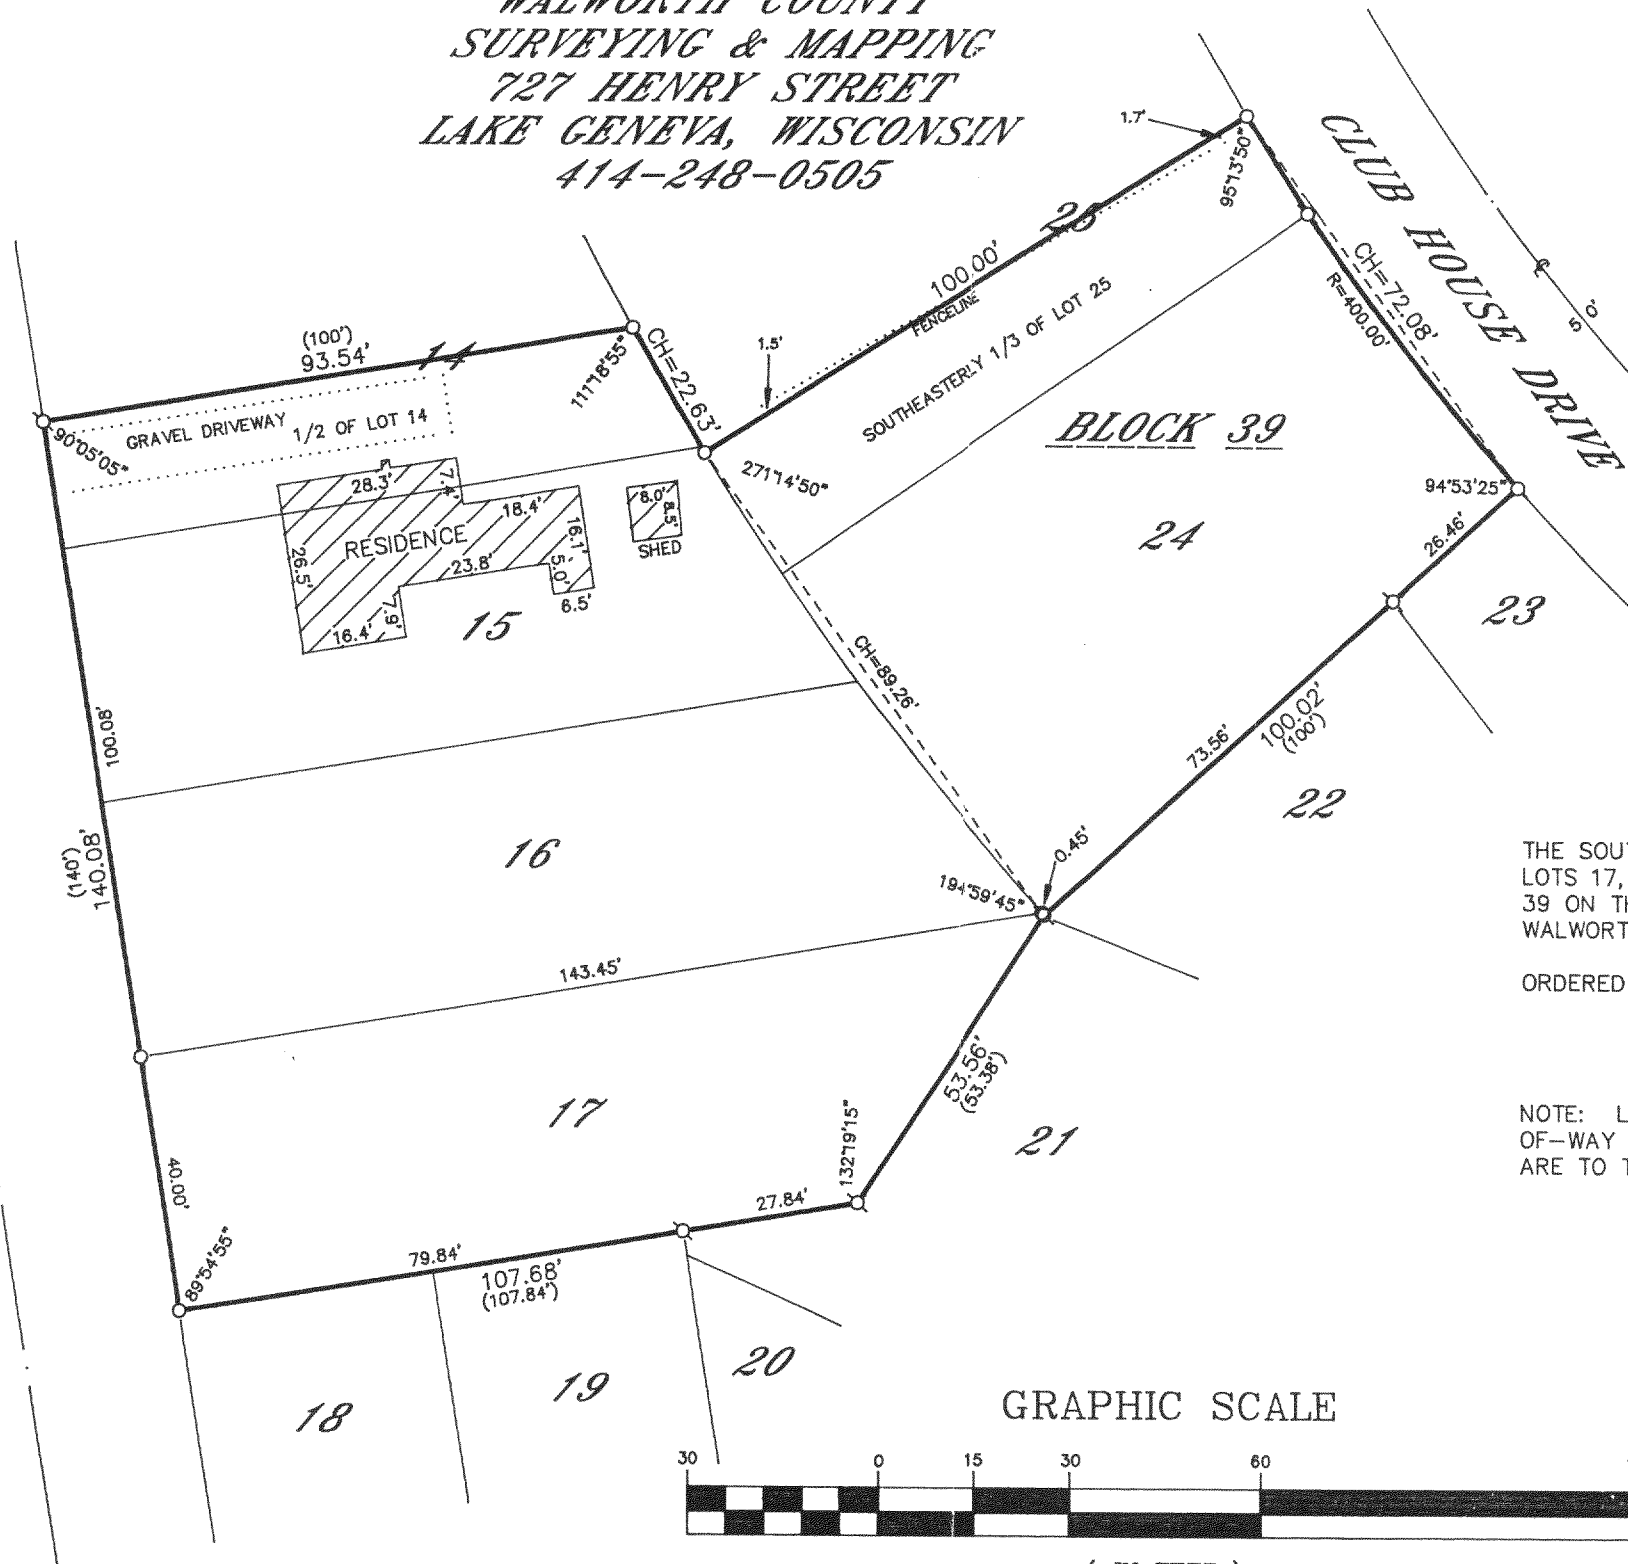

PLAT OF SURVEY OF

THE SOUTHERLY 1/2 OF LOT 14 AND ALL OF LOTS 15 AND 16, ALSO, LOTS 17, 24 AND THE SOUTHEASTERLY 1/3 OF LOT 25, ALL IN BLOCK 39 ON THE THIRD MAP OF INTERLAKEN, TOWN OF SUGAR CREEK, WALWORTH COUNTY, WISCONSIN.

ORDERED BY: CENTURY 21 WOOD REALTY
704 NORTH LINCOLN
ELKHORN, WISCONSIN
53121

NOTE: LOT DIMENSIONS SHOWN HEREON ARE TO THE ROAD RIGHT-OF-WAY LINES. LOT DIMENSIONS SHOWN ON THE PLAT OF RECORD ARE TO THE CENTERLINES OF THE ROADS.

GRAPHIC SCALE



(IN FEET)
1 inch = 30 ft.

- IRON PIPE FOUND
- CONCRETE MONUMENT FOUND
- IRON PIPE PLACED
- ()-RECORDED AS

I HEREBY CERTIFY THAT I HAVE SURVEYED THE ABOVE DESCRIBED PROPERTY AND THAT THE ABOVE MAP IS A TRUE REPRESENTATION THEREOF AND SHOWS THE SIZE AND LOCATION OF THE PROPERTY, ITS EXTERIOR BOUNDARIES, THE LOCATION OF ALL VISIBLE STRUCTURES AND DIMENSIONS OF ALL PRINCIPAL BUILDINGS THEREON, BOUNDARY FENCES, APPARENT EASEMENTS, ROADWAYS AND VISIBLE ENCROACHMENTS, IF ANY, TO THE BEST OF MY KNOWLEDGE AND BELIEF.

THIS SURVEY IS MADE FOR THE USE OF THE PRESENT OWNERS OF THE PROPERTY AND ALSO THOSE WHO PURCHASE, MORTGAGE OR GUARANTEE THE TITLE THERETO WITHIN ONE (1) YEAR FROM DATE HEREOF.

Robert M. Baerenwald
ROBERT M. BAERENWALD
WISCONSIN REGISTERED LAND SURVEYOR, S-1508

Feb. 4, 1992
DATE: FEB. 4, 1992 JOB NO. 3347

NOTE: THIS IS NOT A CERTIFIED COPY UNLESS SEALED.

G1-347
G1-344
G1-343

316-615