


**WALWORTH COUNTY  
SURVEYING & MAPPING**



727 HENRY STREET  
LAKE GENEVA, WISCONSIN  
414-248-0505

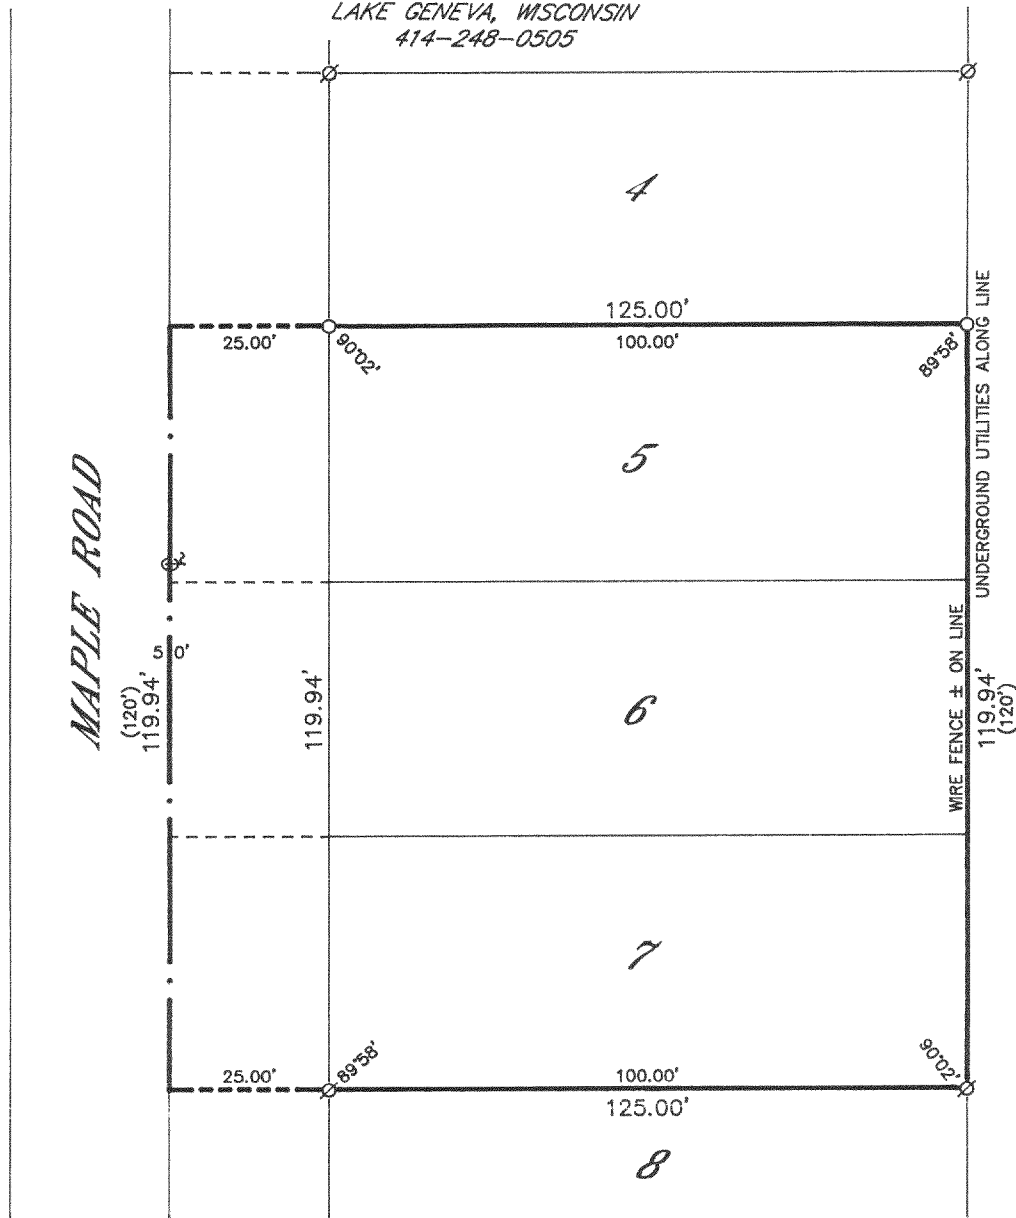

**PLAT OF SURVEY OF**

LOTS 5, 6 AND 7, BLOCK 23 OF THE SECOND  
MAP OF INTERLAKEN, LOCATED IN SECTION 11,  
T 3 N, R 16 E, WALWORTH COUNTY, WISCONSIN.

ORDERED BY: MODERN REALTY  
102 WEST WISCONSIN STREET  
ELKHORN, WISCONSIN  
53121

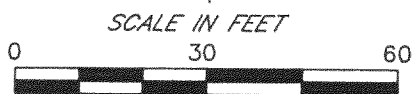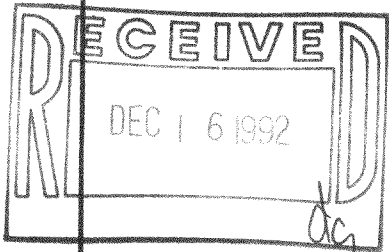

- LEGEND**
- ⊙-IRON PIPE FOUND
  - ⊗-IRON ROD FOUND
  - ⊕-CONCRETE MONUMENT FOUND
  - IRON PIPE PLACED
  - ( )-RECORDED AS

I HEREBY CERTIFY THAT I HAVE SURVEYED THE ABOVE DESCRIBED  
PROPERTY AND THAT THE ABOVE MAP IS A TRUE REPRESENTATION  
THEREOF AND SHOWS THE SIZE AND LOCATION OF THE PROPERTY,  
ITS EXTERIOR BOUNDARIES, THE LOCATION OF ALL VISIBLE STRUCTURES  
AND DIMENSIONS OF ALL PRINCIPAL BUILDINGS THEREON, BOUNDARY  
FENCES, APPARENT EASEMENTS, ROADWAYS AND VISIBLE ENCROACH-  
MENTS, IF ANY, TO THE BEST OF MY KNOWLEDGE AND BELIEF.

THIS SURVEY IS MADE FOR THE USE OF THE PRESENT OWNERS OF  
THE PROPERTY AND ALSO THOSE WHO PURCHASE, MORTGAGE OR  
GUARANTEE THE TITLE THERETO WITHIN ONE (1) YEAR FROM DATE  
HEREOF.

*Robert M. Baerenwald*  
ROBERT M. BAERENWALD  
WISCONSIN REGISTERED LAND SURVEYOR, S-1508

DATE July 27, 1992 JOB NO. 3500

NOTE: THIS IS NOT A CERTIFIED COPY UNLESS SEALED.

61-260

316-624