


KOLB LAND CONSULTING, INC.
LAND SURVEYING • SUBDIVIDING • LAND PLANNING

LAKE GENEVA, WISCONSIN 53147


414-248-3697

ORDERED BY: RICHARD ANEY % BEST
BUILT GARAGE BUILDERS
BOX 922
JANESVILLE, WI. 53547

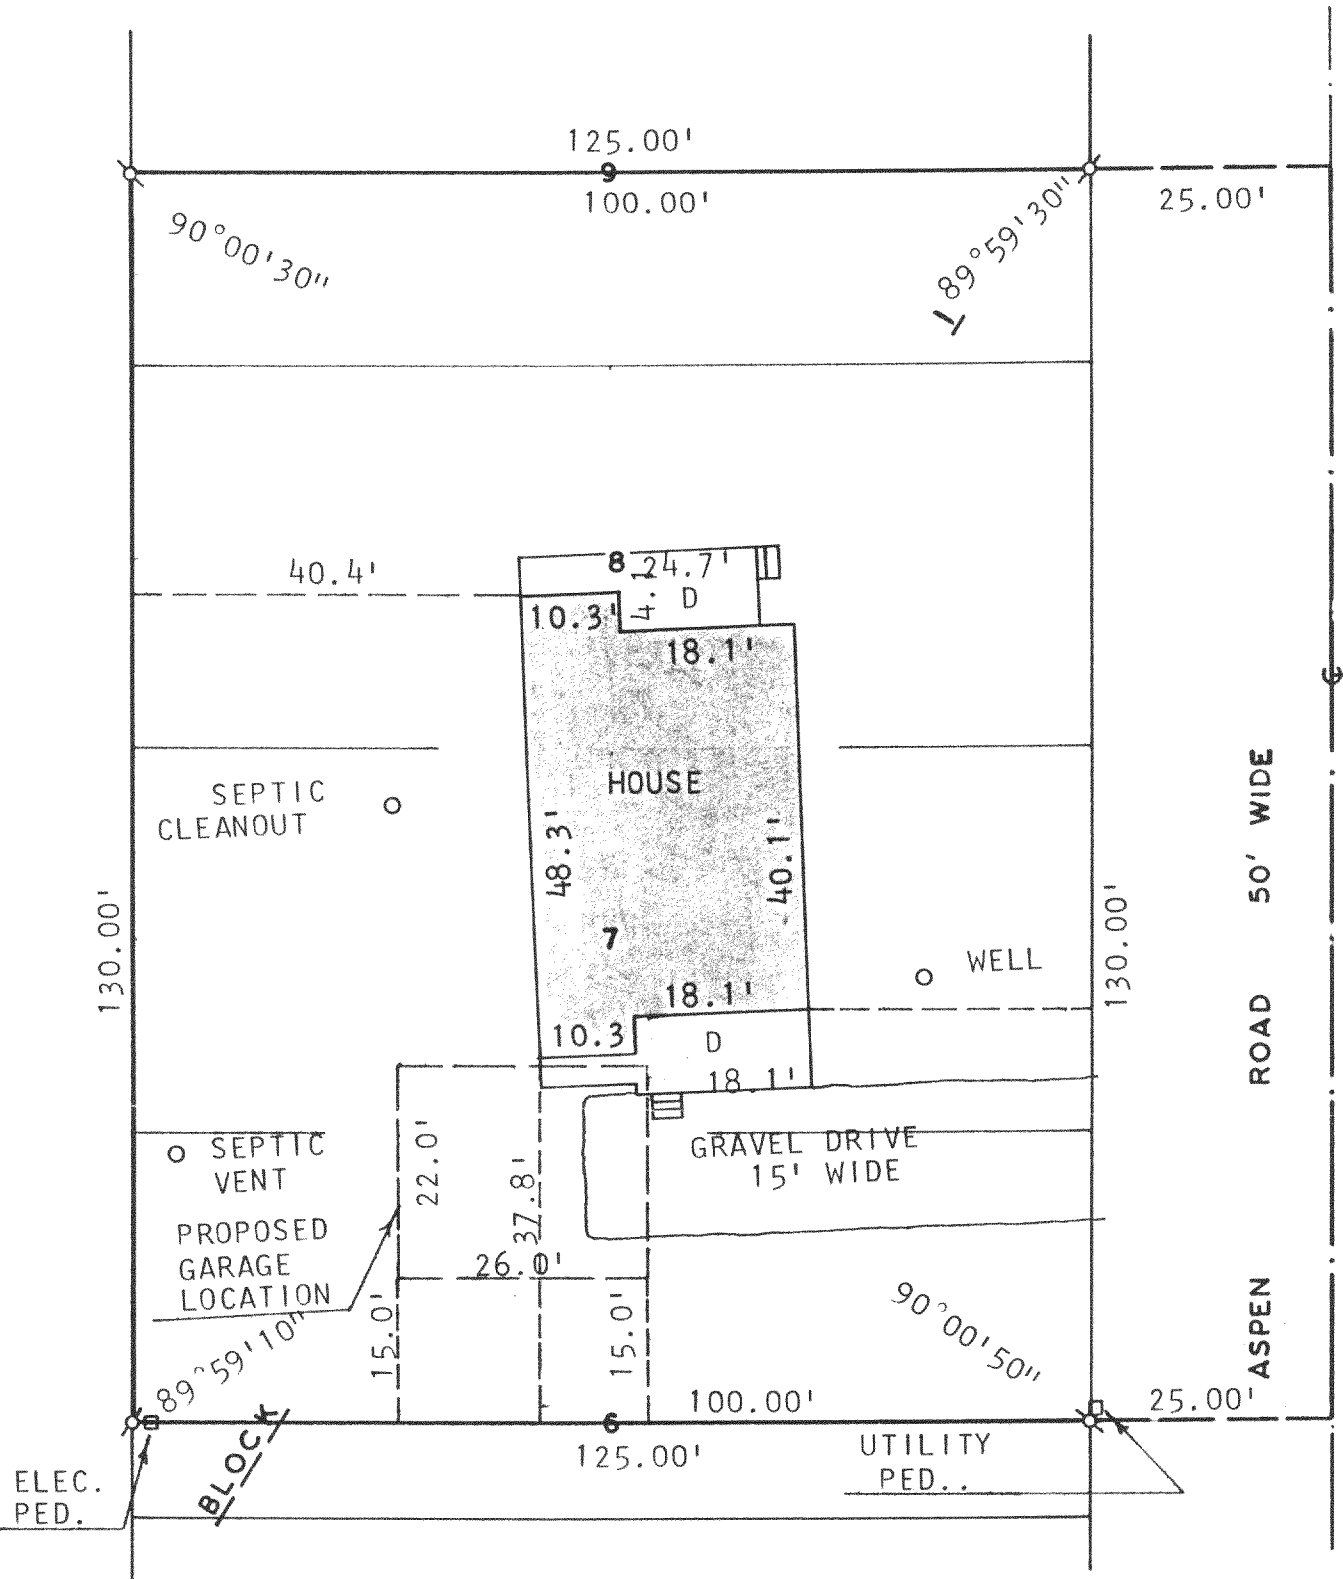

PLAT OF SURVEY OF

THE NORTH 30 FEET OF LOT 6, LOTS 7 & 8 AND THE SOUTH
20 FEET OF LOT 9, ALL IN BLOCK 1 OF INTERLAKEN SUB-
DIVISION LOCATED IN T3N, R16E, TOWN OF SUGAR CREEK,
WALWORTH COUNTY, WISCONSIN.

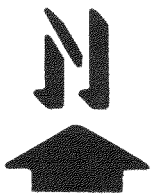


SCALE: 1" = 20'

LEGEND

- ⊙ - IRON PIPE FOUND
- - IRON PIPE SET
- D - DECK

GI-2

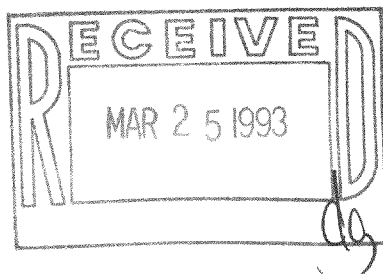

I, HAROLD H. KOLB, DO HEREBY CERTIFY
THAT I HAVE SURVEYED THE PROPERTY
HEREON DESCRIBED ACCORDING TO THE
OFFICIAL RECORDS AND THAT THE PLAT
HEREON IS A CORRECT REPRESENTATION
OF THE LOT LINES AND THE PRINCIPAL
LINES OF THE BUILDINGS, TO THE BEST
OF MY KNOWLEDGE AND BELIEF.
SURVEY NOT VALID UNLESS SURVEYOR'S SIGNATURE
IS IN RED.

316-628

HAROLD H. KOLB
WISCONSIN REGISTERED LAND SURVEYOR, S-187
DATE NOV. 3, 1992