


KOLB LAND CONSULTING, INC.
 LAND SURVEYING • SUBDIVIDING • LAND PLANNING

LAKE GENEVA, WISCONSIN 53147


414-248-3697

ORDERED BY: RICHARD ANEY % BEST
 BUILT GARAGE BUILDERS
 BOX 922
 JANESVILLE, WI. 53547

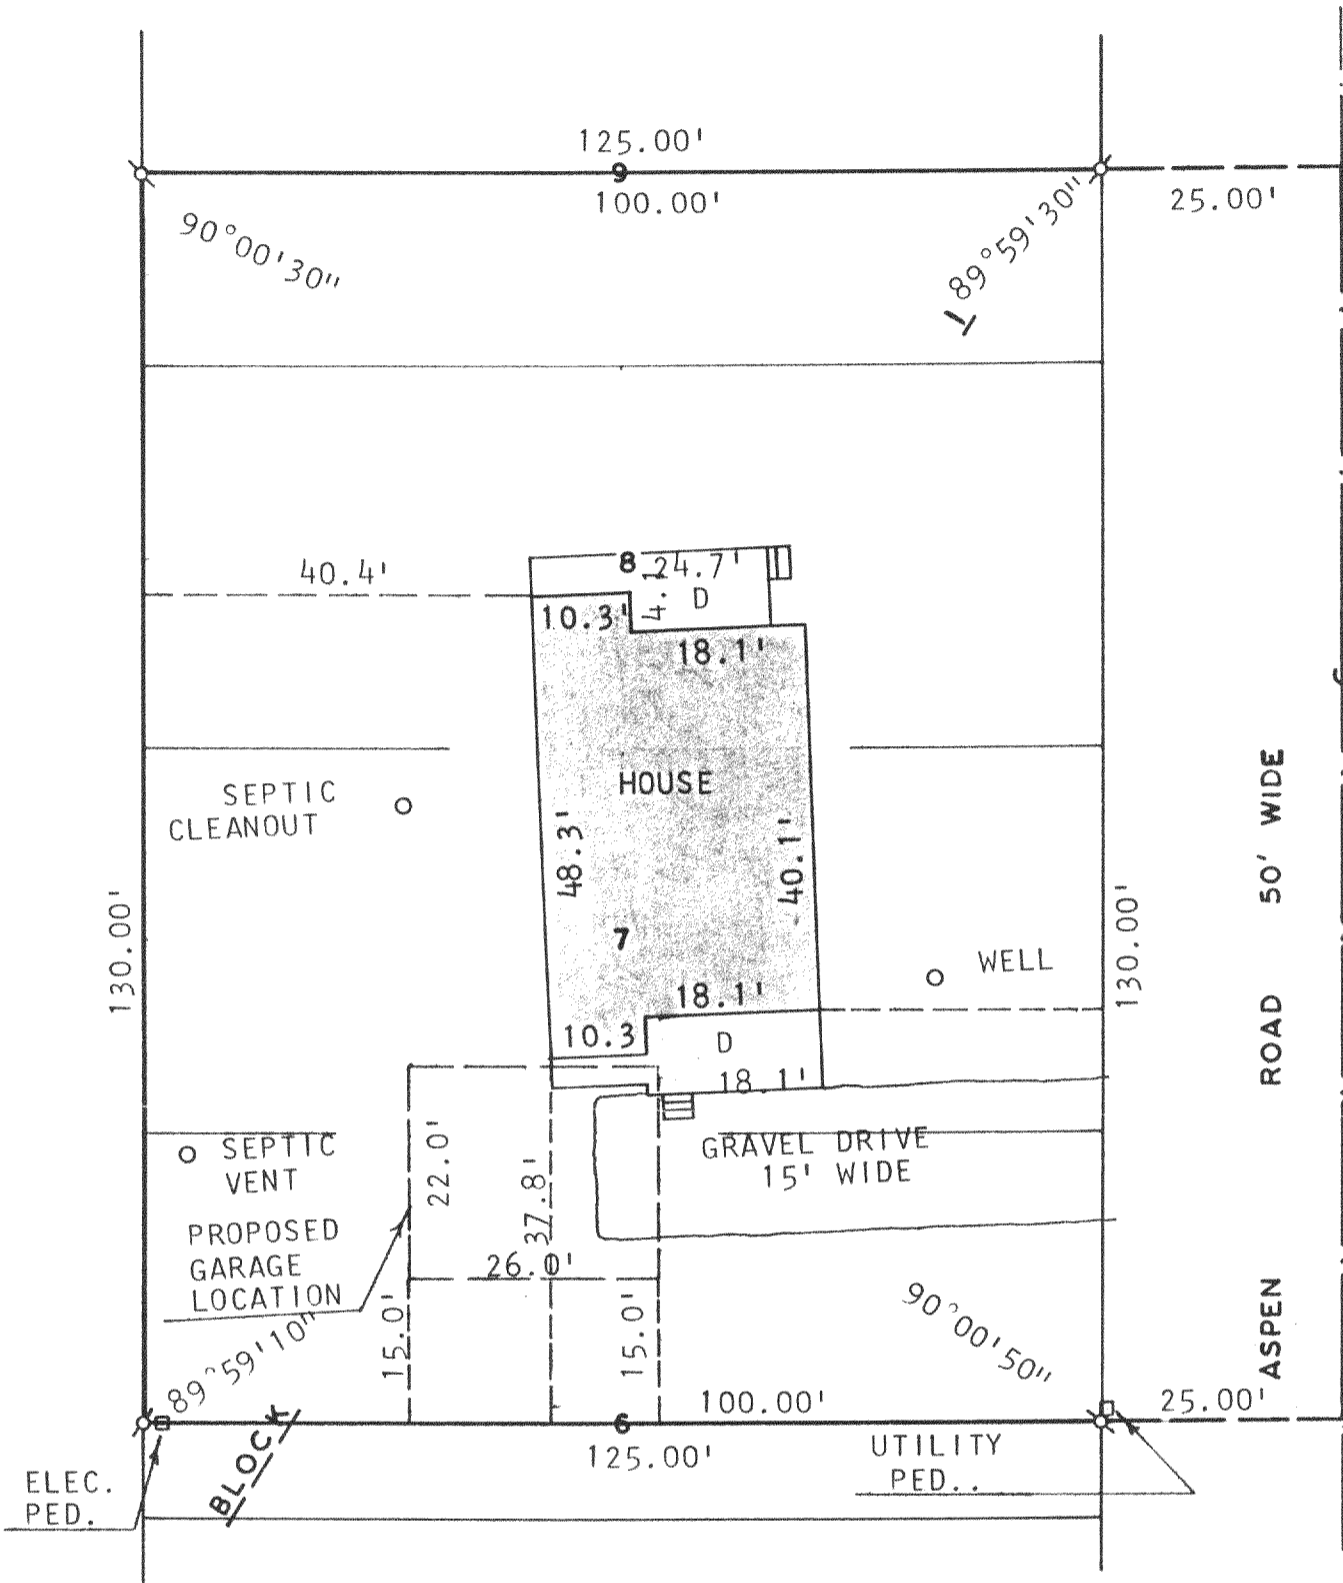

PLAT OF SURVEY OF

THE NORTH 30 FEET OF LOT 6, LOTS 7 & 8 AND THE SOUTH 20 FEET OF LOT 9, ALL IN BLOCK 1 OF INTERLAKEN SUB-DIVISION LOCATED IN T3N, R16E, TOWN OF SUGAR CREEK, WALWORTH COUNTY, WISCONSIN.

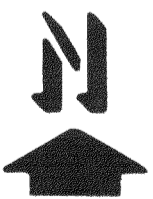


SCALE: 1" = 20'

LEGEND

- ⊕ - IRON PIPE FOUND
- - IRON PIPE SET
- D - DECK

GI-2

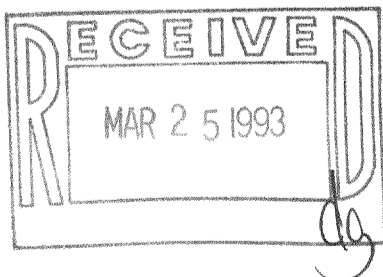

I, HAROLD H. KOLB, DO HEREBY CERTIFY THAT I HAVE SURVEYED THE PROPERTY HEREON DESCRIBED ACCORDING TO THE OFFICIAL RECORDS AND THAT THE PLAT HEREON IS A CORRECT REPRESENTATION OF THE LOT LINES AND THE PRINCIPAL LINES OF THE BUILDINGS, TO THE BEST OF MY KNOWLEDGE AND BELIEF. SURVEY NOT VALID UNLESS SURVEYOR'S SIGNATURE IS IN RED.

316-628

HAROLD H. KOLB
 WISCONSIN REGISTERED LAND SURVEYOR, S-187
 DATE NOV. 3, 1992