

**ABERNATHY and ASSOCIATES**

**Kenneth B. Abernathy Jr.**

**Wisconsin Registered Land Surveyor S-1594**



Rt. 3, Box 273  
Elkhorn, Wisconsin 53121  
Phone: (414) 723-4260 (office)  
(414) 723-4813 (residence)

**PLAT OF SURVEY**

LOTS 19, 20, 21, AND THE  
NORTH 1/2 OF LOT 22 OF BLOCK  
17 OF THE ORIGINAL PLAT OF  
INTERLAKEN SUBDIVISION, 1ST  
MAP, LOCATED IN THE SOUTHEAST  
1/4 OF SECTION 11, TOWN 3  
NORTH, RANGE 16 EAST, TOWN OF  
SUGAR CREEK, COUNTY OF  
WALWORTH, STATE OF WISCONSIN.

TOTAL AREA 14,000 SQ. FT.

ORDERED BY: **JACK BUILT HOMES**  
257 LEWIS STREET  
BURLINGTON, WIS.  
53105

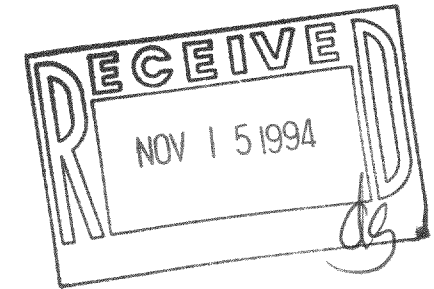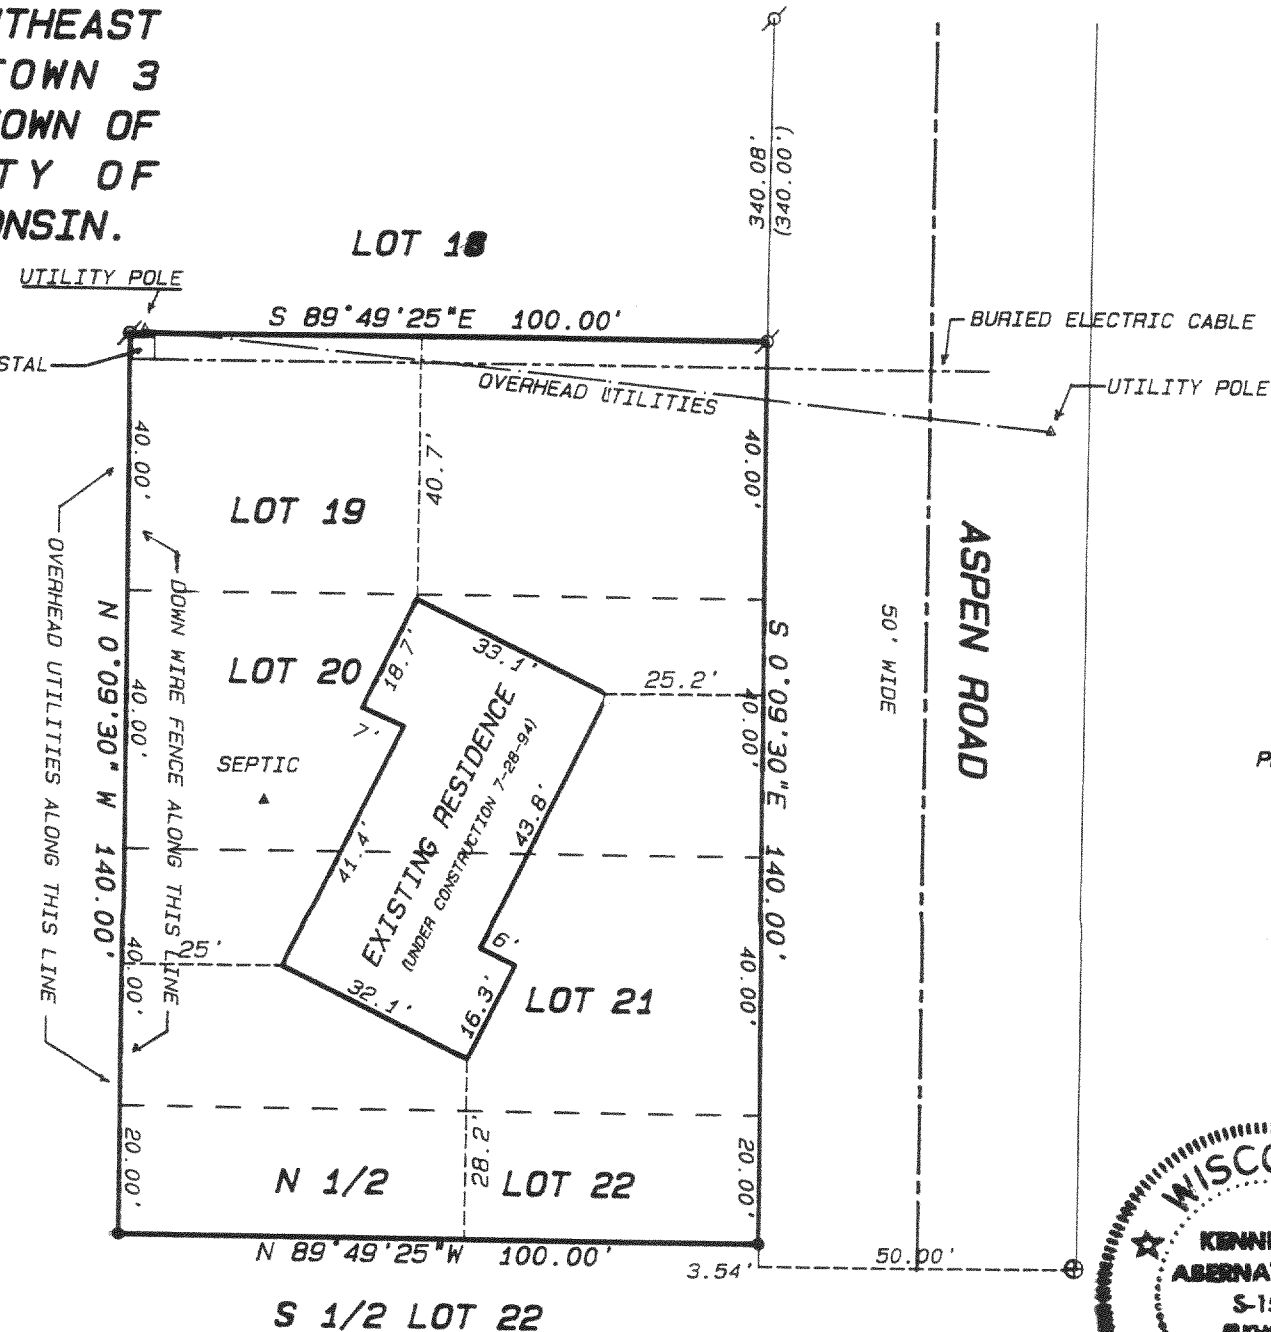

SCALE: 1" = 30 FEET


**Legend**

- FOUND IRON PIPE
- FOUND IRON ROD
- FOUND BRASS CAPPED MONUMENT
- FOUND CONCRETE MONUMENT
- + CHISEL CUT IN CONCRETE
- SET IRON PIPE, 84" LONG, WEIGHING 1.19 LBS./LINEAL FT., 1" DIA.
- SET IRON ROD, 30" LONG, WEIGHING 4.5 LBS./LINEAL FT., 1-11/16" DIA.
- (xx) RECORDED AS DIMENSION
- x-x- EXISTING FENCE

SCALE: 1" = 30 FEET  
BEARINGS REFERENCED TO  
PREVIOUS SURVEY TO THE EAST

"I hereby certify that I have surveyed the above described property and that the above map is a true representation thereof and shows the size and location of the property, its exterior boundaries, the location of all visible structures and dimensions of all principal buildings thereon, boundary fences, apparent easements, roadways and visible encroachments, if any."

"This survey is made for the use of the present owners of the property, and also those who purchase, mortgage, or guarantee the title thereto within one year from date hereof."

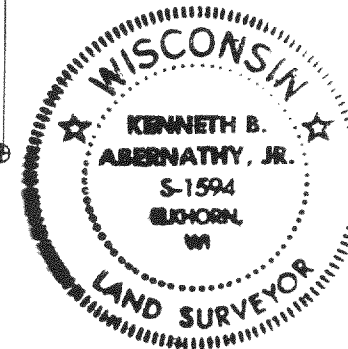

*Kenneth B. Abernathy, Jr.*  
KENNETH B. ABERNATHY, JR.  
WISCONSIN REGISTERED LAND SURVEYOR,  
S-1594

Date: JULY 28, 1994 Job No. 93510AB

6I-237

316-740