WISCONSIN DRIVE FENCE 1' EAST UTILITIES ALONG LINE GRAVEL PARKING AREA 23 24 25 26 SHED FENCE ON 10.3 FENCE 0.7' WEST 35 33 34 RETAINING/ WALLS : CONCRETE PARKING AREA 25.00 125.00' IRON PIPE IN RETAINING WALL IS 0.56' WEST AND 0.28' SOUTH OF LOT CORNER WANDAWEGA DRIVE

WALWORTH COUNTY
SURVEYING & MAPPING
727 HENRY STREET
LAKE GENEVA, WISCONSIN
414-248-0505

EGEUV


JAN 1 3 1995

PLAT OF SURVEY OF

LOTS 22-26 AND LOTS 33-37, BLOCK 104 OF LAKE WANDAWEGA SUBDIVISION, SOMETIMES REFERRED TO AS WANDAWEGA SUBDIVISION IN THE TOWN OF SUGAR CREEK, ACCORDING TO THE RECORDED PLAT THEREOF, WALWORTH COUNTY, WISCONSIN.

ORDERED BY: CENTURY 21 ZENK REALTY
704 NORTH LINCOLN
ELKHORN, WISCONSIN
53121

GRAPHIC SCALE

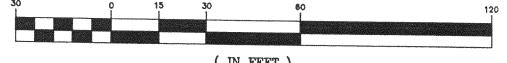

(IN FEET)
1 inch = 30 ft.

Ø-IRON PIPE FOUND Ø-IRON ROD FOUND Ø-CONCRETE MONUMENT FOUND O-IRON PIPE PLACED ()-RECORDED AS

I HEREBY CERTIFY THAT I HAVE SURVEYED THE ABOVE DESCRIBED PROPERTY AND THAT THE ABOVE MAP IS A TRUE REPRESENTATION THEREOF AND SHOWS THE SIZE AND LOCATION OF THE PROPERTY, ITS EXTERIOR BOUNDARIES, THE LOCATION OF ALL VISIBLE STRUCTURES AND DIMENSIONS OF ALL PRINCIPAL BUILDINGS THEREON, BOUNDARY FENCES, APPARENT EASEMENTS, ROADWAYS AND VISIBLE ENCROACHMENTS, IF ANY, TO THE BEST OF MY KNOWLEDGE AND BELIEF.

THIS SURVEY IS MADE FOR THE USE OF THE PRESENT OWNERS OF THE PROPERTY AND ALSO THOSE WHO PURCHASE, MORTGAGE OR QUARANTEE THE TITLE THERETO WITHIN ONE (1) YEAR FROM DATE HEREOF.

Mar M. BALLENCALD

ROBERT M. BALLENWALD

WISTONISM PROJECTEDED LAND SUBJECTED S. 1500

DATE 11/19949

NOTE: THIS IS NOT A CERTIFIED COPY UNLESS SEALED.