

# PLAT OF SURVEY



TRUSTWAY HOMES  
Jesse and Mary Ellen Kline

LOCATION: W5996 Briarwood Road, Sugar Creek, Wisconsin


LEGAL DESCRIPTION: Lot 51 in SYLVAN TRACE SUBDIVISION, located in the Southwest 1/4 of the Northeast 1/4, the Southwest 1/4 and the Southeast 1/4 of the Northwest 1/4, and the Northeast 1/4 and the Southeast 1/4 and the Northwest 1/4 of the Southwest 1/4 of Section 2, Town 3 North, Range 16 East, Walworth County, Wisconsin.

January 26, 1995

Survey No. 1949-B

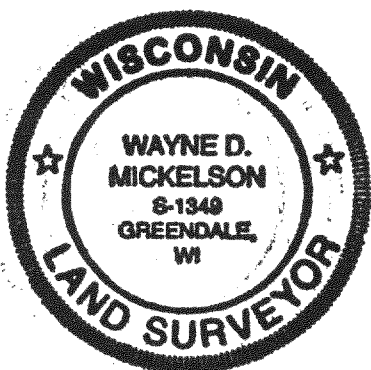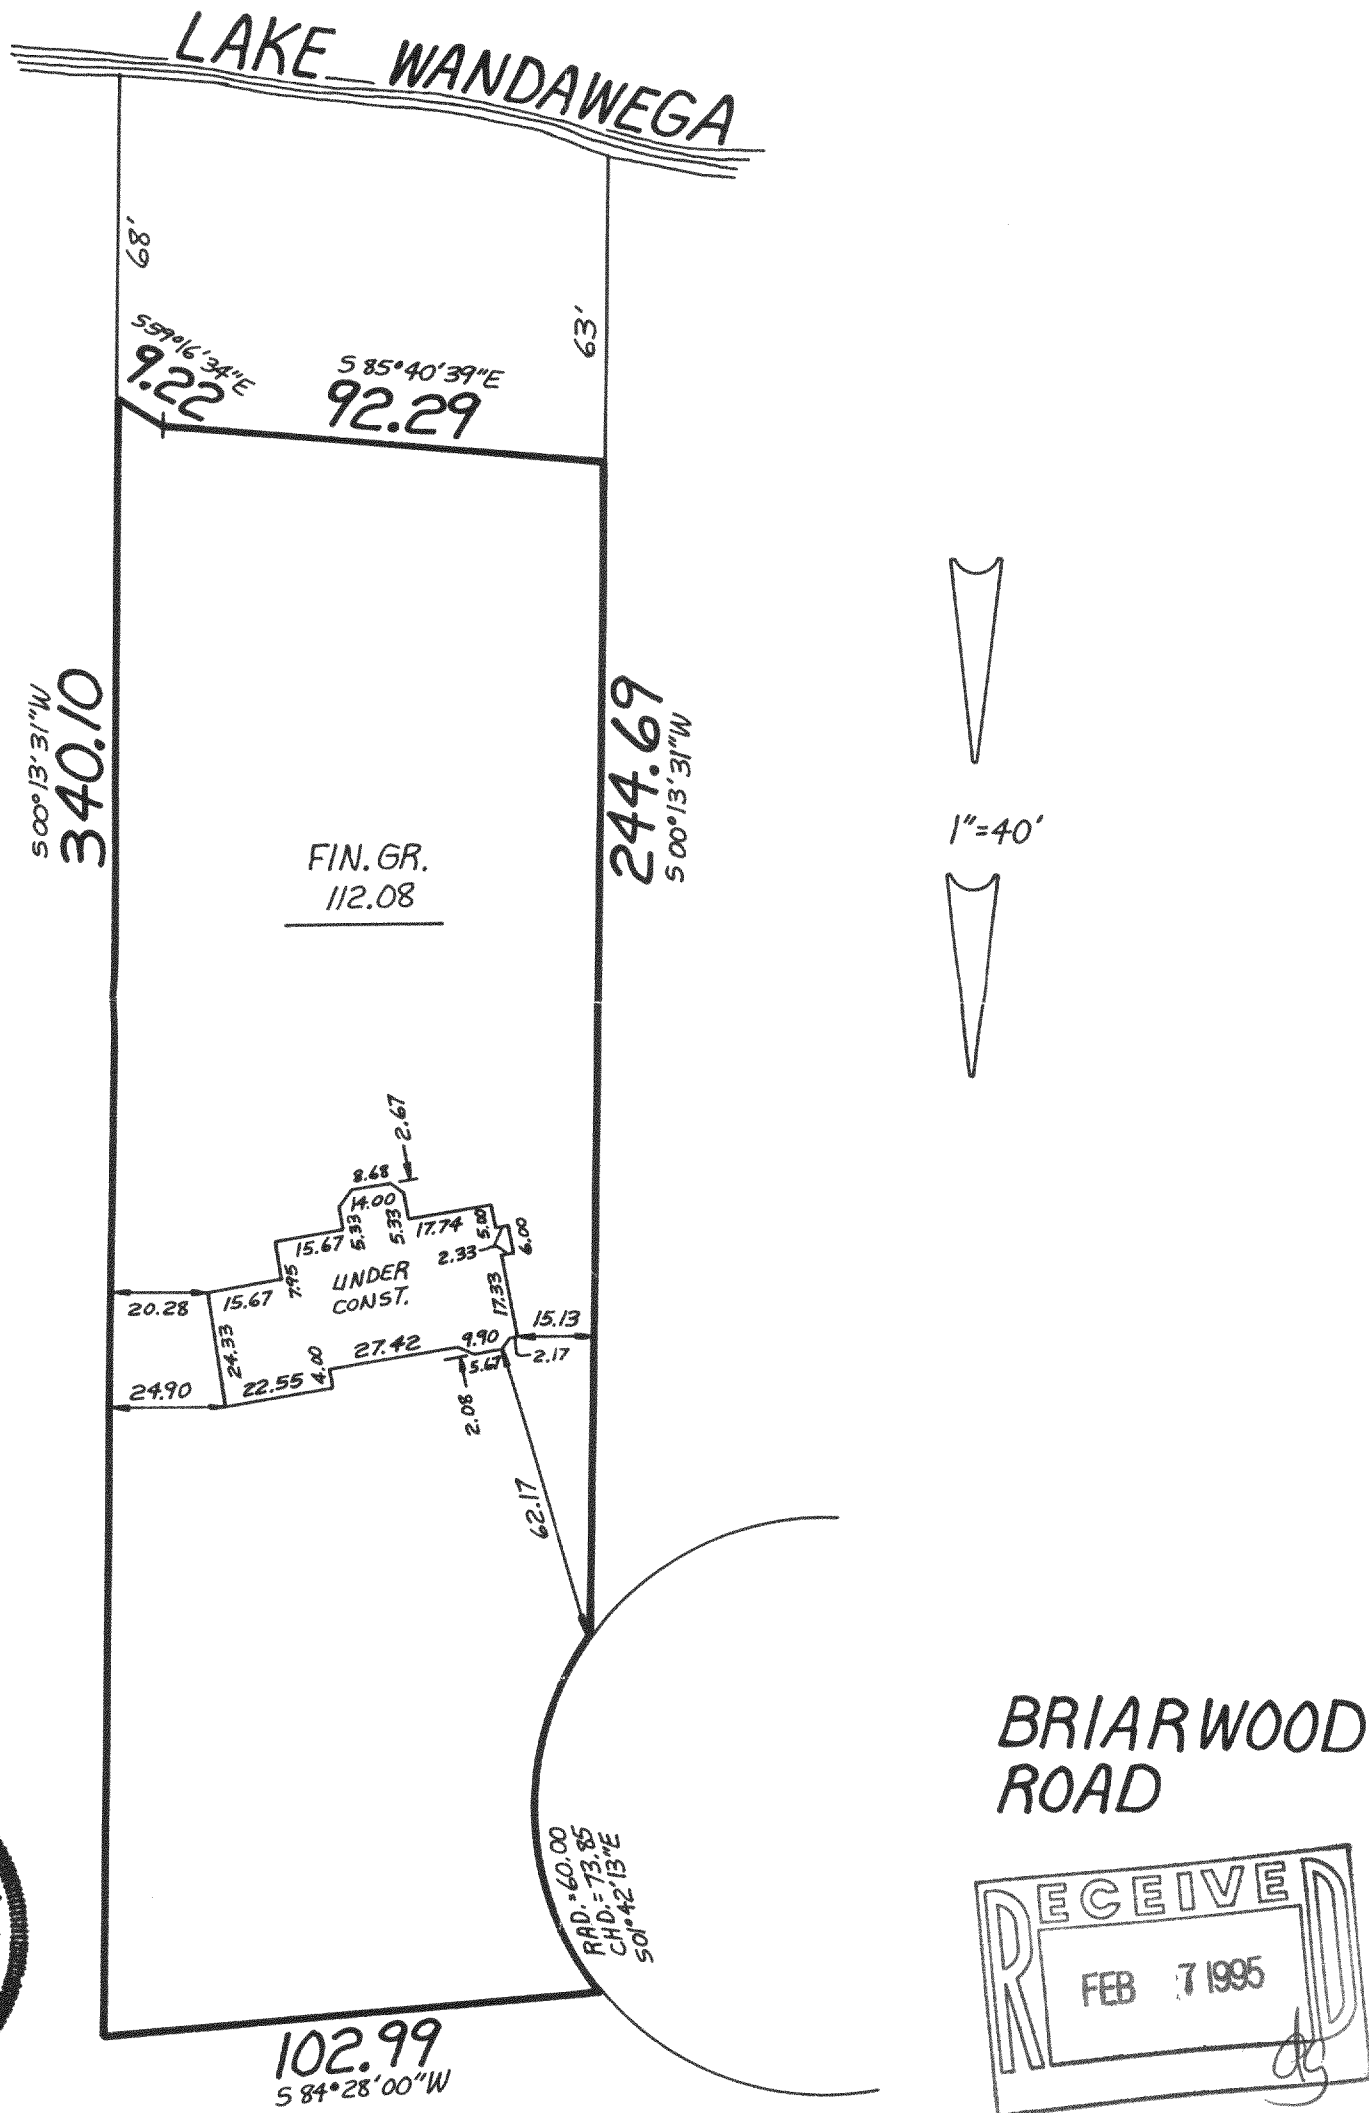

BRIARWOOD  
ROAD

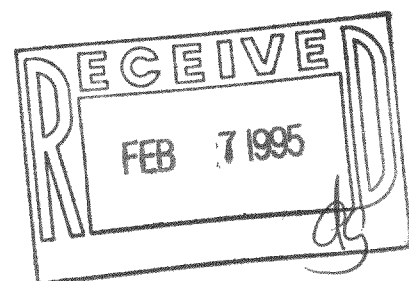

METROPOLITAN ENTERPRISES, INC.

REGISTERED LAND SURVEYORS

9415 W. FOREST HOME AVE., SUITE 202, HALES CORNERS, WI 53130

PH. 529-5380 FAX 529-9787

I HEREBY CERTIFY THAT I HAVE SURVEYED THE ABOVE DESCRIBED PROPERTY AND THAT THE ABOVE MAP IS A TRUE REPRESENTATION THEREOF AND SHOWS THE SIZE AND LOCATION OF THE PROPERTY, ITS EXTERIOR BOUNDARIES, THE LOCATION OF ALL VISIBLE STRUCTURES AND DIMENSIONS OF ALL PRINCIPAL BUILDINGS THEREON, BOUNDARY FENCES, APPARENT EASEMENTS AND ROADWAYS AND VISIBLE ENCROACHMENTS, IF ANY.

THIS SURVEY IS MADE FOR THE EXCLUSIVE USE OF THE PRESENT OWNERS OF THE PROPERTY, AND AT SO THOSE WHO PURCHASE, MORTGAGE, OR GUARANTEE THE TITLE THERETO WITHIN ONE (1) YEAR FROM DATE HEREOF.

SIGNED Wayne D. Mickelson

Wayne D. Mickelson  
Registered Land Surveyor S-1349

GST-51

316-748