


264-65

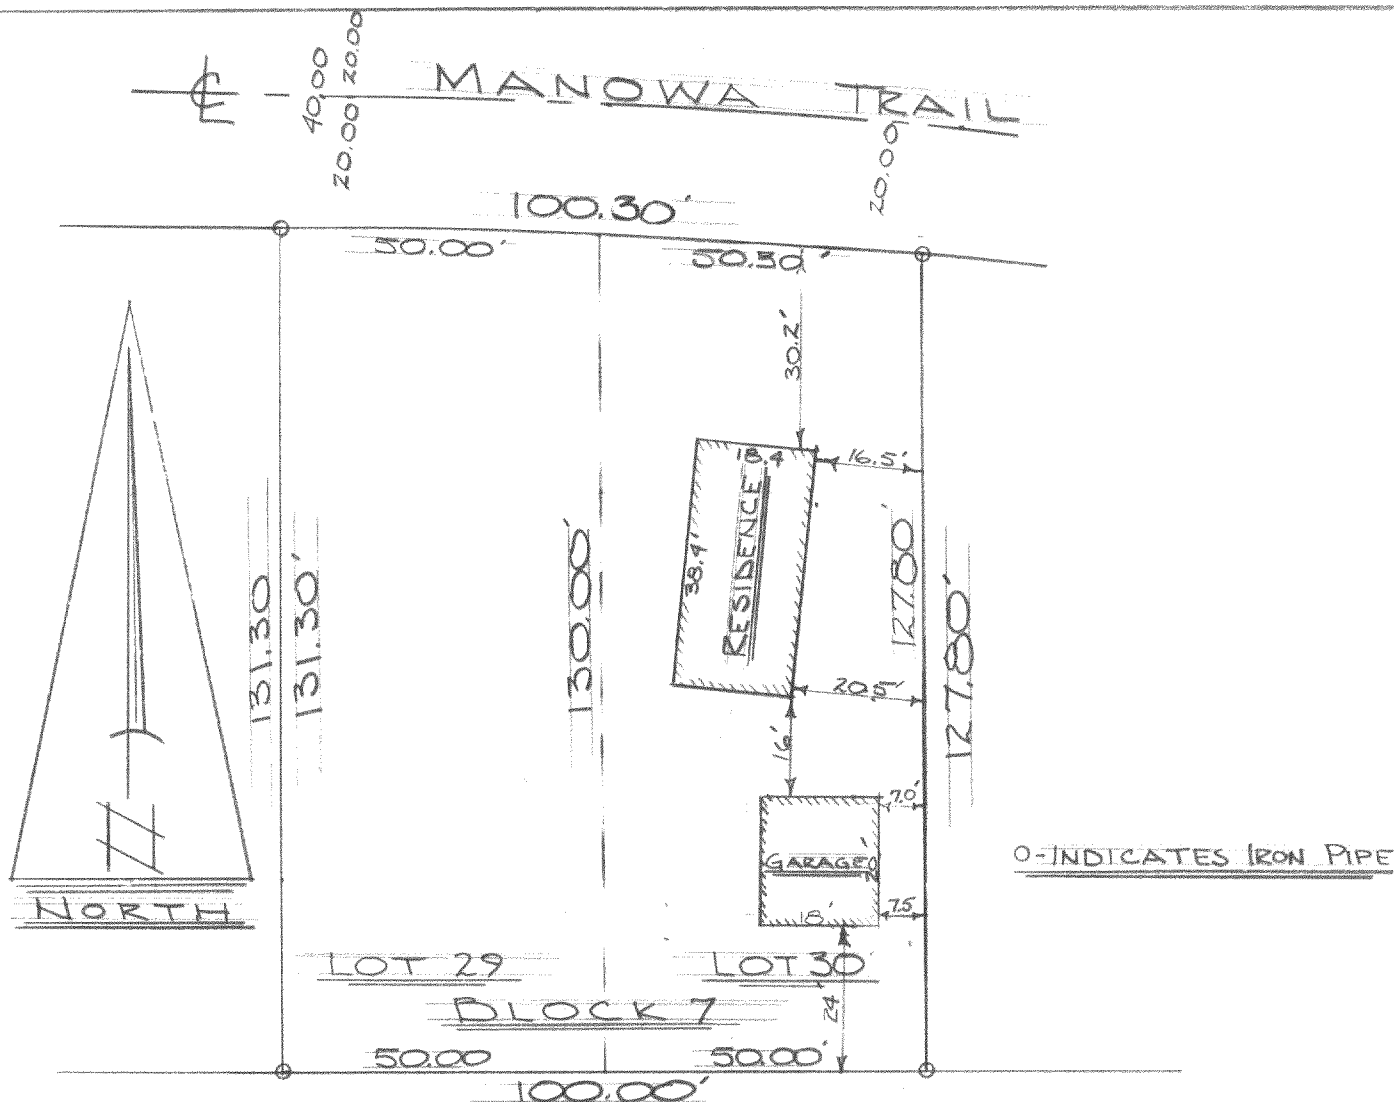

DESCRIPTION: Lots 29 and 30 of Block 7 of Lake Wandawega Highlands, in Sections 11 and 12, T. 3 N., R. 16 E. Walworth County, Wisconsin.

CERTIFICATE: I hereby certify that I have surveyed the above mentioned property and that the hereon portrayed is an accurate survey and a true representation thereof and correctly shows the exterior boundary lines and the location of the buildings and the other improvements thereof.

James F. Biagi
 James F. Biagi, RLS 273
 Elkhorn, Wisconsin.

December 6, 1965.

GW4-85

316-76B