

DUNHAM SURVEYING, S.C.

SURVEYING & SUBDIVIDING
DELAVER, WISCONSIN 53115





- = Concrete Monument Found
- x = Spike set in east side of the base of a 30" tree
- o = 3/4" Iron Pipe Set

Survey ordered by: Coldwell Banker
TLC Realty Inc
1000 N. Wisconsin
Elkhorn, WI 53121

May 5, 1994

George T. Dunham
George T. Dunham, Surveyor

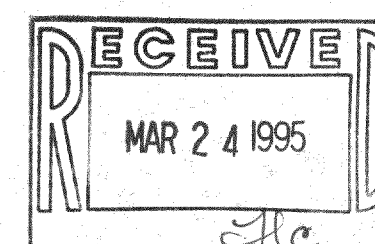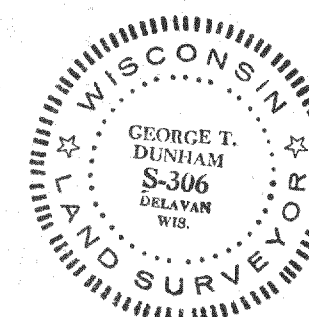

GSC-32-7A

316-771