


PLAT OF SURVEY
 LOTS 3 THRU 7 & 42 THRU 48
 BLOCK 103
 LAKE WANDAWEGA SUBDIVISION
 SEC. 2, T. 3 N., R 16 E.
 WALWORTH COUNTY, WISCONSIN

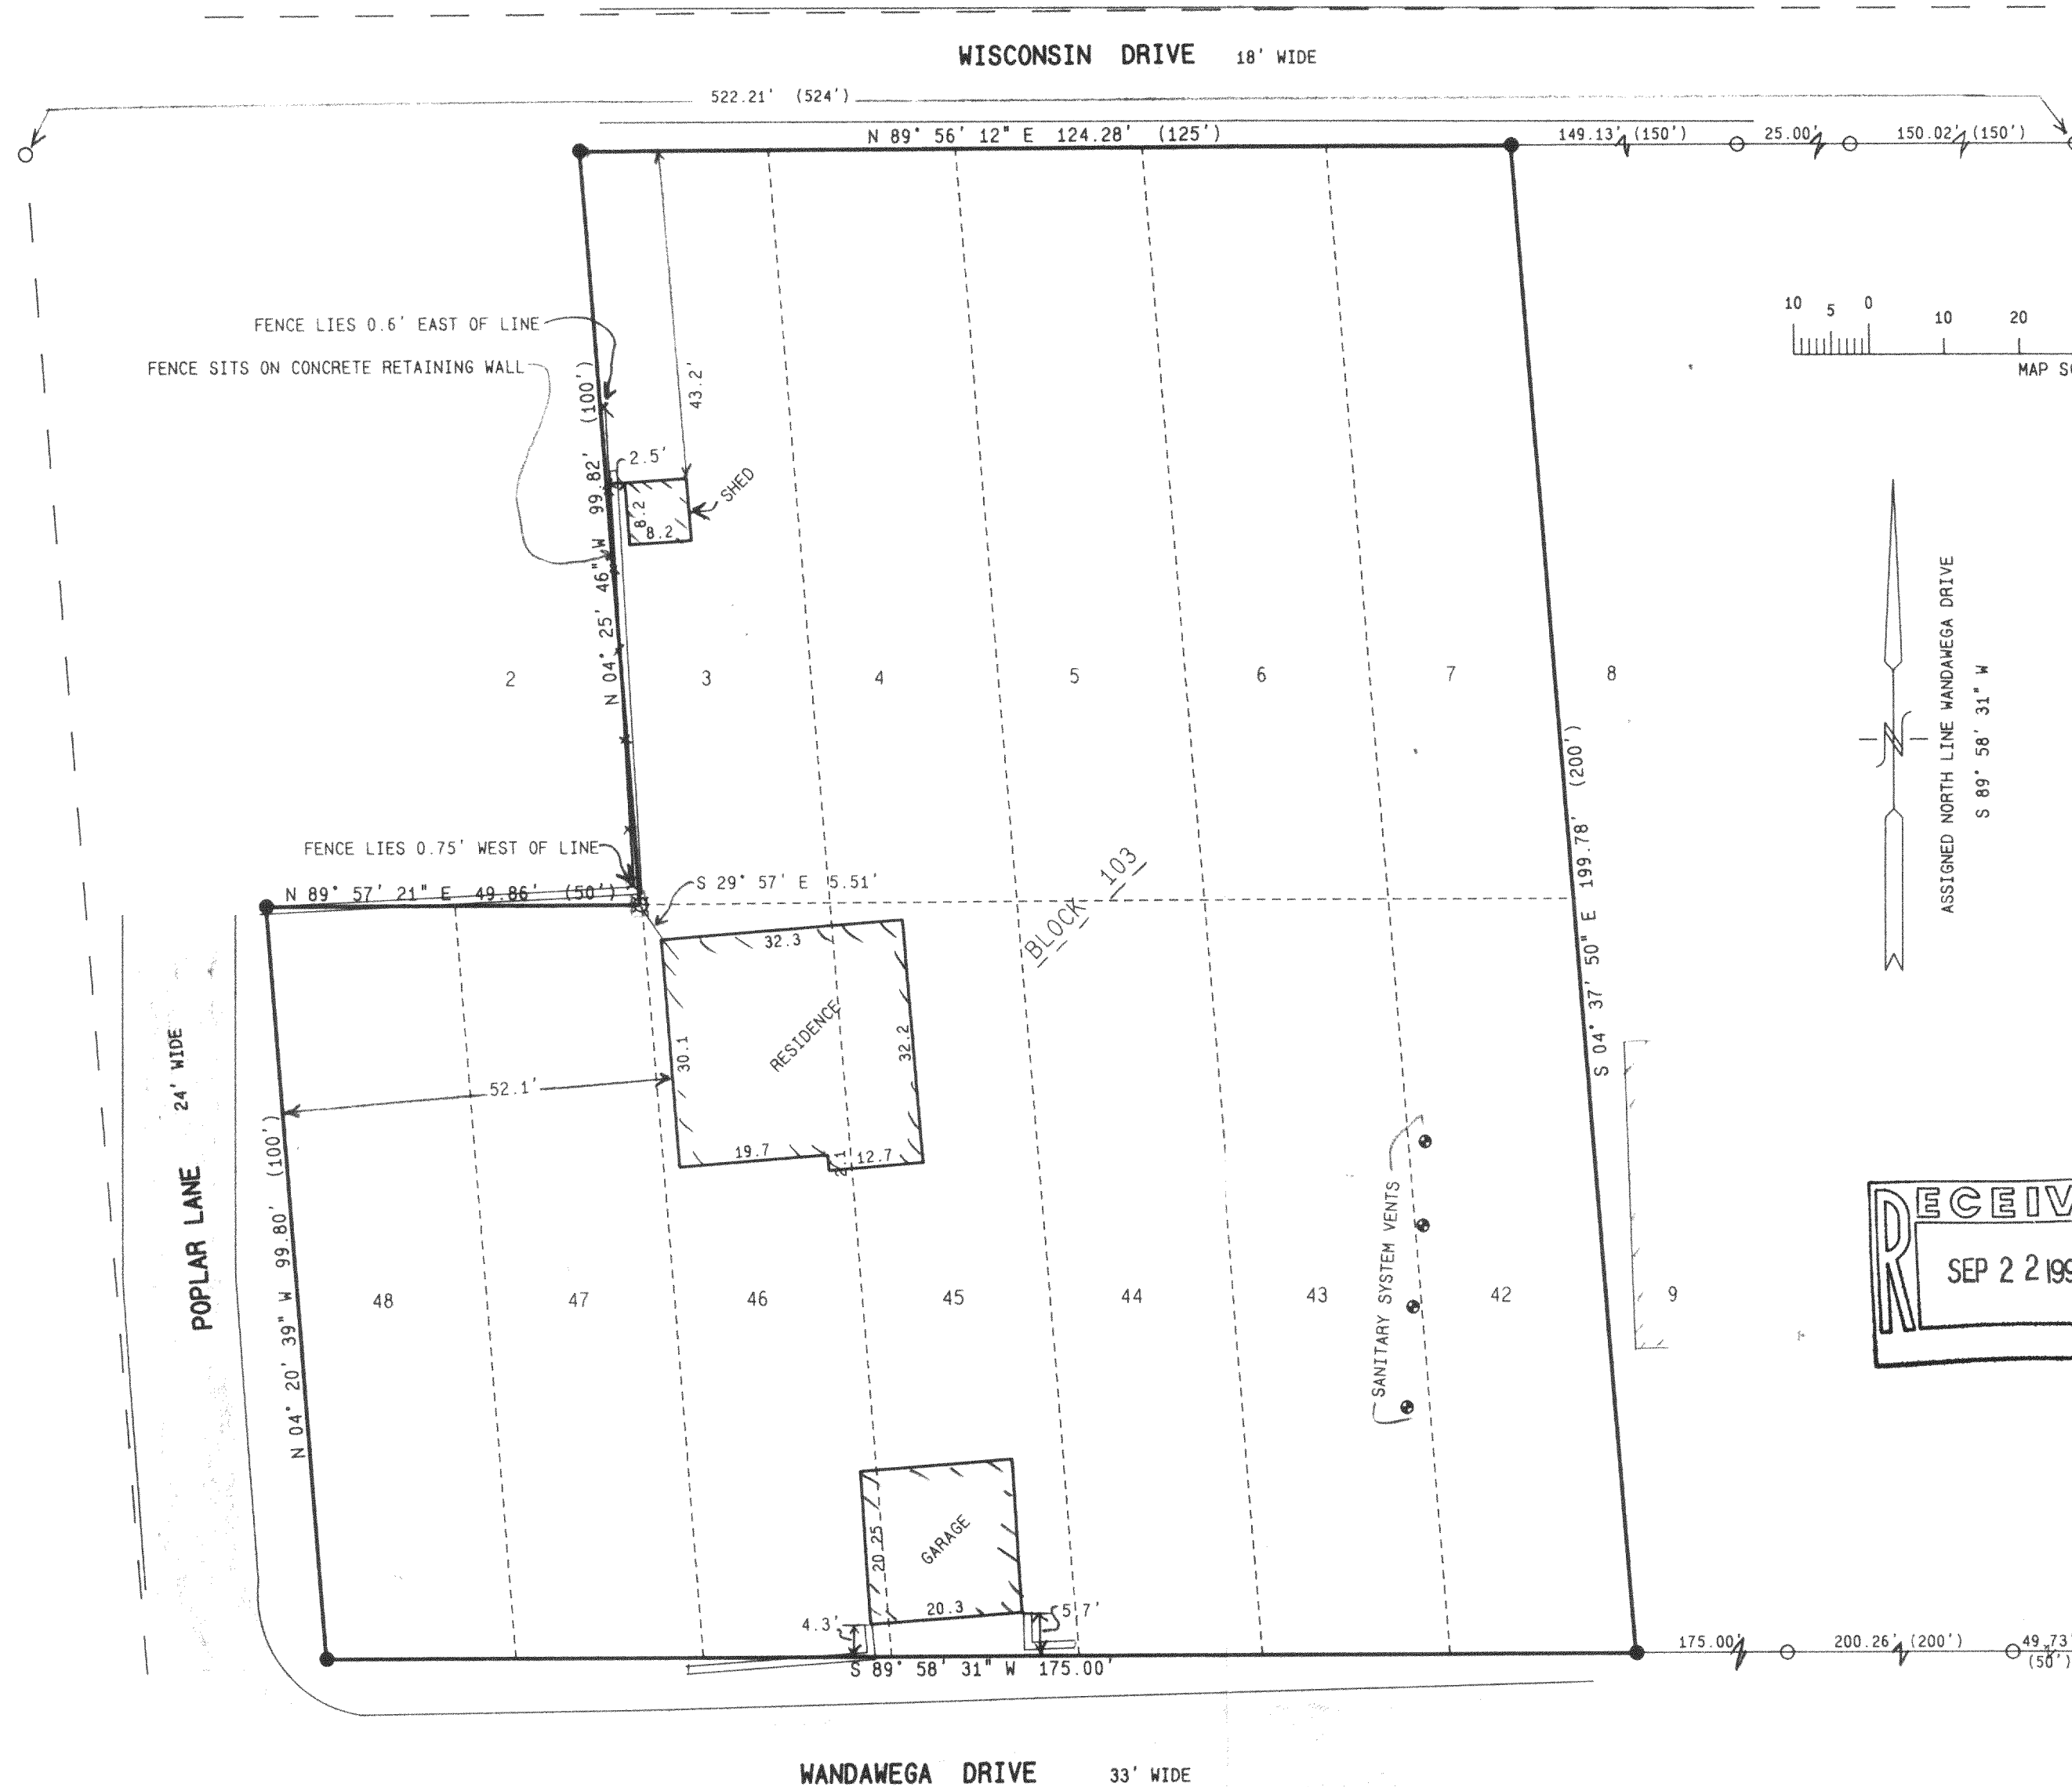


NOTE: COPIES OF THIS MAP TO WHICH THE FOLLOWING CERTIFICATE WILL APPLY ARE BLUE LINE PRINTS SHOWING SURVEYOR'S ORIGINAL SEAL AND SIGNATURE IN BLACK INK. COPIES BY ANY OTHER MEANS MAY HAVE ALTERATIONS WHICH DO NOT REPRESENT THE SURVEYOR'S WORK PRODUCT.

I HEREBY CERTIFY THAT THE ABOVE DESCRIBED PROPERTY HAS BEEN SURVEYED UNDER MY DIRECTION AND THAT THE ABOVE MAP IS A TRUE REPRESENTATION THEREOF AND SHOWS THE SIZE AND LOCATION OF THE PROPERTY AND ITS EXTERIOR BOUNDARIES. THIS SURVEY IS MADE FOR THE USE OF THE PRESENT OWNERS OF THE PROPERTY, AND ALSO THOSE WHO PURCHASE, MORTGAGE, OR GUARANTEE THE TITLE THERETO WITHIN ONE YEAR FROM THE DATE HEREOF.

DATED: 9-12-95

PETER S. GORDON
 S2101
 ELKHORN, WI
 PETER S. GORDON R.L.S. 2101

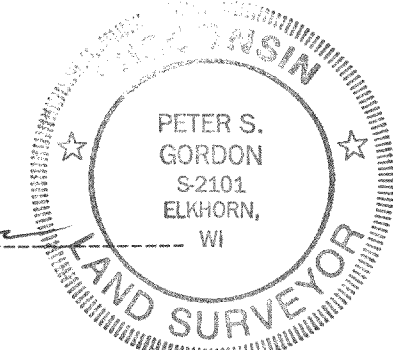

WORK ORDERED BY: RAYMOND WILLS
 W5393 WISCONSIN DRIVE
 ELKHORN, WI. 53121

FARRIS, HANSEN & ASSOCIATES, INC.
 Engineering, Architecture, Surveying
 7 Ridgway Court P.O. Box 437
 ELKHORN, WISCONSIN 53121
 Office: (414) 723-2098
 Fax: (414) 723-5886

REVISIONS

PROJECT NO.
 4369
 DATE
 09/12/95
 SHEET NO.
 1 OF 1

GLW-250
 GLW-259

316-803