


GEORGE T. DUNHAM
SURVEYING & SUBDIVIDING
DELAVAN, WISCONSIN

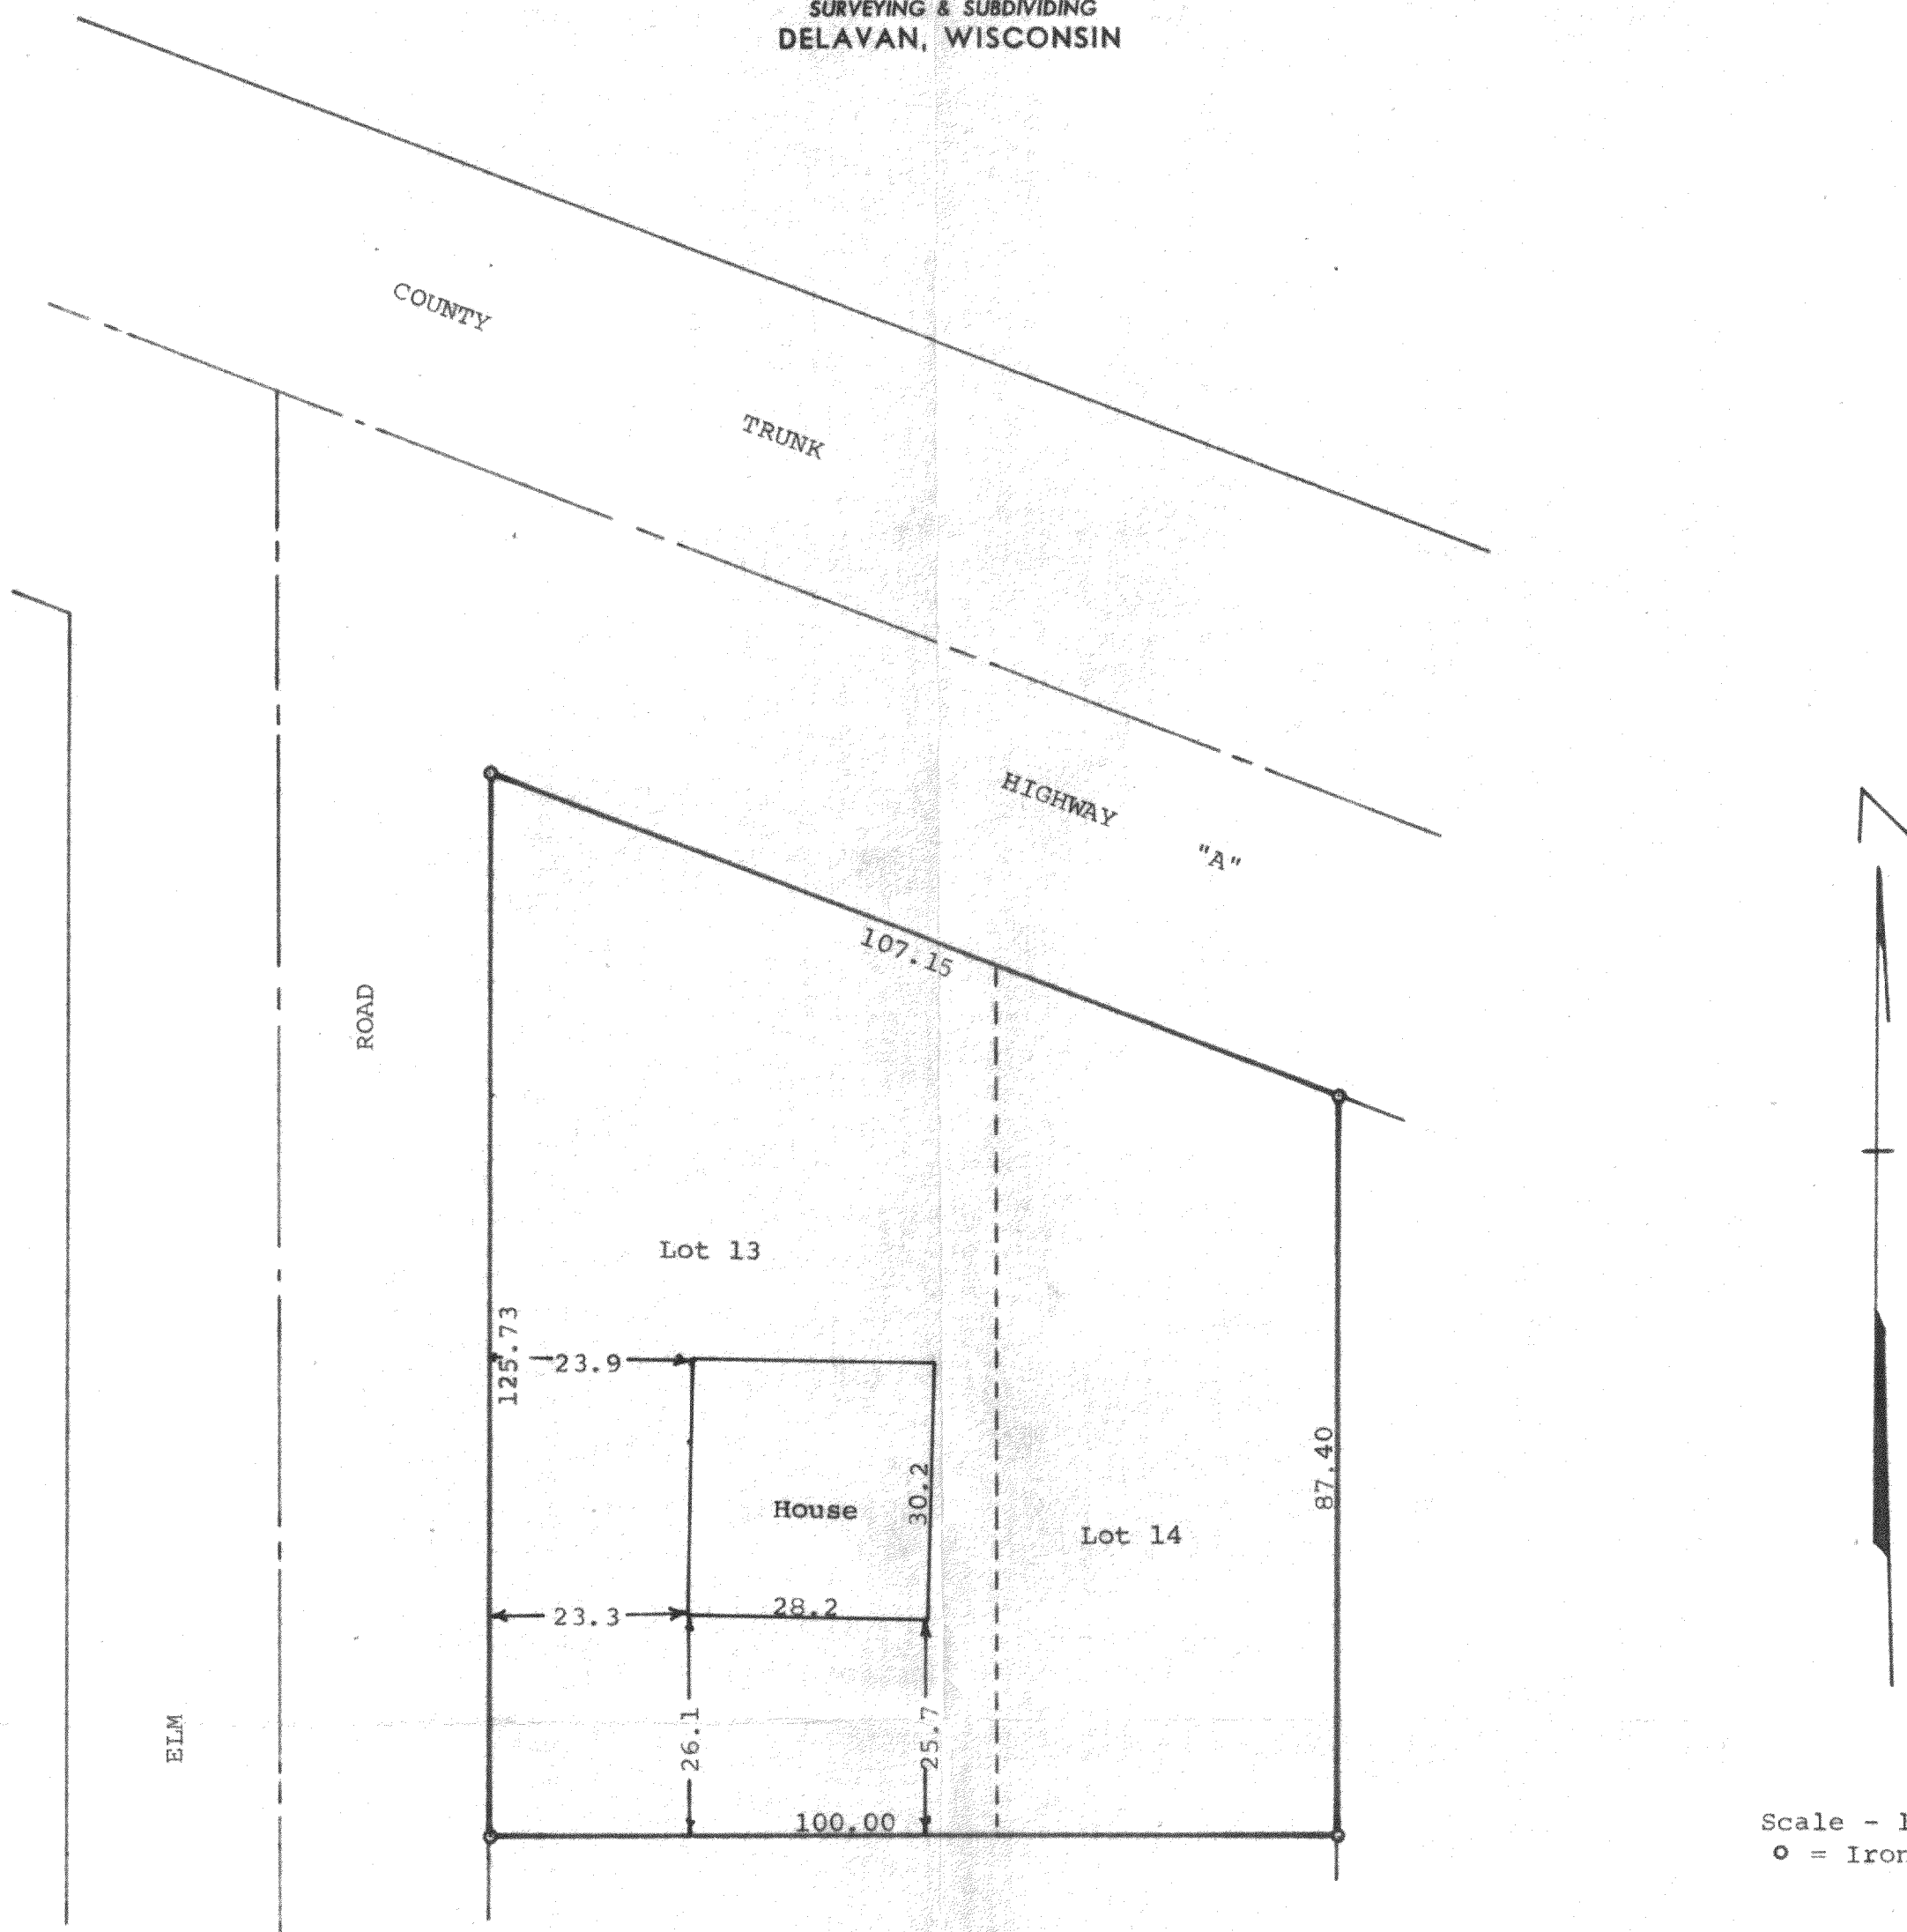

Plat of survey of Lots 13 and 14 in Block 6 of Interlaken,
a subdivision located in Section 11, T 3 N, R 16 E, Walworth
County, Wisconsin.
May 4, 1972

George T. Dunham
George T. Dunham, Surveyor

STATE OF WISCONSIN)
COUNTY OF WALWORTH) SS

I, George T. Dunham, Surveyor, certify that I have surveyed
the property described as follows,
Lots 13 & 14 in Block 6 of Interlaken, a subdivision located
in Section 11, T3N, R16E, Walworth County, Wisconsin.
and that the above plat is an accurate survey and a true representation
thereof and correctly shows the exterior boundary lines and location of
buildings on said property and the correct measurements thereof.
August 10, 1972.

George T. Dunham
George T. Dunham, Surveyor

