


Plat of Survey


of

Lots 7, 8, 9, & 10 of Block 26 of Interlaken 3rd Map, located in the East 1/2 of Section 11, Town 3 North, Range 16 East, Town of Sugar Creek, Walworth County, Wisconsin.



Surveyed for: **Sharpe Builders**
 W 5512 Barley Road
 Elkhorn, Wisconsin. 53121

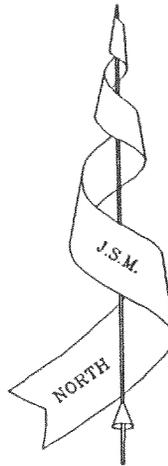

Bearings referenced to previous surveys.

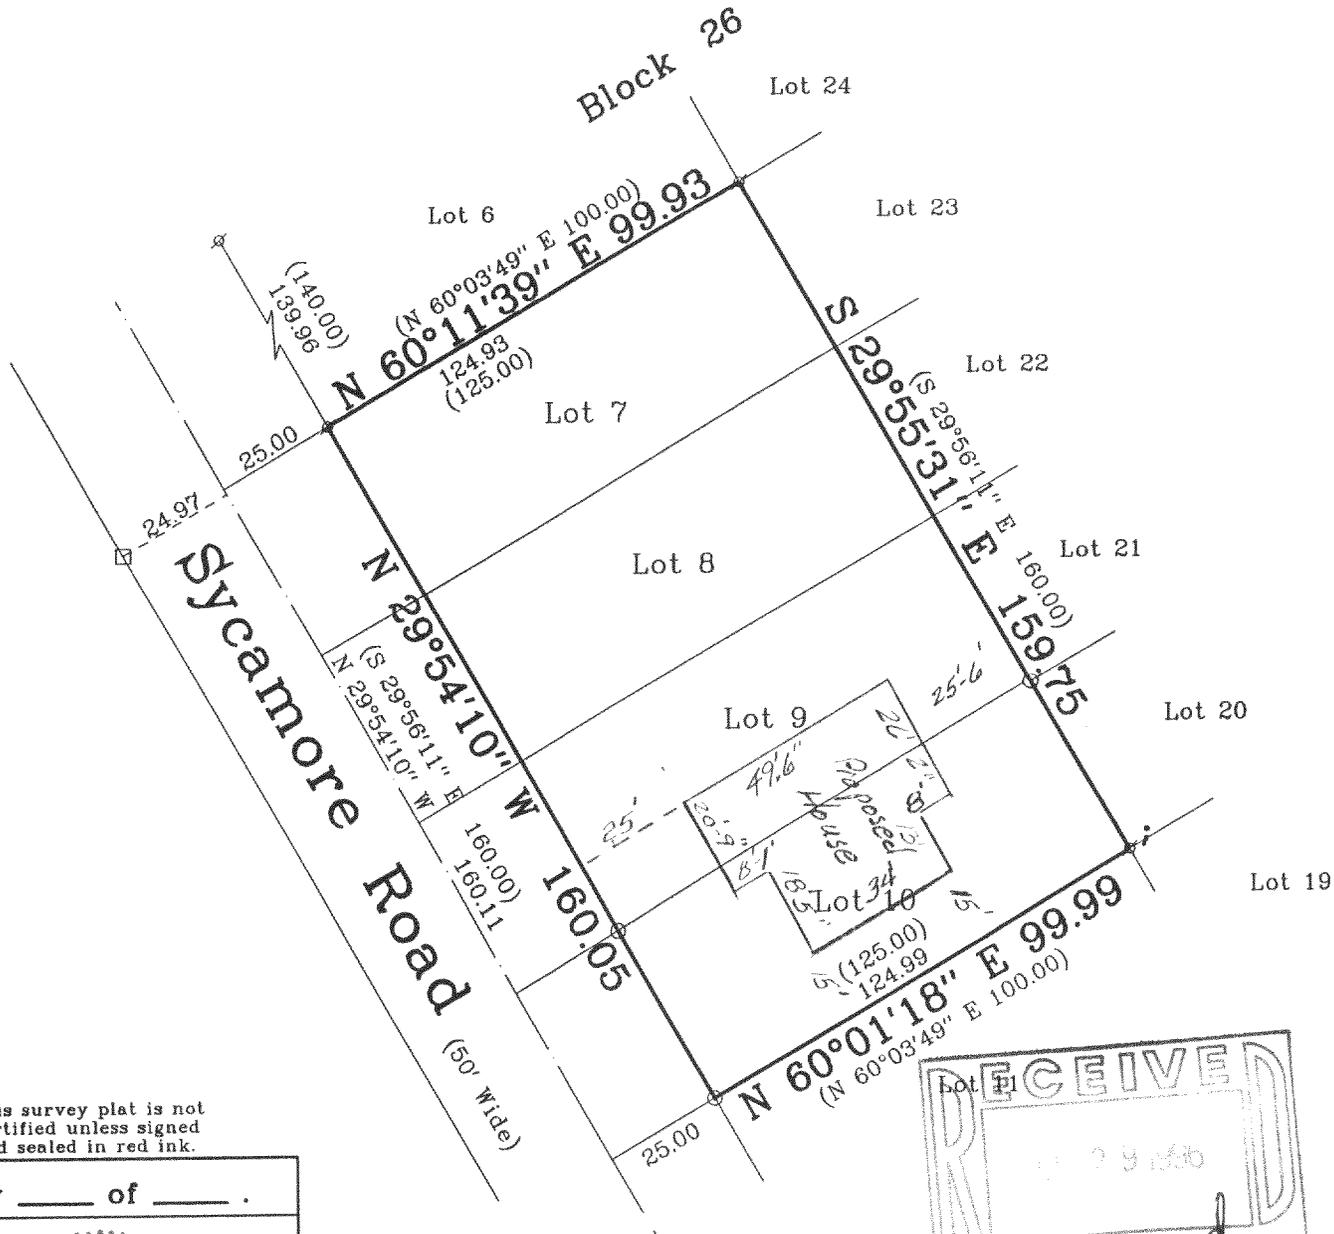

Note: This survey plat is not certified unless signed and sealed in red ink.

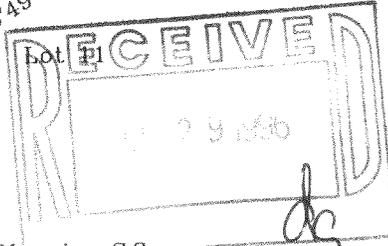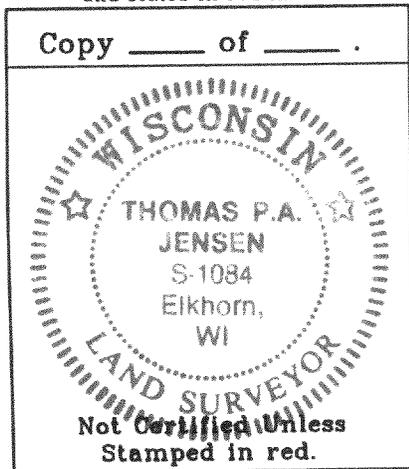

Copyright © 1995 by Jensen Surveying & Mapping S.C.

All rights reserved. No part of this survey plat may be reproduced or transmitted in any form by any means - graphic, electronic, or mechanical, including photocopying, tracing, or information storage and retrieval systems - without permission in writing from Thomas P.A. Jensen, Jensen Surveying & Mapping S.C..

I, Thomas P.A. Jensen, Wisconsin Registered Land Surveyor, do hereby certify that this survey was performed by me, or under my direction in full compliance with the owner's / agent's instructions and Chapter A-E 7 of the Wisconsin Administrative Code "Minimum Standards for Property Surveys"; and that this map is as accurate representation thereof to the best of my knowledge and belief.

Date: _____

Thomas P.A. Jensen
 Thomas P.A. Jensen R.L.S. 1084


Legend

- Found Concrete Monument
- Found Iron Pipe
- Set Iron Rod 3/4" dia.
- () Recorded Dimension

Jensen Surveying & Mapping S.C.

45 South Wisconsin Street P.O. Box 322
 Elkhorn, Wisconsin. 53121
 Telephone & Facsimile (414) 723-3434

Scale in feet: 1" = 40'

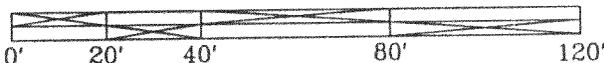

Mapping Date: 6-6-95
 Revisions: 8-28-95

Sheet 2 of 5 Sheets

Job Reference No.

1995.038


95038a

Plat of Survey

of

Lots 7, 8, 9, & 10 of Block 26 of Interlaken 3rd Map, located in the East 1/2 of Section 11, Town 3 North, Range 16 East, Town of Sugar Creek, Walworth County, Wisconsin.


Surveyed for: **Sharpe Builders**
 W 5512 Barley Road
 Elkhorn, Wisconsin. 53121

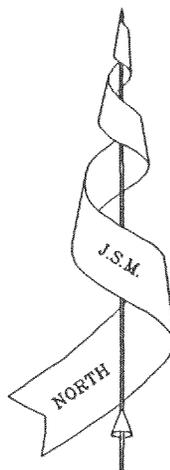



Bearings referenced to previous surveys.

Notes:

- Proposed house is shown as instructed by the contractor on 10-11-95. All setbacks must be approved by the Building Inspector.
- * This setback distance is to a foundation for a front stoop;

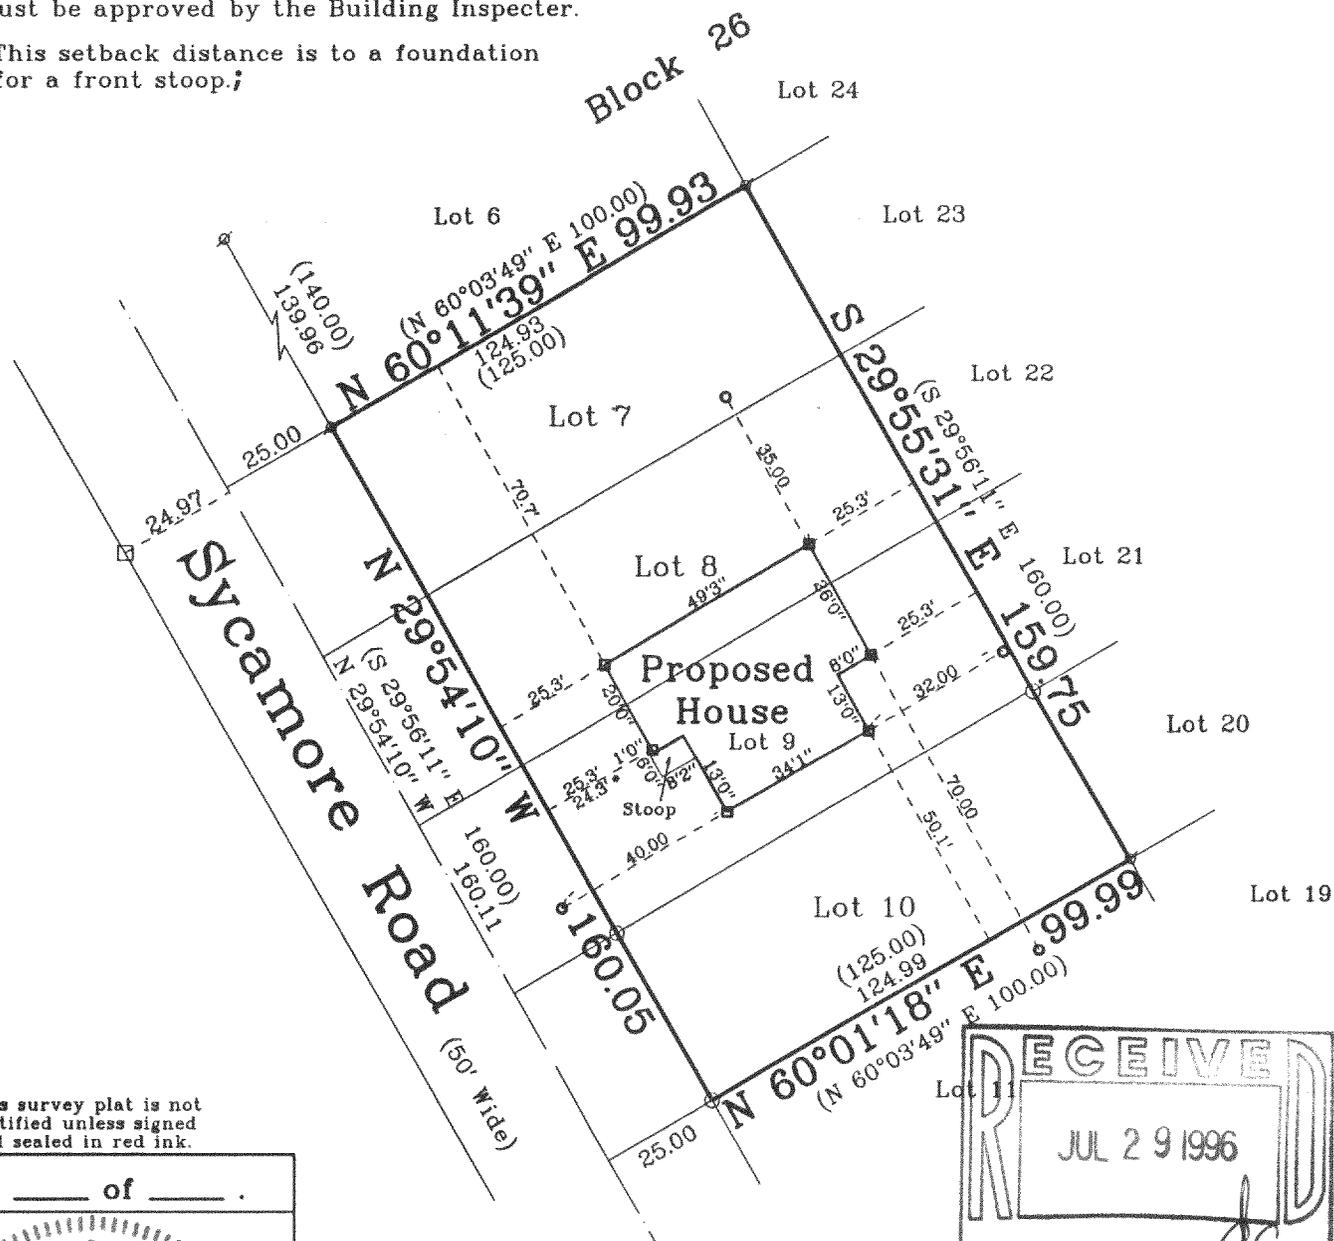

Note: This survey plat is not certified unless signed and sealed in red ink.

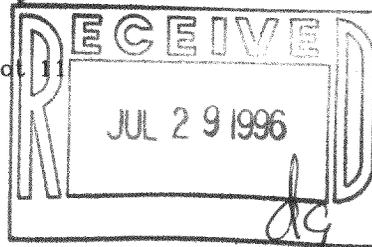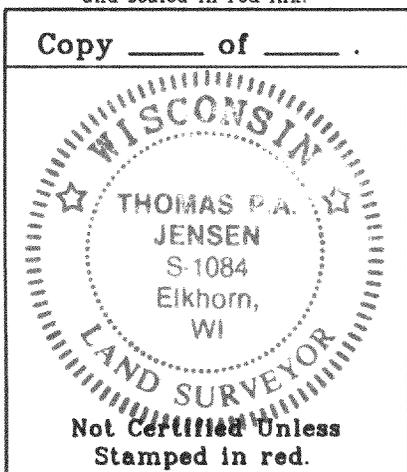

Copyright © 1995 by Jensen Surveying & Mapping S.C.

All rights reserved. No part of this survey plat may be reproduced or transmitted in any form by any means - graphic, electronic, or mechanical, including photocopying, tracing, or information storage and retrieval systems - without permission in writing from Thomas P.A. Jensen, Jensen Surveying & Mapping S.C.

I, Thomas P.A. Jensen, Wisconsin Registered Land Surveyor, do hereby certify that this survey was performed by me, or under my direction in full compliance with the owner's / agent's instructions and Chapter A-E 7 of the Wisconsin Administrative Code "Minimum Standards for Property Surveys"; and that this map is an accurate representation thereof to the best of my knowledge and belief.

Date: 10-11-95

Thomas P.A. Jensen
 Thomas P.A. Jensen R.L.S. 1084

Legend

- Found Concrete Monument
- ⊗ Found Iron Pipe
- Set Iron Rod 3/4" dia.
- () Recorded Dimension
- Set Wood Stake
- Set Iron Rod, 1/2" dia.

Jensen Surveying & Mapping S.C.

45 South Wisconsin Street P.O. Box 322
 Elkhorn, Wisconsin. 53121
 Telephone & Facsimile (414) 723-3434

Mapping Date: 10-11-95

Revisions:

Sheet 1 of 1 Sheets

Job Reference No.

1995.088

See 1995.038

Scale in feet: 1" = 40'



GI-268A

GI-268B

316-852