


PLAT OF SURVEY

LOTS 15 THRU 17 INCLUSIVE OF
BLOCK 3 OF LAKE WANDAWEGA
HIGHLANDS SUBDIVISION LOCATED IN
SECTIONS 11 AND 12, TOWN 3 NORTH,
RANGE 16 EAST, TOWN OF SUGAR
CREEK, WALWORTH COUNTY, WISCONSIN.

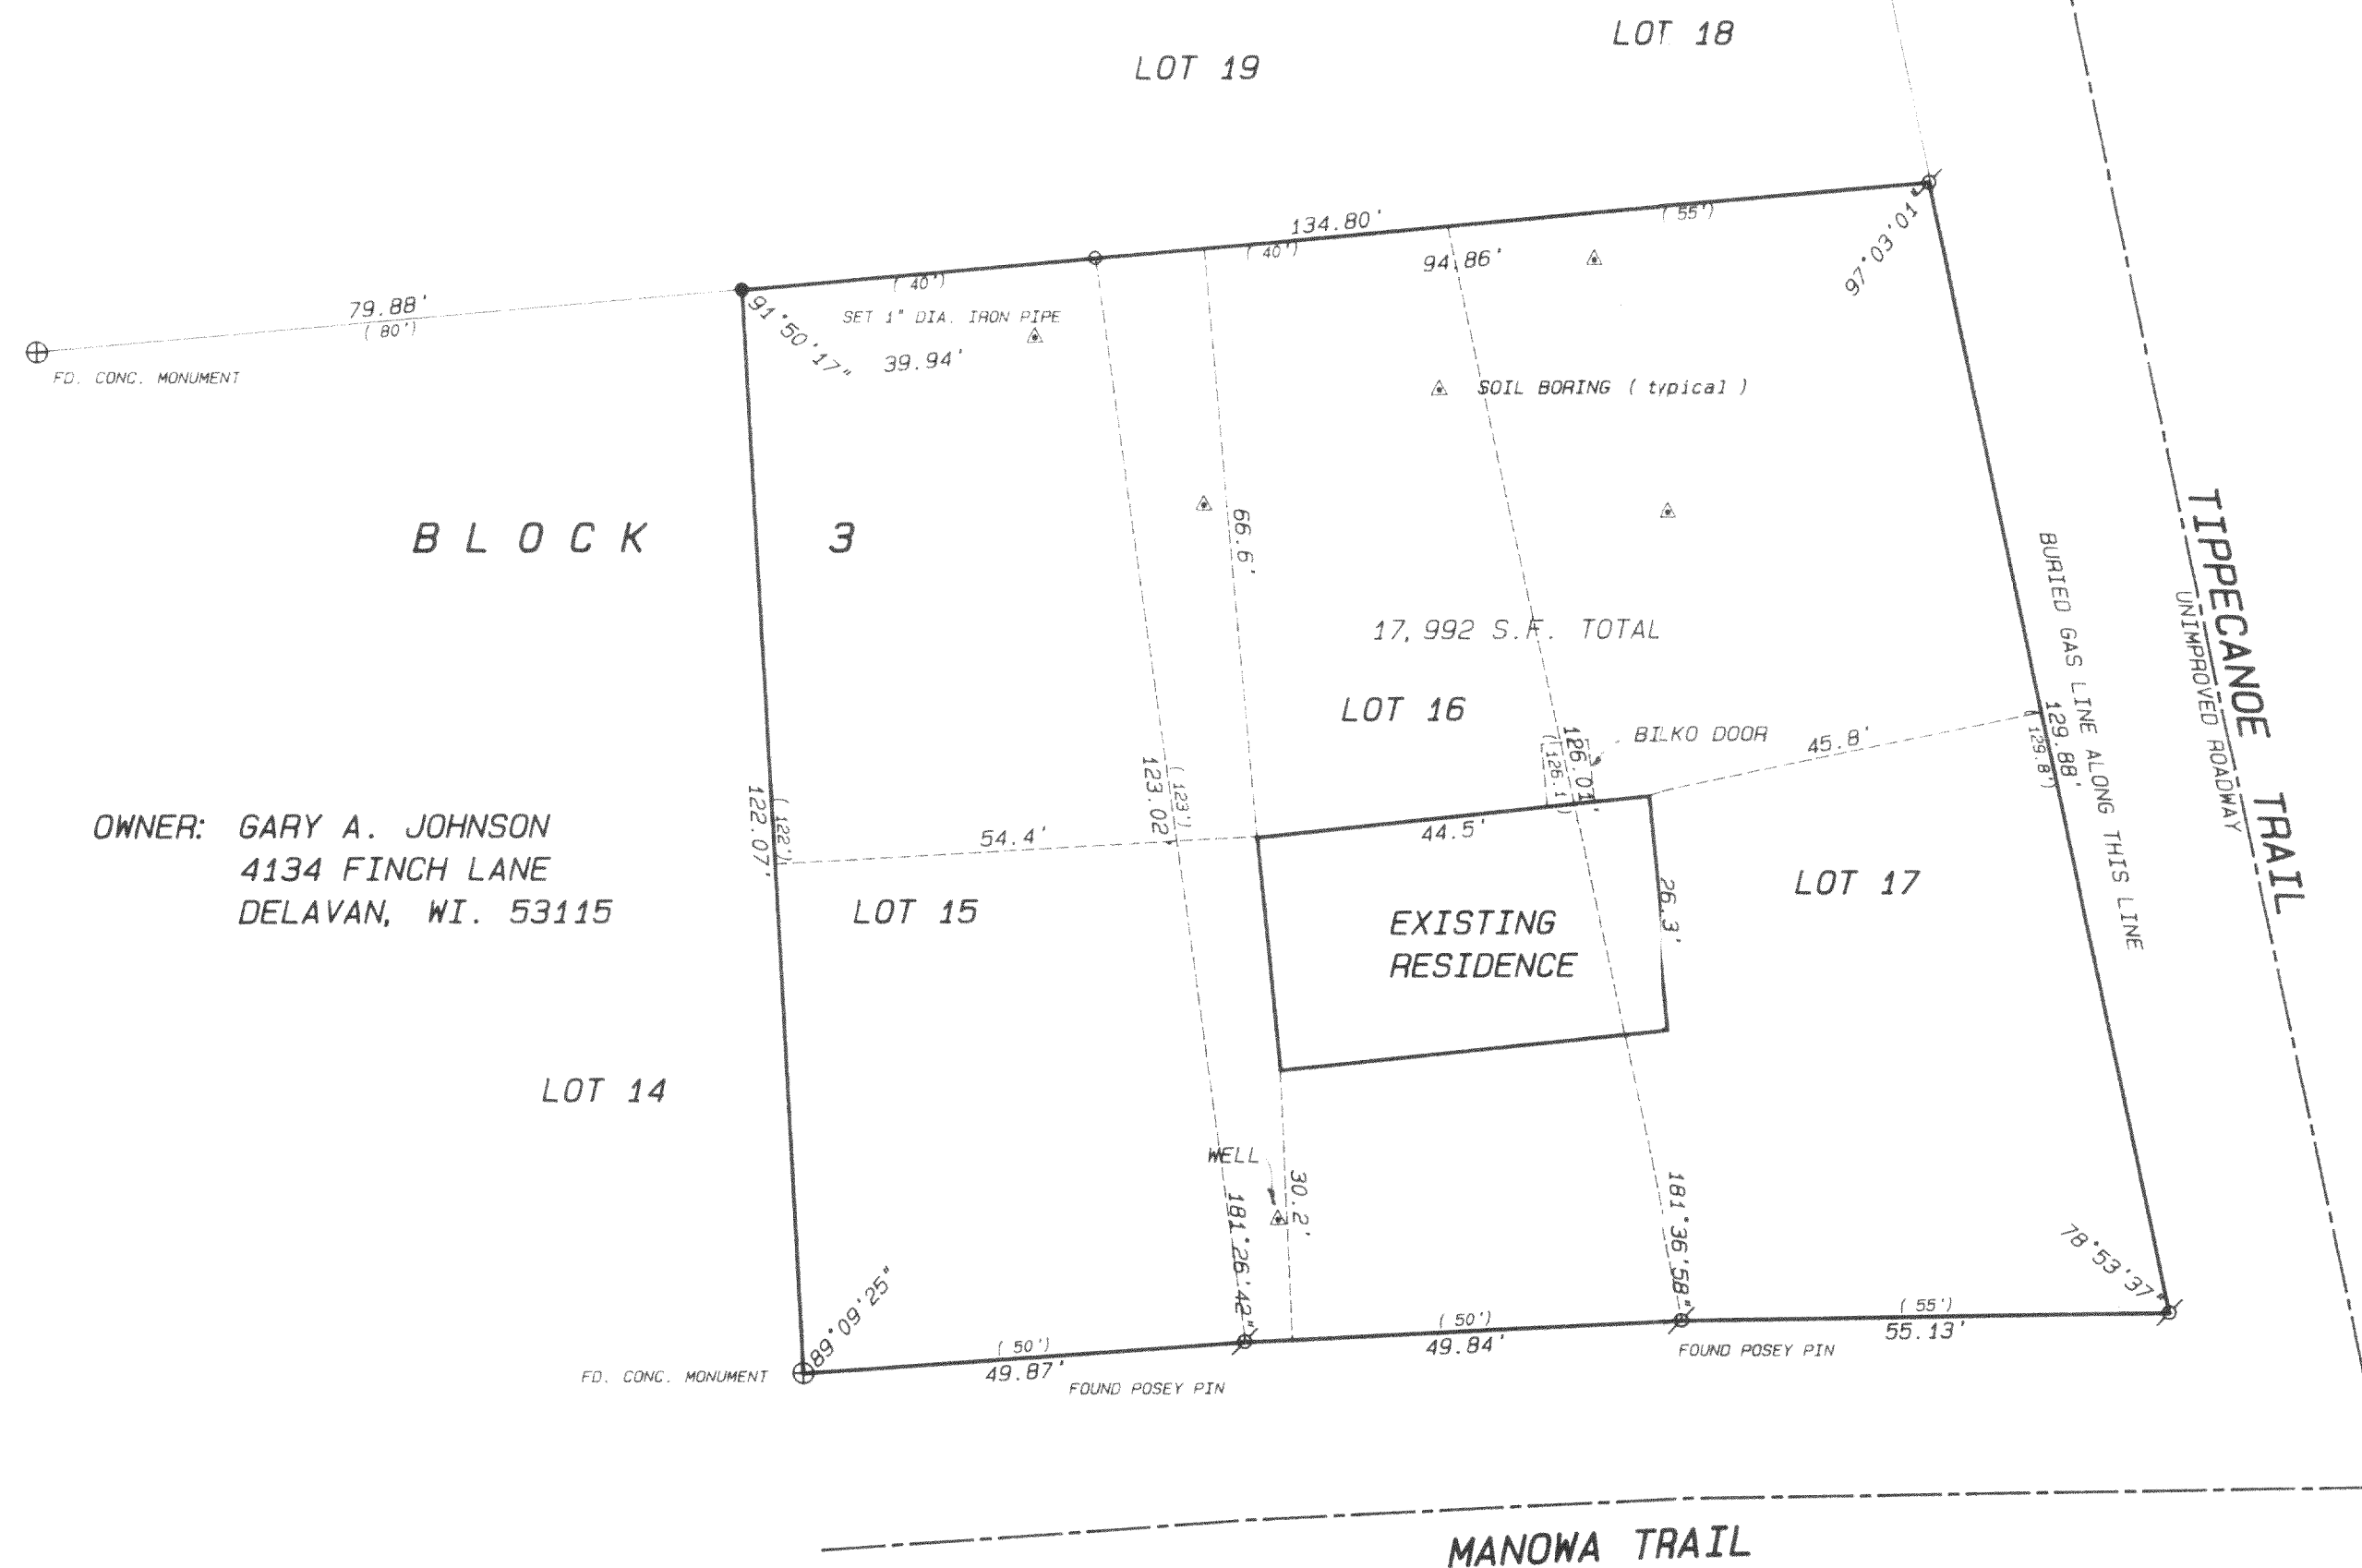

OWNER: GARY A. JOHNSON
4134 FINCH LANE
DELAVAN, WI. 53115

SCALE 1" = 20 FEET

Legend

- FOUND IRON PIPE
 - FOUND IRON ROD
 - FOUND BRASS CAPPED MONUMENT
 - FOUND CONCRETE MONUMENT
 - + CHISEL CUT IN CONCRETE
 - SET IRON ROD, 74" LONG, WEIGHING
1.5 LBS LINEAL FT., 3/4" DIA.
 - SET IRON ROD, 30" LONG, WEIGHING
4/5 LBS LINEAL FT., 1 1/16" DIA.
- (XX) RECORDED AS DIMENSION
- X -- X --
EXISTENCE FENCE

SCALE: 1" = 20 FEET

"I hereby certify that the above described property has been surveyed by me or under my direction, and that the above map is a true representation thereof and shows the size and location of the property, its exterior boundaries, the location of all visible structures and dimensions of all principal buildings thereon, boundary fences, apparent easements, roadways and visible encroachments.

"I reserve the right for the use of the present owners of the property and also those who purchase, mortgage, or guarantee the title thereto within one year from date hereof."

KENNETH B. ABERNATHY, JR.
WISCONSIN REGISTERED LAND SURVEYOR,
S-1594

Date: Dec. 15, 1995 Job No. 94.1212

REVISED 12/15/95
AS BUILT RESIDENCE LOCATED

REVISED 9/19/95
ADDED LOT 15 AND PROPOSED RESIDENCE

CWH-41
CWH-42
CWH-43
316-866