


#16-64

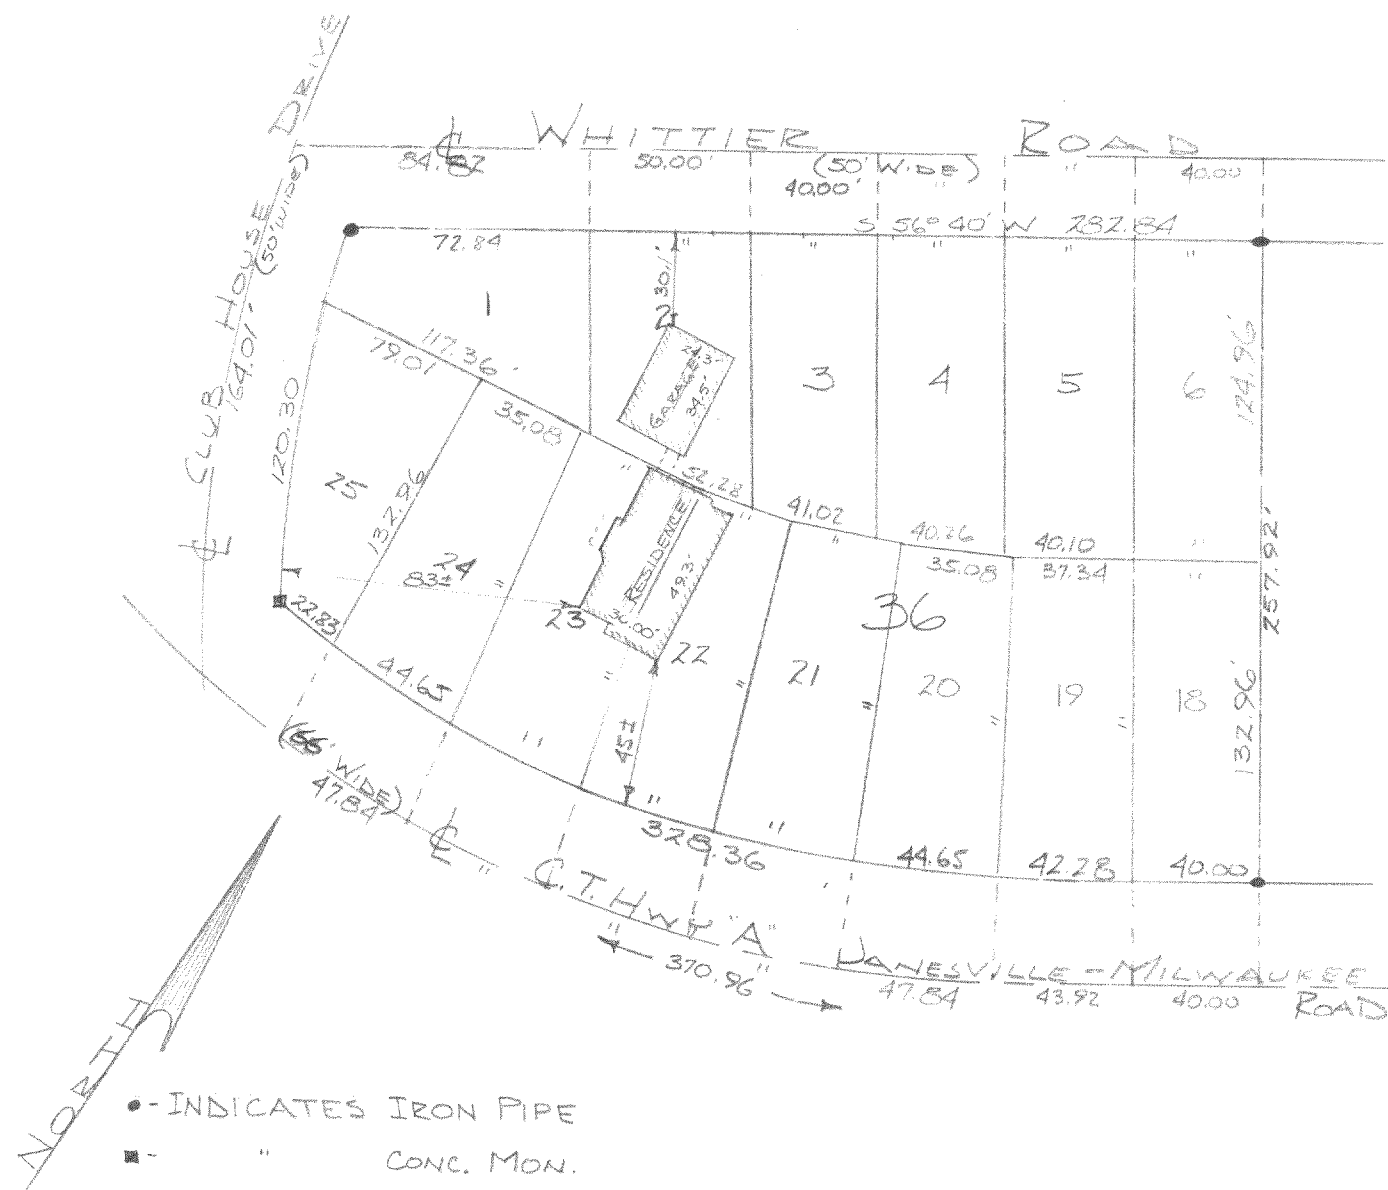

- - INDICATES IRON PIPE
- - " CONC. MON.

DESCRIPTION: Lots 1, 2, 3, 4, 5, 6, 18, 19, 20, 21, 22, 23, 24, and 25 of Block 36 of the 3rd. Map of Interlaken Subdivision, located in Section 11 of T. 3 N., R. 16 E. Walworth County Wisconsin.

CERTIFICATE: I, James F. Biagi, surveyor, do hereby certify that I have surveyed the property hereon described and that the location of the improvements are as shown.

Feb. 11, 1964.

*James F. Biagi*  
James F. Biagi RLS 272

61-318.321A, 321B

316-89B