


ABELL  
SURVEYING & MAPPING  
DELANAV, WISCONSIN 53115  
414-728-6737



SCALE 1" = 30'

LEGEND

- - IRON PIPE FOUND
- - CONCRETE MONUMENT FOUND
- - IRON PIPE SET
- × - WIRE FENCE
- ×× - WOOD FENCE
- △ - UTILITY POLE
- — — - OVERHEAD UTILITY LINES
- - - - UTILITY PED.
- — — - GUY WIRE
- CS - CONCRETE STOOP
- ( ) - RECORDED AS

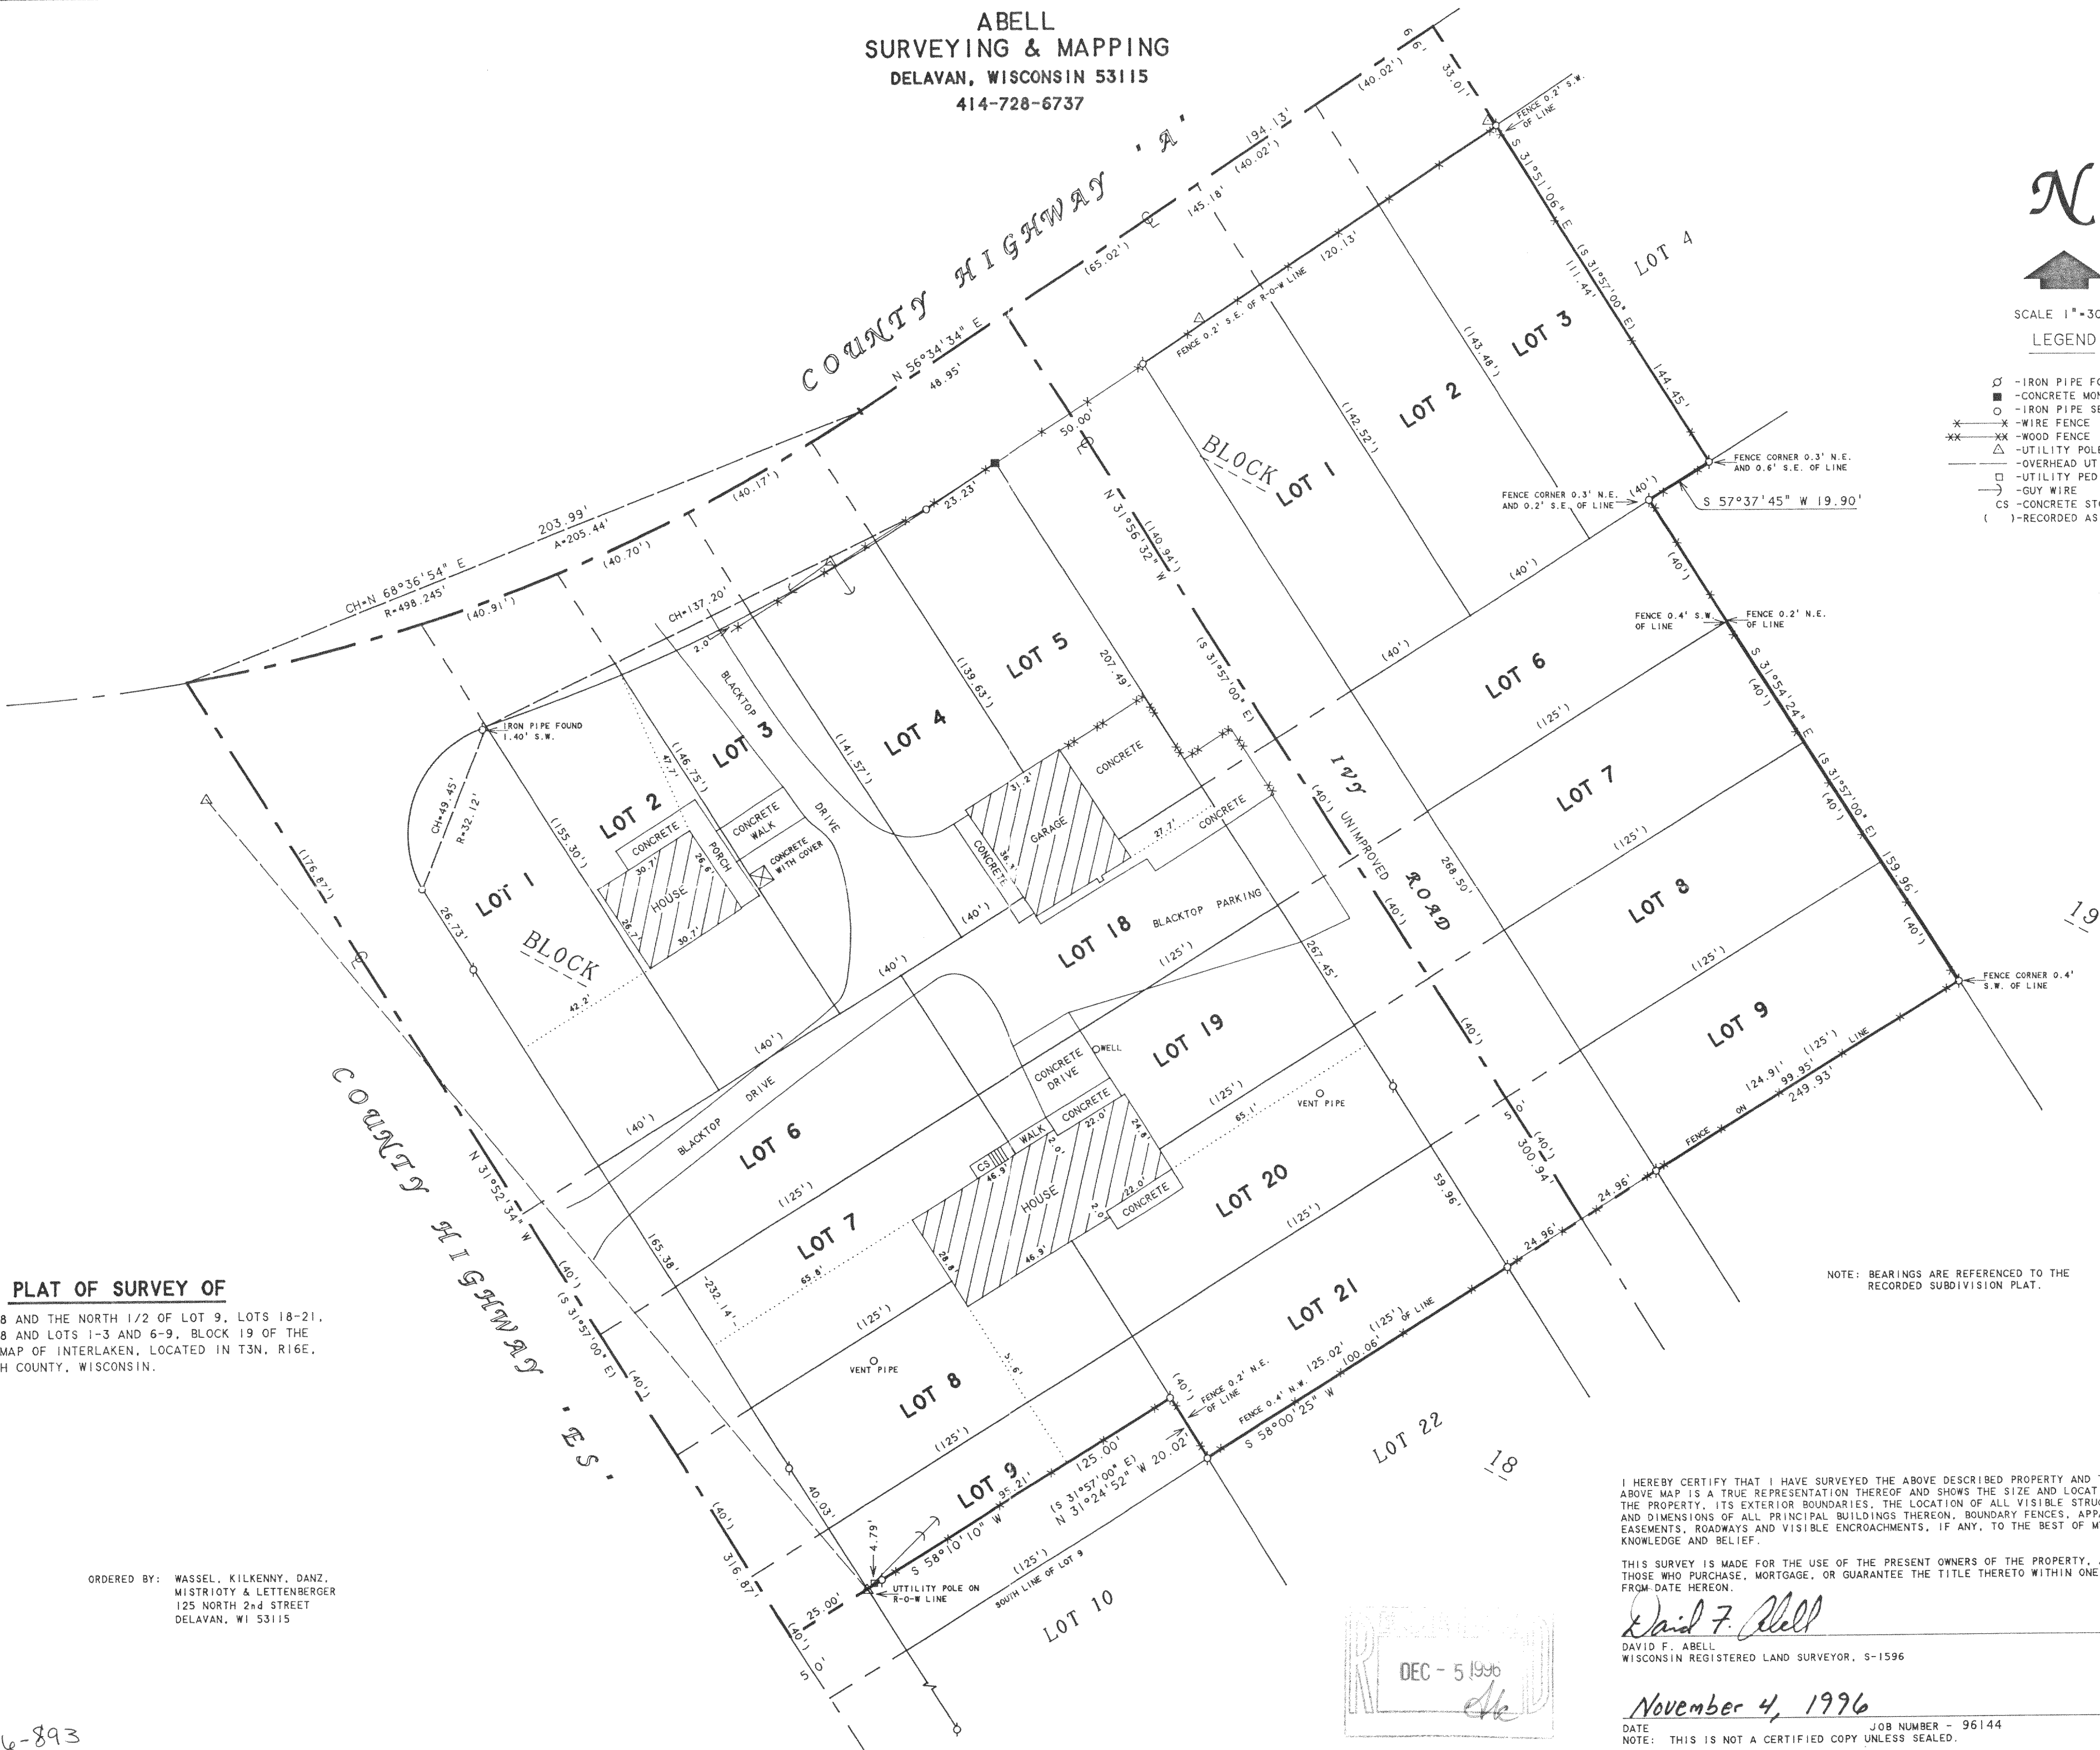

PLAT OF SURVEY OF

LOTS 1-8 AND THE NORTH 1/2 OF LOT 9, LOTS 18-21,  
BLOCK 18 AND LOTS 1-3 AND 6-9, BLOCK 19 OF THE  
SECOND MAP OF INTERLAKEN, LOCATED IN T3N, R16E,  
WALWORTH COUNTY, WISCONSIN.

ORDERED BY: WASSEL, KILKENNY, DANZ,  
MISTRIOTY & LETTENBERGER  
125 NORTH 2nd STREET  
DELANAV, WI 53115


NOTE: BEARINGS ARE REFERENCED TO THE  
RECORDED SUBDIVISION PLAT.

I HEREBY CERTIFY THAT I HAVE SURVEYED THE ABOVE DESCRIBED PROPERTY AND THAT THE ABOVE MAP IS A TRUE REPRESENTATION THEREOF AND SHOWS THE SIZE AND LOCATION OF THE PROPERTY, ITS EXTERIOR BOUNDARIES, THE LOCATION OF ALL VISIBLE STRUCTURES AND DIMENSIONS OF ALL PRINCIPAL BUILDINGS THEREON, BOUNDARY FENCES, APPARENT EASEMENTS, ROADWAYS AND VISIBLE ENCROACHMENTS, IF ANY, TO THE BEST OF MY KNOWLEDGE AND BELIEF.

THIS SURVEY IS MADE FOR THE USE OF THE PRESENT OWNERS OF THE PROPERTY, AND ALSO THOSE WHO PURCHASE, MORTGAGE, OR GUARANTEE THE TITLE THERETO WITHIN ONE (1) YEAR FROM DATE HEREON.

*David F. Abell*  
DAVID F. ABELL  
WISCONSIN REGISTERED LAND SURVEYOR, S-1596

November 4, 1996  
DATE JOB NUMBER - 96144  
NOTE: THIS IS NOT A CERTIFIED COPY UNLESS SEALED.

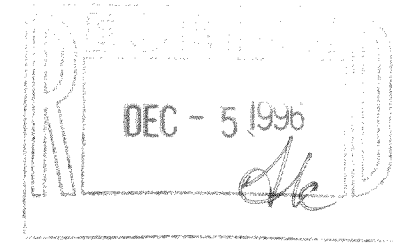

GI-240  
GI-241  
GI-242  
GI-249 316-893  
GI-251  
GI-252