
PLAT OF SURVEY

LOT 83 OF BAYWOOD ESTATES (3rd ADDITION)

LOCATED IN THE NE 1/4 OF THE NW 1/4 OF SECTION 1, TOWN 3 NORTH, RANGE 16 EAST, WALWORTH COUNTY, WISCONSIN

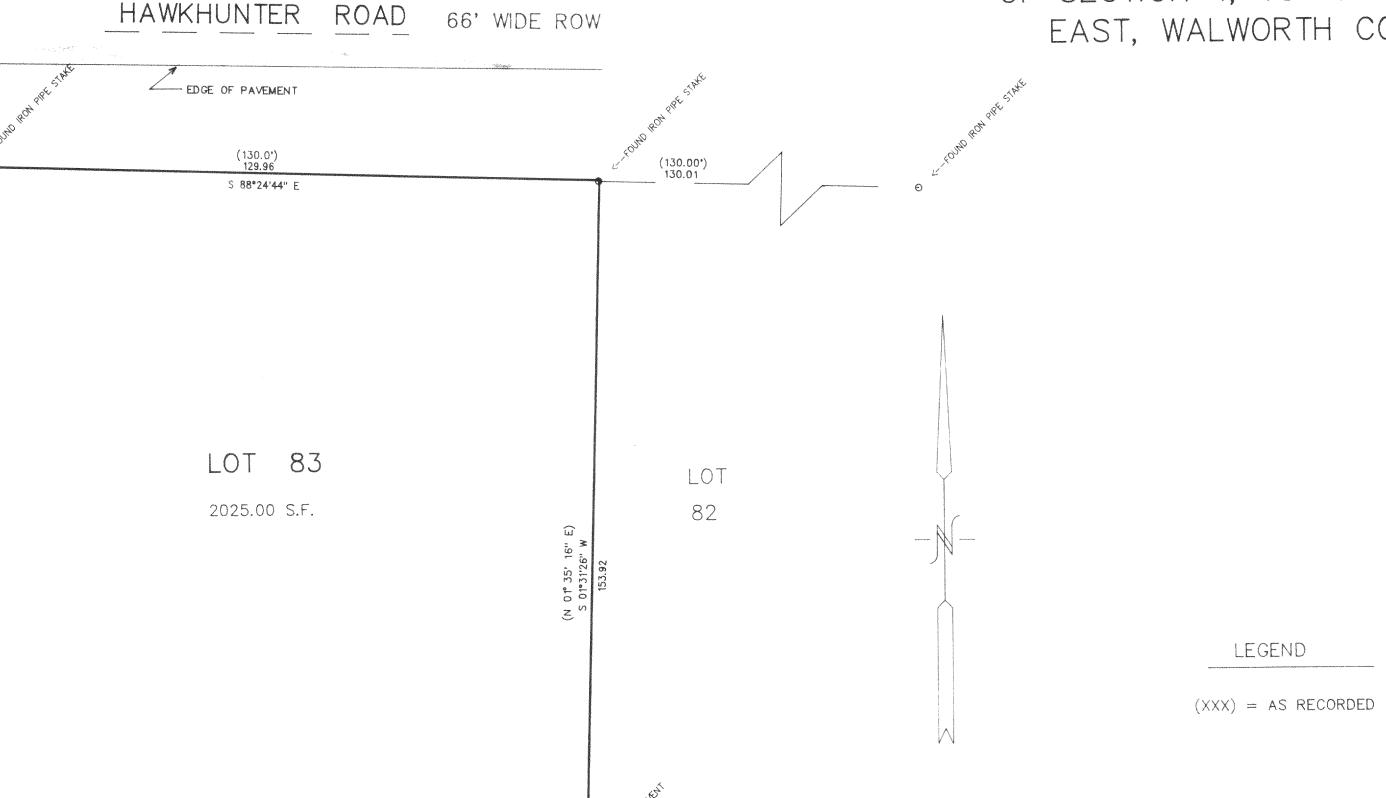

EDGE OF PAVEMENT

(S 88° 24' 44" E)

MAP SCALE IN FEET ORIGINAL 1" = 20'


N 88°27'40" W 130.13 (130.0°)


HAWKHUNTER

NOTE: COPIES OF THIS MAP TO WHICH THE FOLLOWING CERTIFICATE WILL APPLY ARE BLUE LINE PRINTS SHOWING SURVEYOR'S ORIGINAL SEAL AND SIGNATURE IN BLACK INK. COPIES BY ANY OTHER MEANS MAY HAVE ALTERATIONS WHICH DO NOT REPRESENT THE SURVEYOR'S WORK PRODUCT.

I HEREBY CERTIFY THAT THE ABOVE DESCRIBED PROPERTY HAS BEEN SURVEYED UNDER MY DIRECTION AND THAT THE ABOVE MAP IS A TRUE REPRESENTATION THEREOF AND SHOWS THE SIZE AND LOCATION OF THE PROPERTY AND ITS EXTERIOR BOUNDARIES. THIS SURVEY IS MADE FOR THE USE OF THE PRESENT OWNERS OF THE PROPERTY, AND ALSO THOSE WHO PURCHASE, MORTGAGE, OR GUARANTEE THE TITLE THERETO WITHIN ONE YEAR FROM THE DATE HEREOF.

DATED: _12/09/96

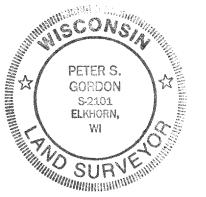

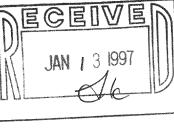

12/09/96 SHEET NO. 1 OF 1

4662 DATE:

LOT