


FARRIS, HANSEN & ASSOCIATES, INC.

ENGINEERING, ARCHITECTURE, SURVEYING
 7 RIDGEWAY COURT - P.O. BOX 437, ELKHORN, WISCONSIN, 53121
 PHONE: (414) 723-2098 FAX: (414) 723-5886



PLAT OF SURVEY

THE NW'LY 1/2 OF LOT 4
 LOTS 5, 6, 7, 8
 THE SE'LY 1/2 OF LOT 9
 OF BLOCK 50 OF THE FOURTH
 MAP OF INTERLAKEN

TOWN 3 NORTH, RANGE 16 EAST
 WALWORTH COUNTY, WISCONSIN

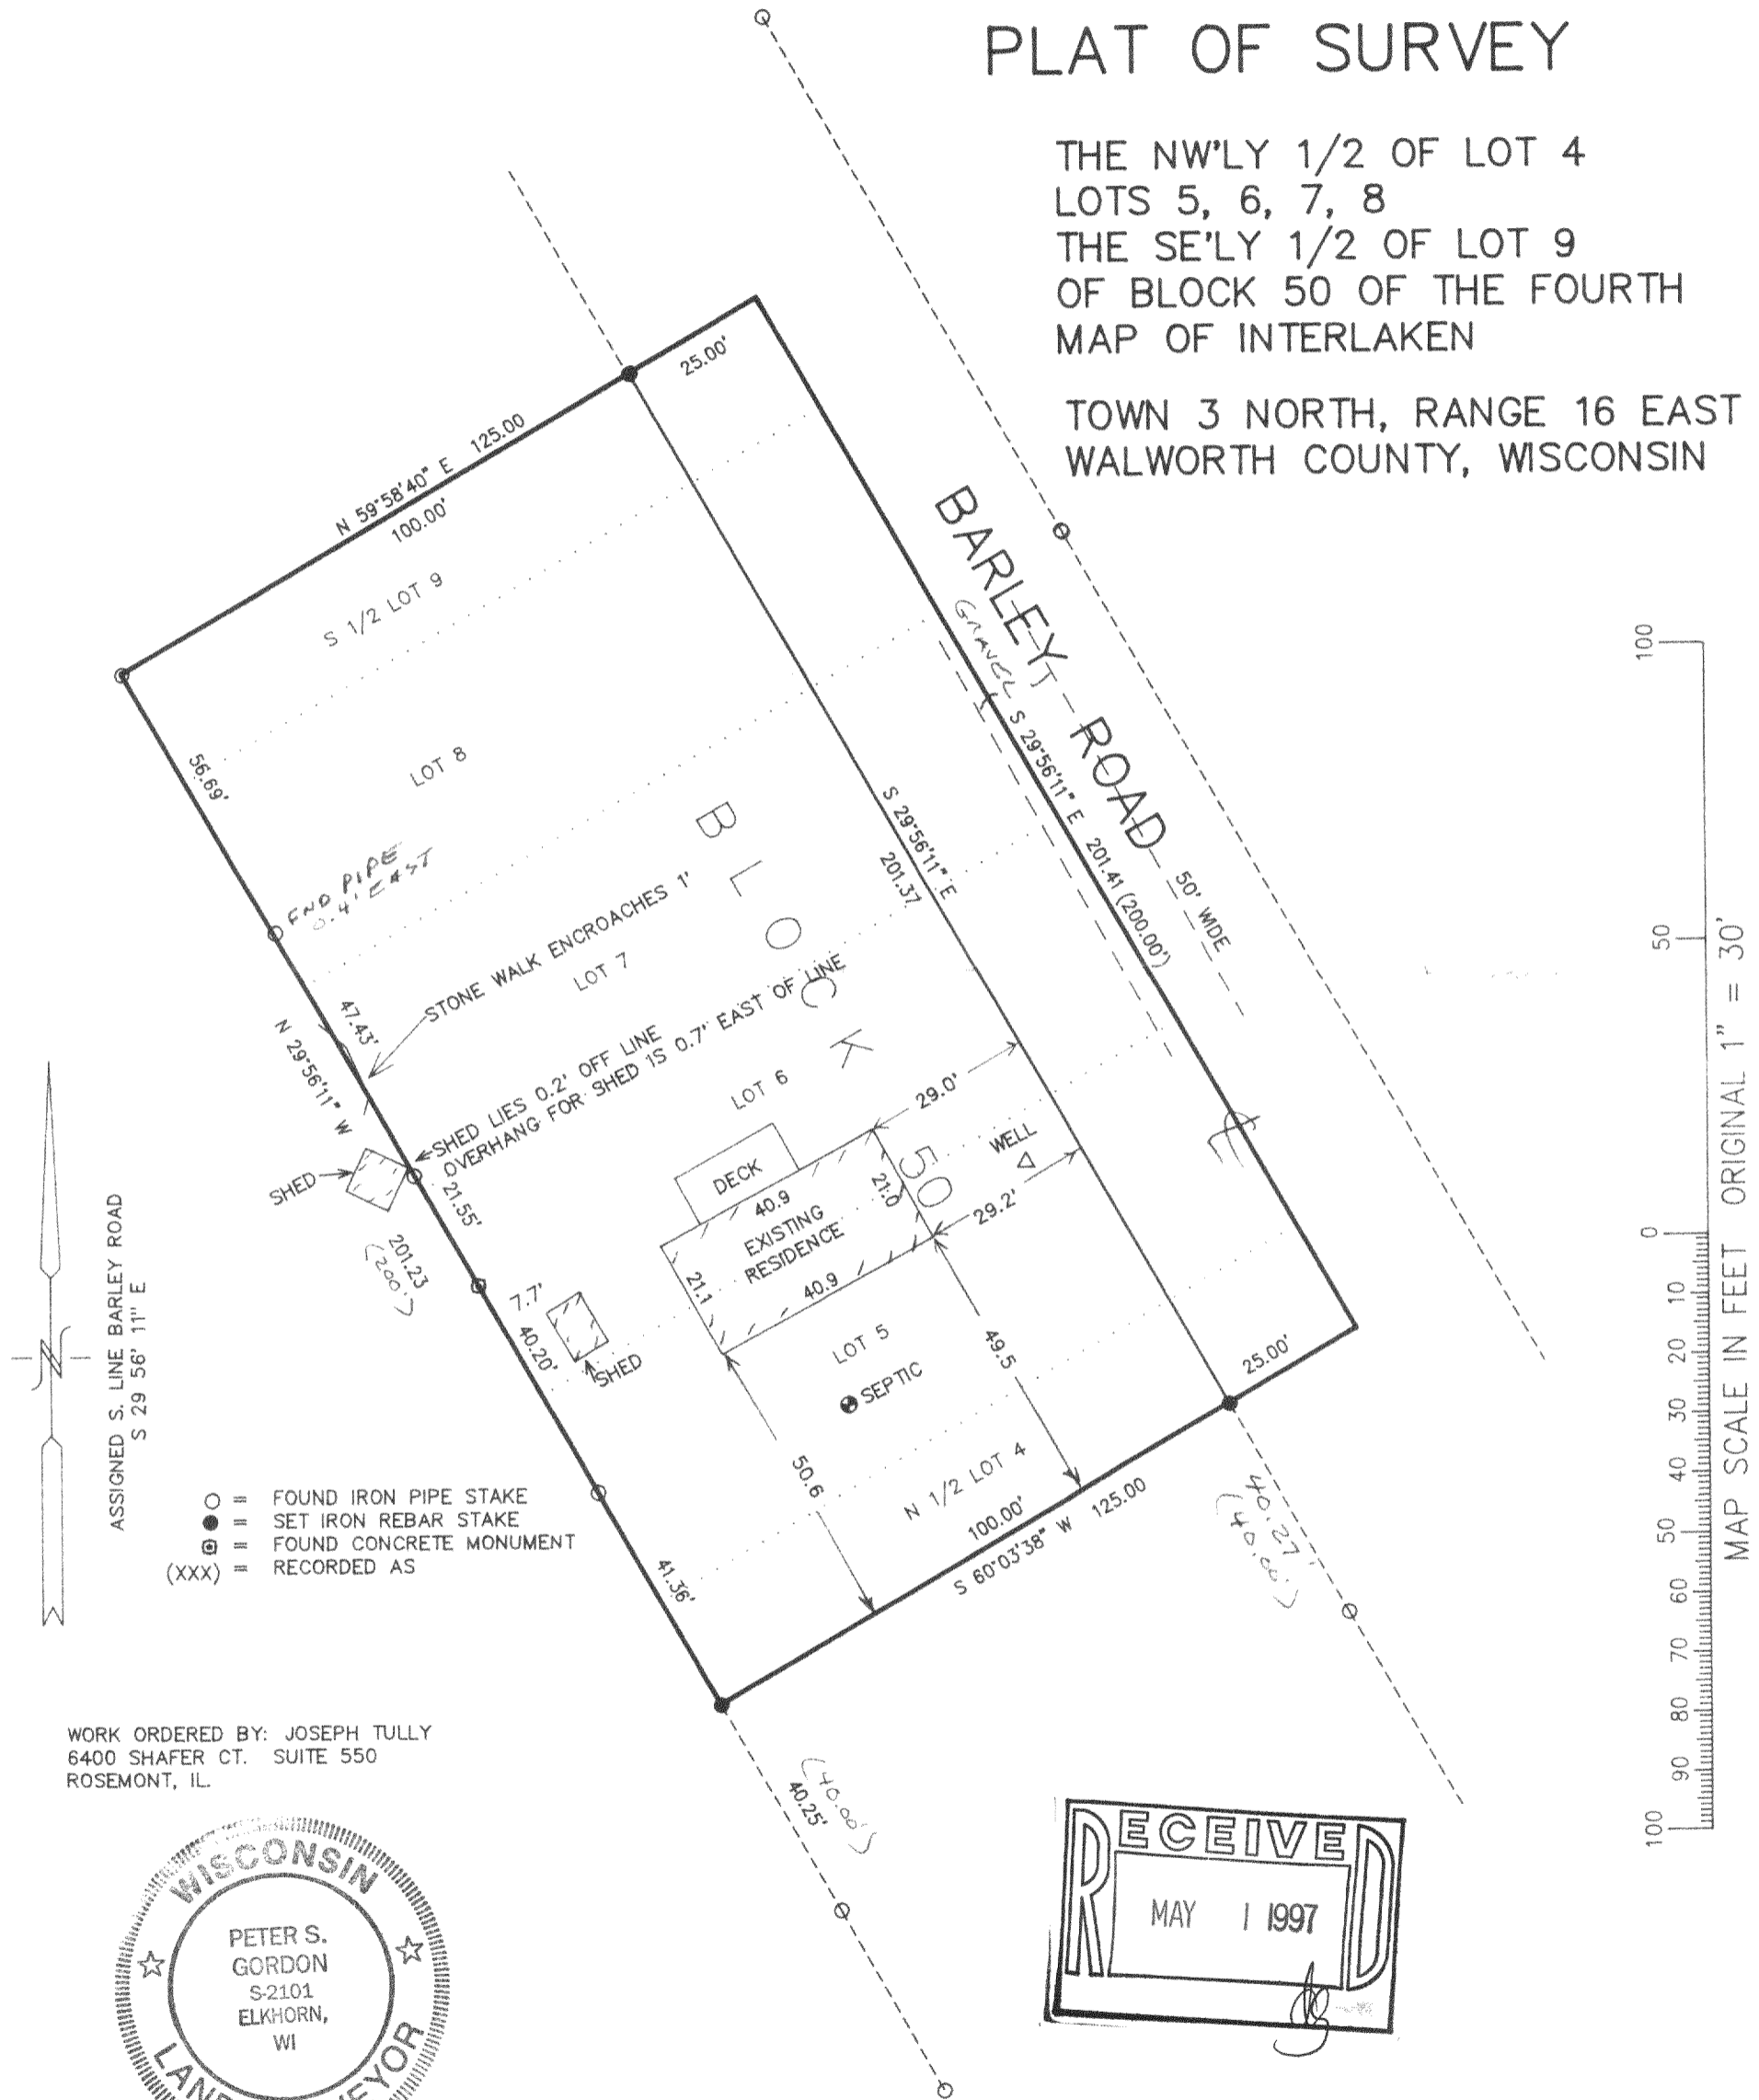

WORK ORDERED BY: JOSEPH TULLY
 6400 SHAFER CT. SUITE 550
 ROSEMONT, IL

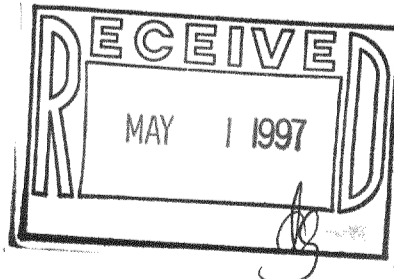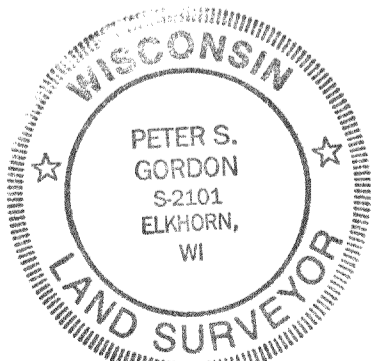

NOTE: COPIES OF THIS MAP TO WHICH THE FOLLOWING CERTIFICATE WILL APPLY ARE BLUE LINE PRINTS SHOWING SURVEYOR'S ORIGINAL SEAL AND SIGNATURE IN BLACK INK. COPIES BY ANY OTHER MEANS MAY HAVE ALTERATIONS WHICH DO NOT REPRESENT THE SURVEYOR'S WORK PRODUCT.

I HEREBY CERTIFY THAT THE ABOVE DESCRIBED PROPERTY HAS BEEN SURVEYED UNDER MY DIRECTION AND THAT THE ABOVE MAP IS A TRUE REPRESENTATION THEREOF AND SHOWS THE SIZE AND LOCATION OF THE PROPERTY AND ITS EXTERIOR BOUNDARIES. THIS SURVEY IS MADE FOR THE USE OF THE PRESENT OWNERS OF THE PROPERTY, AND ALSO THOSE WHO PURCHASE, MORTGAGE, OR GUARANTEE THE TITLE THERETO WITHIN ONE YEAR FROM THE DATE HEREOF.

DATED: 4-15-97

Peter S. Gordon
 PETER S. GORDON R.L.S. 2101

GI-452
 GI-454
 GI-455

PROJECT 4738

SHEET 1 OF 1

316-930